
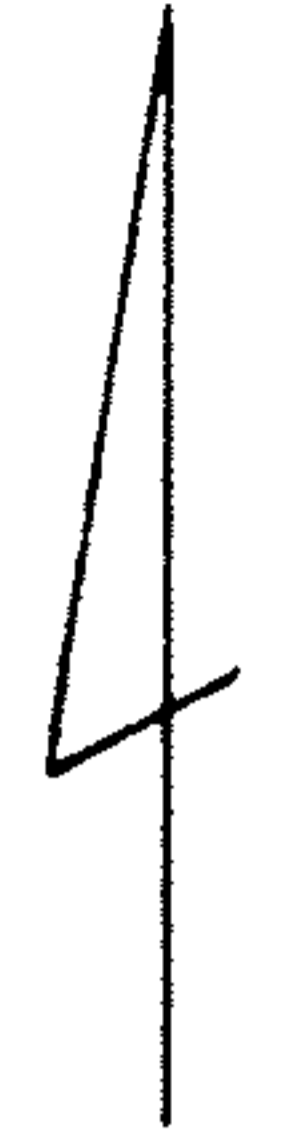


Parcel 2 ← Parcel 1

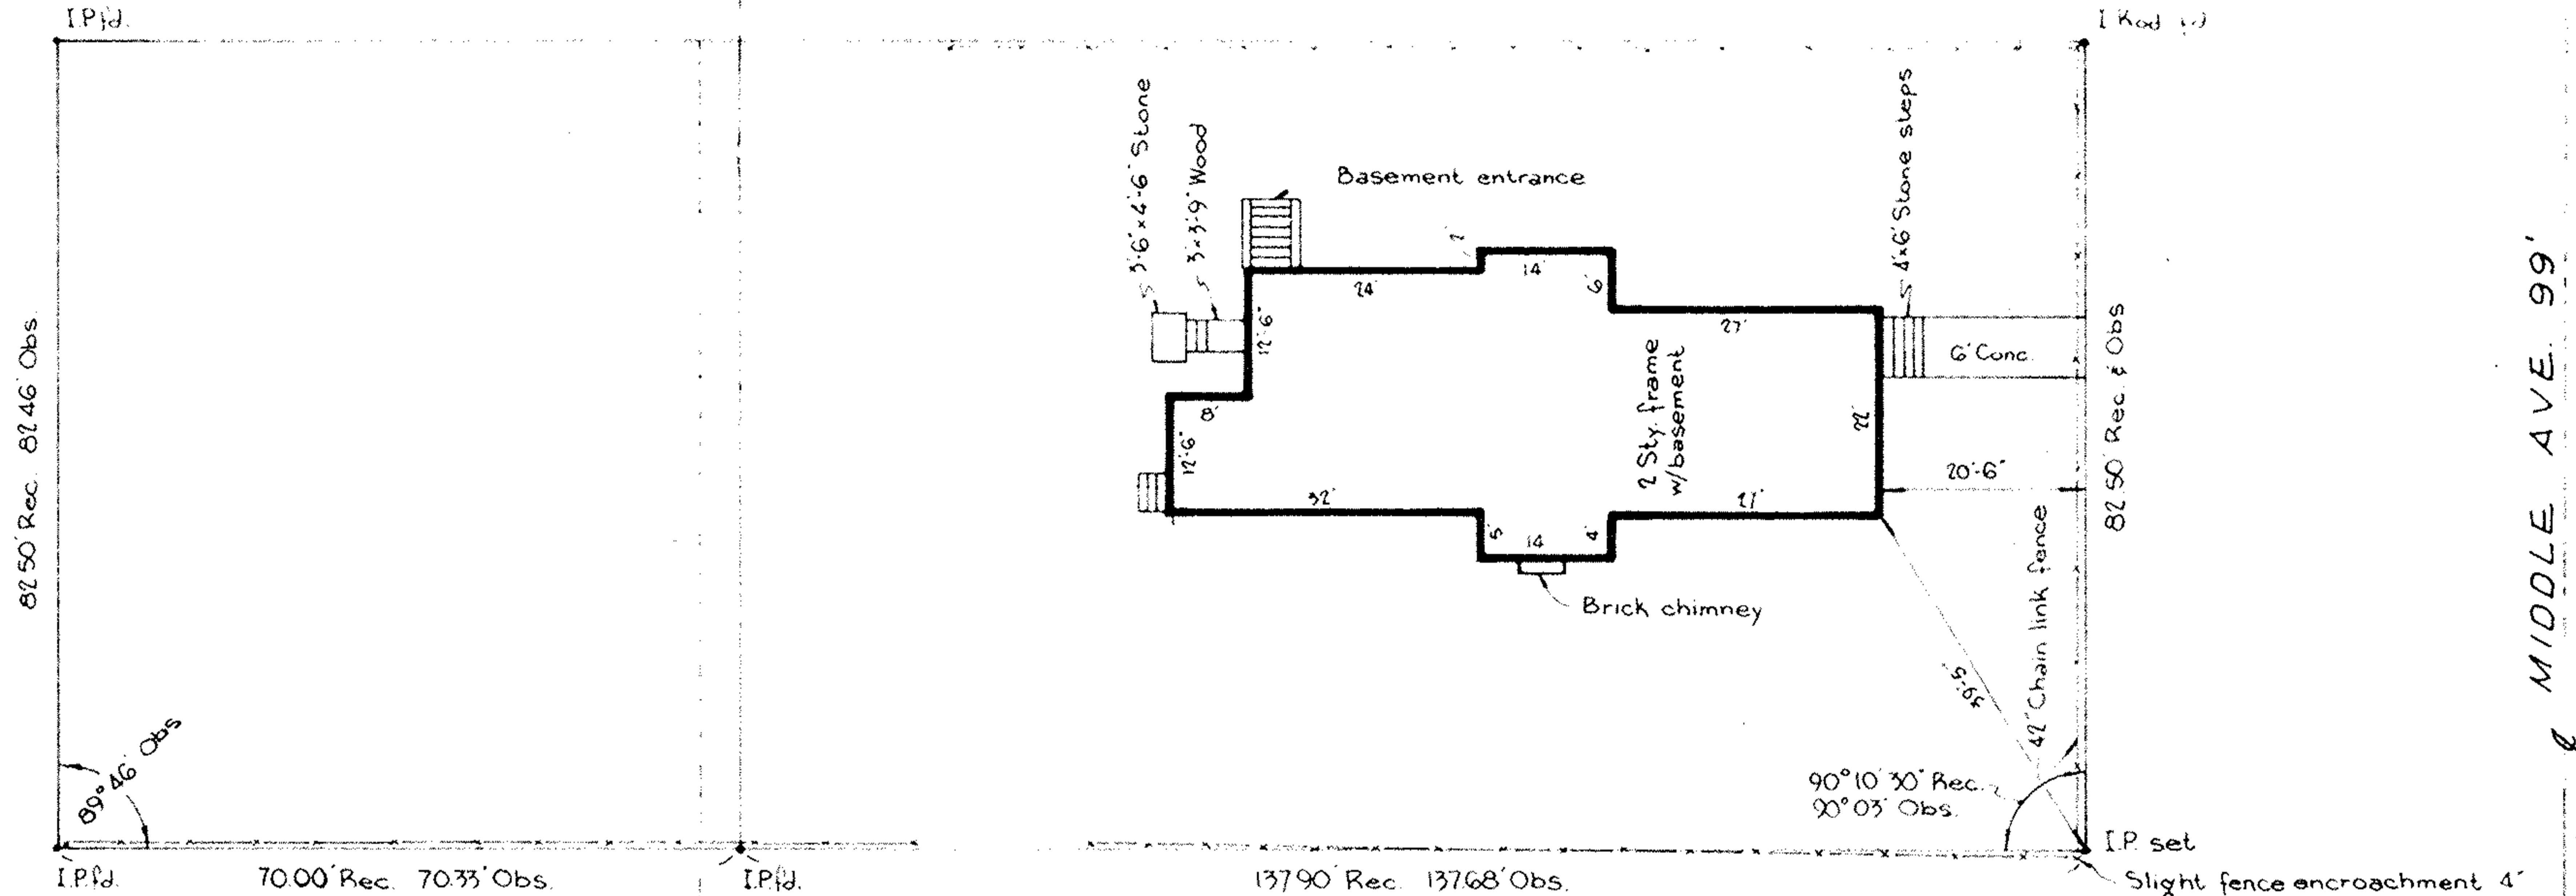

1" = 20'

Part of
 SUBLOT 11 ← SUBLOT 12
 ELY & MUSSEY'S ADDIT.
 PLAT VOL. 2, PG. 9

137.68
 70.33
 208.01

32
 14
 27
 20-6
 93-6

708.01
 93-6
 114.6"

PREPARED FOR
 LANDIG & WYKOFF ARCHITECTS
 LORAIN CTY BANK BLDG.
 ELYRIA, OHIO

PROPERTY PLAN & BUILDING LOCATION
 of
 J. FERRY NURSING HOME
 #1015 MIDDLE AVE.
 ELYRIA, OHIO

by
 MC GLINCHY & ASSOCIATES
 FEB. 10, 1976 # 76729