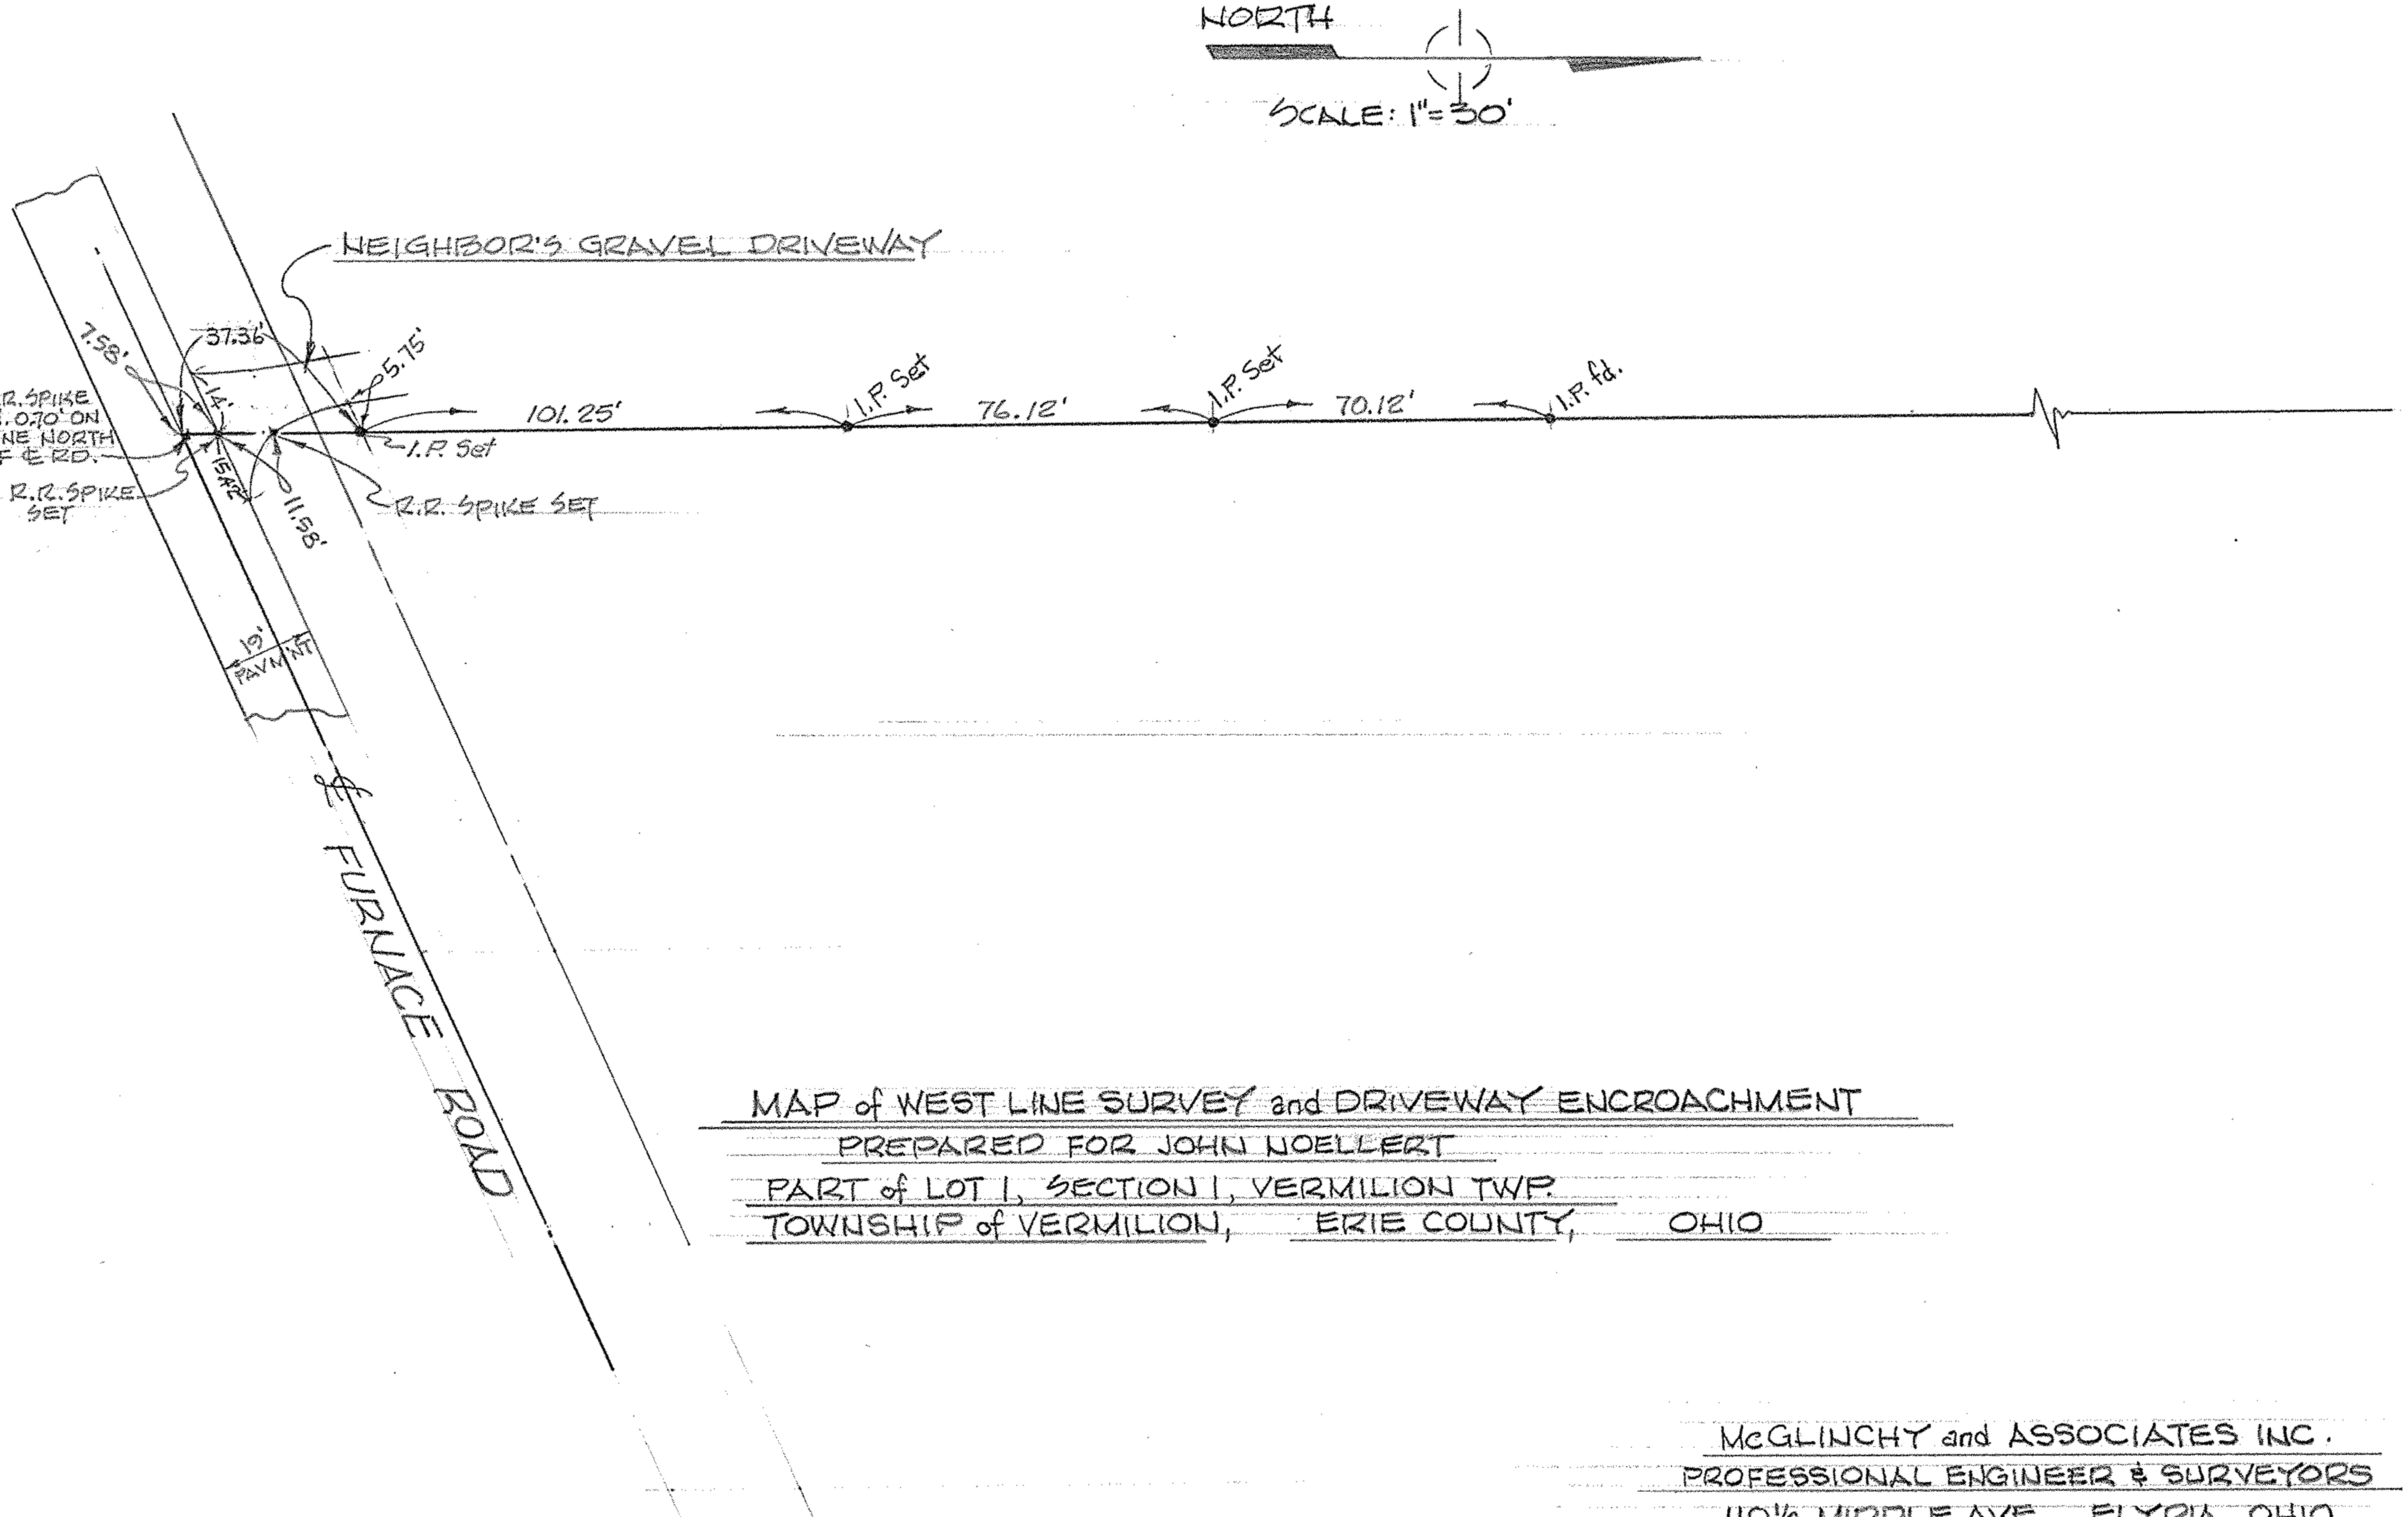

MAP of WEST LINE SURVEY and DRIVEWAY ENCROACHMENT
PREPARED FOR JOHN NOELLERT
PART of LOT 1, SECTION 1, VERMILION TWP.
TOWNSHIP of VERMILION, ERIE COUNTY, OHIO

McGLINCHY and ASSOCIATES INC.
PROFESSIONAL ENGINEER & SURVEYORS
110½ MIDDLE AVE. ELYRIA, OHIO
AUGUST, 1980 # 75212-A