


FERNDALE AVE. - 60'

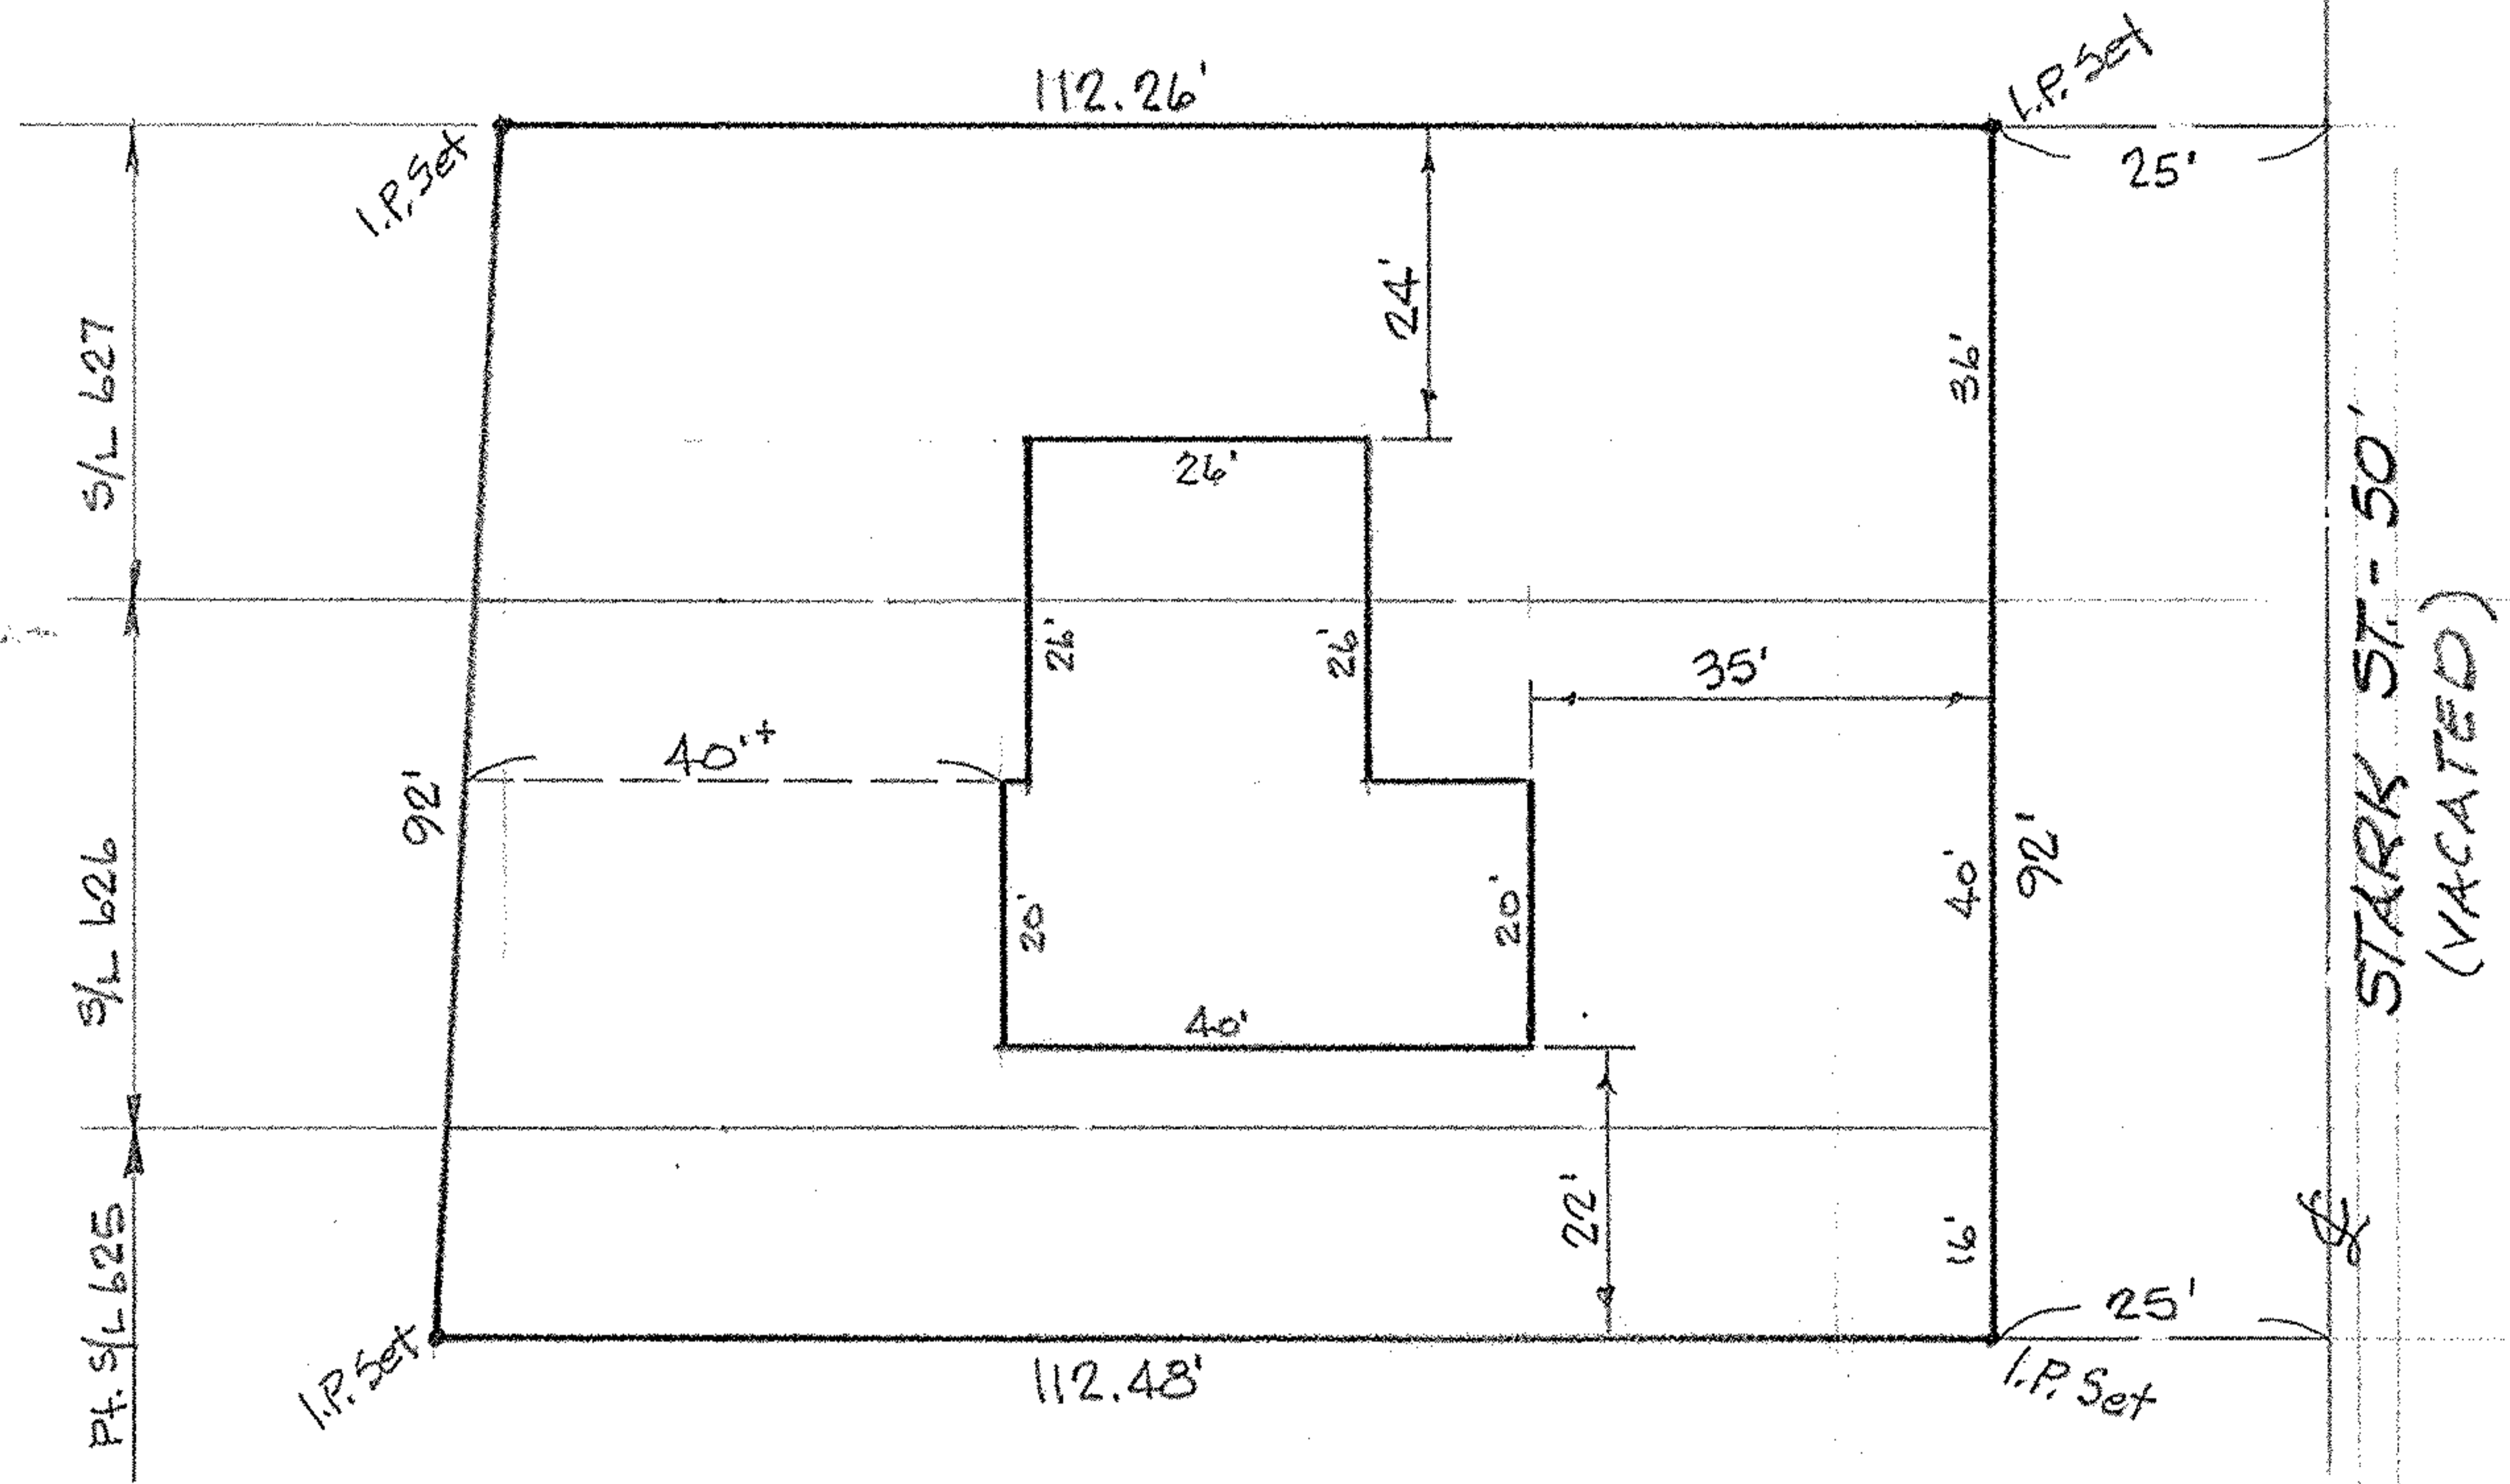

SCALE: 1"=20'

PLOT PLAN

PART of SUBLOT 625 & ALL of SUBLOTS 626 & 627 in
 LAKE BREEZE ALLOTMENT - PLAT Vol. 10, Pg. 21
 PART of ORIGINAL SHEFFIELD TWP. LOT No. 42
 CITY of SHEFFIELD LAKE, LORAIN Co., OHIO

McGUNCHY and ASSOCIATES INC
 PROFESSIONAL ENGINEER & SURVEYORS
 ELTRIA OHIO
 MAY, 1979 #795306