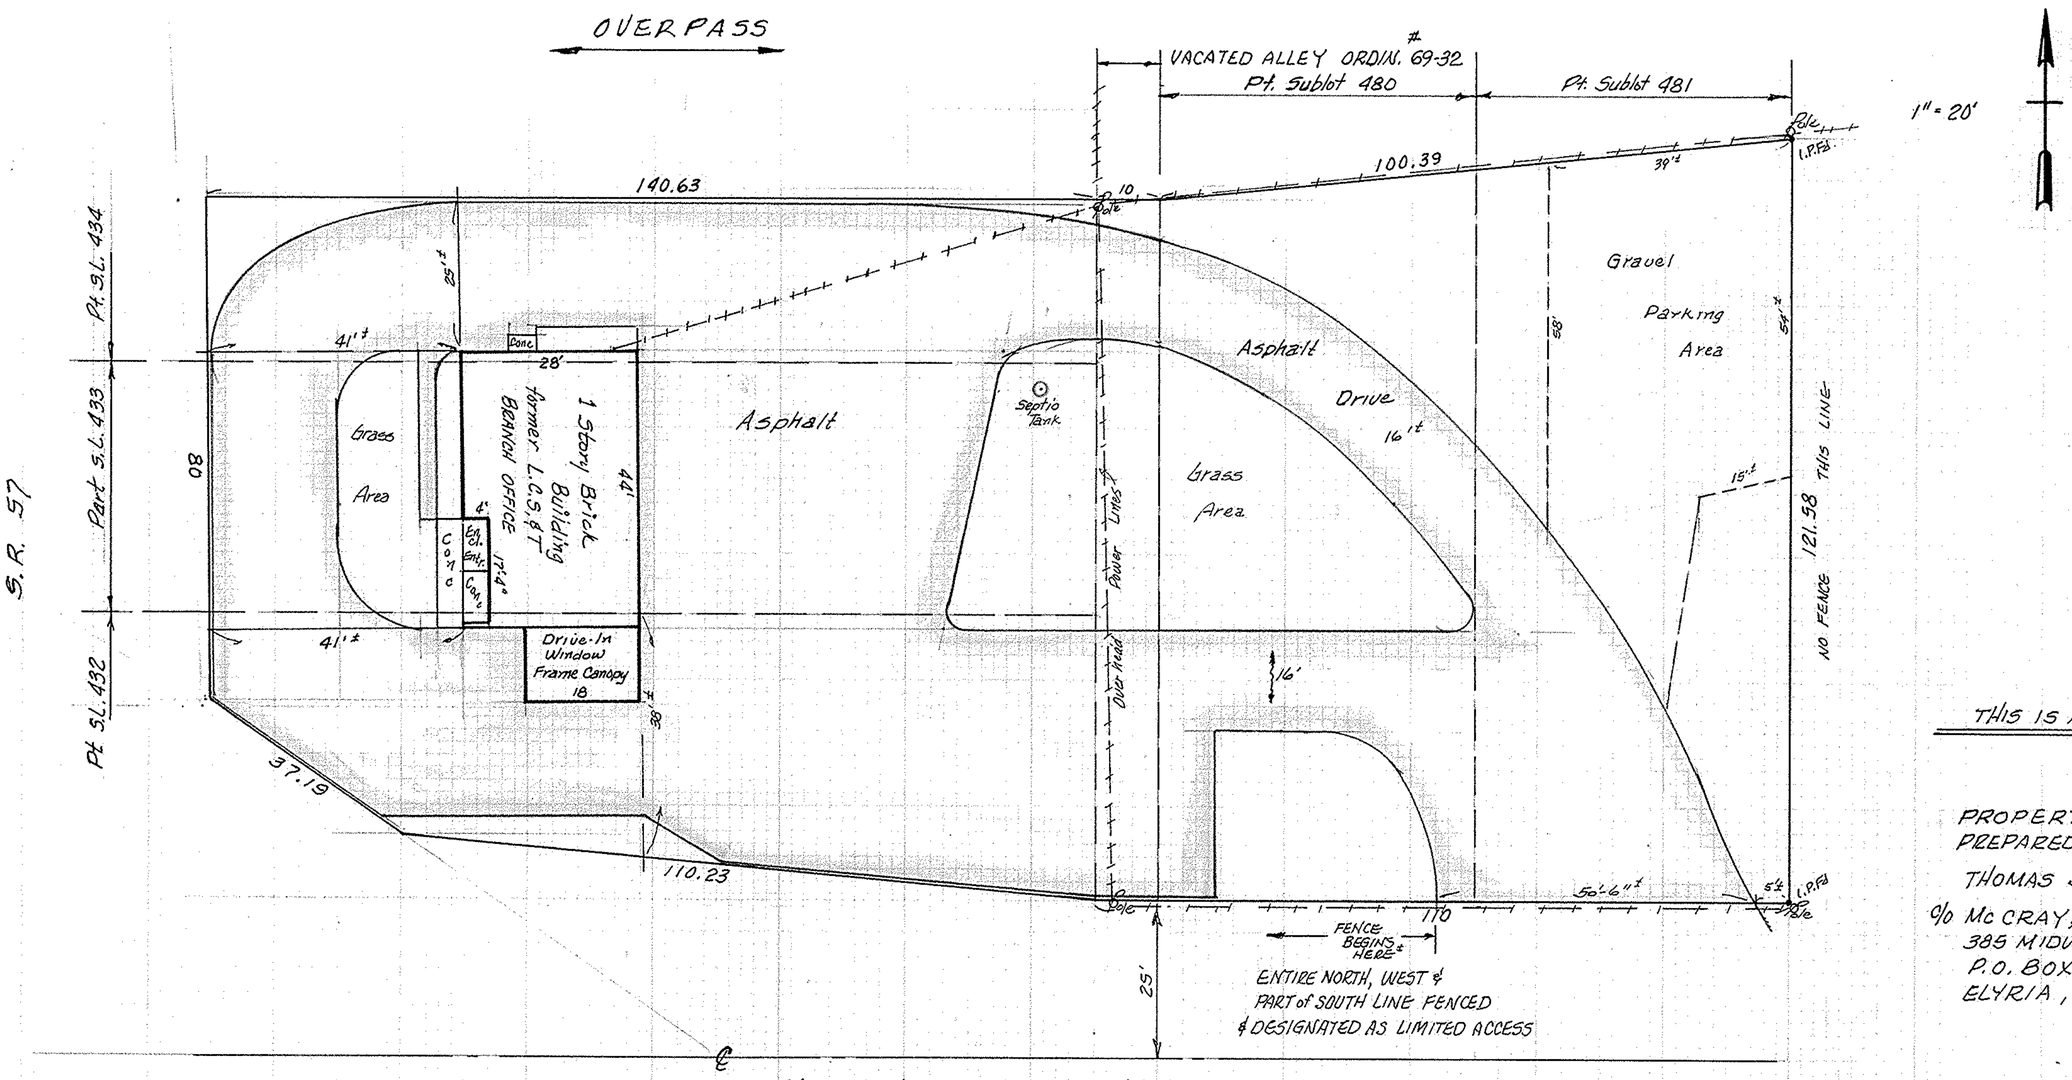

PART OF SUBLOT NOS. 432, 433, 434, 480 & 481
plus PART of A VACATED ALLEY in
LEONA HEIGHTS ALLOTMENT
PLAT VOLUME 6 PAGES 35 & 36
PART of ORIGINAL ELYRIA TWP. LOT 31 - WEST of BLACK RIVER
NOW in CITY of ELYRIA, OHIO

THIS IS NOT A PLAT of SURVEY

PROPERTY & BUILDING LOCATION PLAN
PREPARED FOR:

THOMAS J. SMITH - ATTORNEY
℅ McCRAY, MUZILLA, MOREY & SMITH CO. LPA
385 MIDWAY MALL BOULEVARD
P.O. BOX 119
ELYRIA, OHIO 44036

BY

McGLINCHY & ASSOCIATES INC.
REGISTERED SURVEYORS & ENGINEERS
110½ MIDDLE AVE ELYRIA, OHIO

OCT. 1, 1982 827384