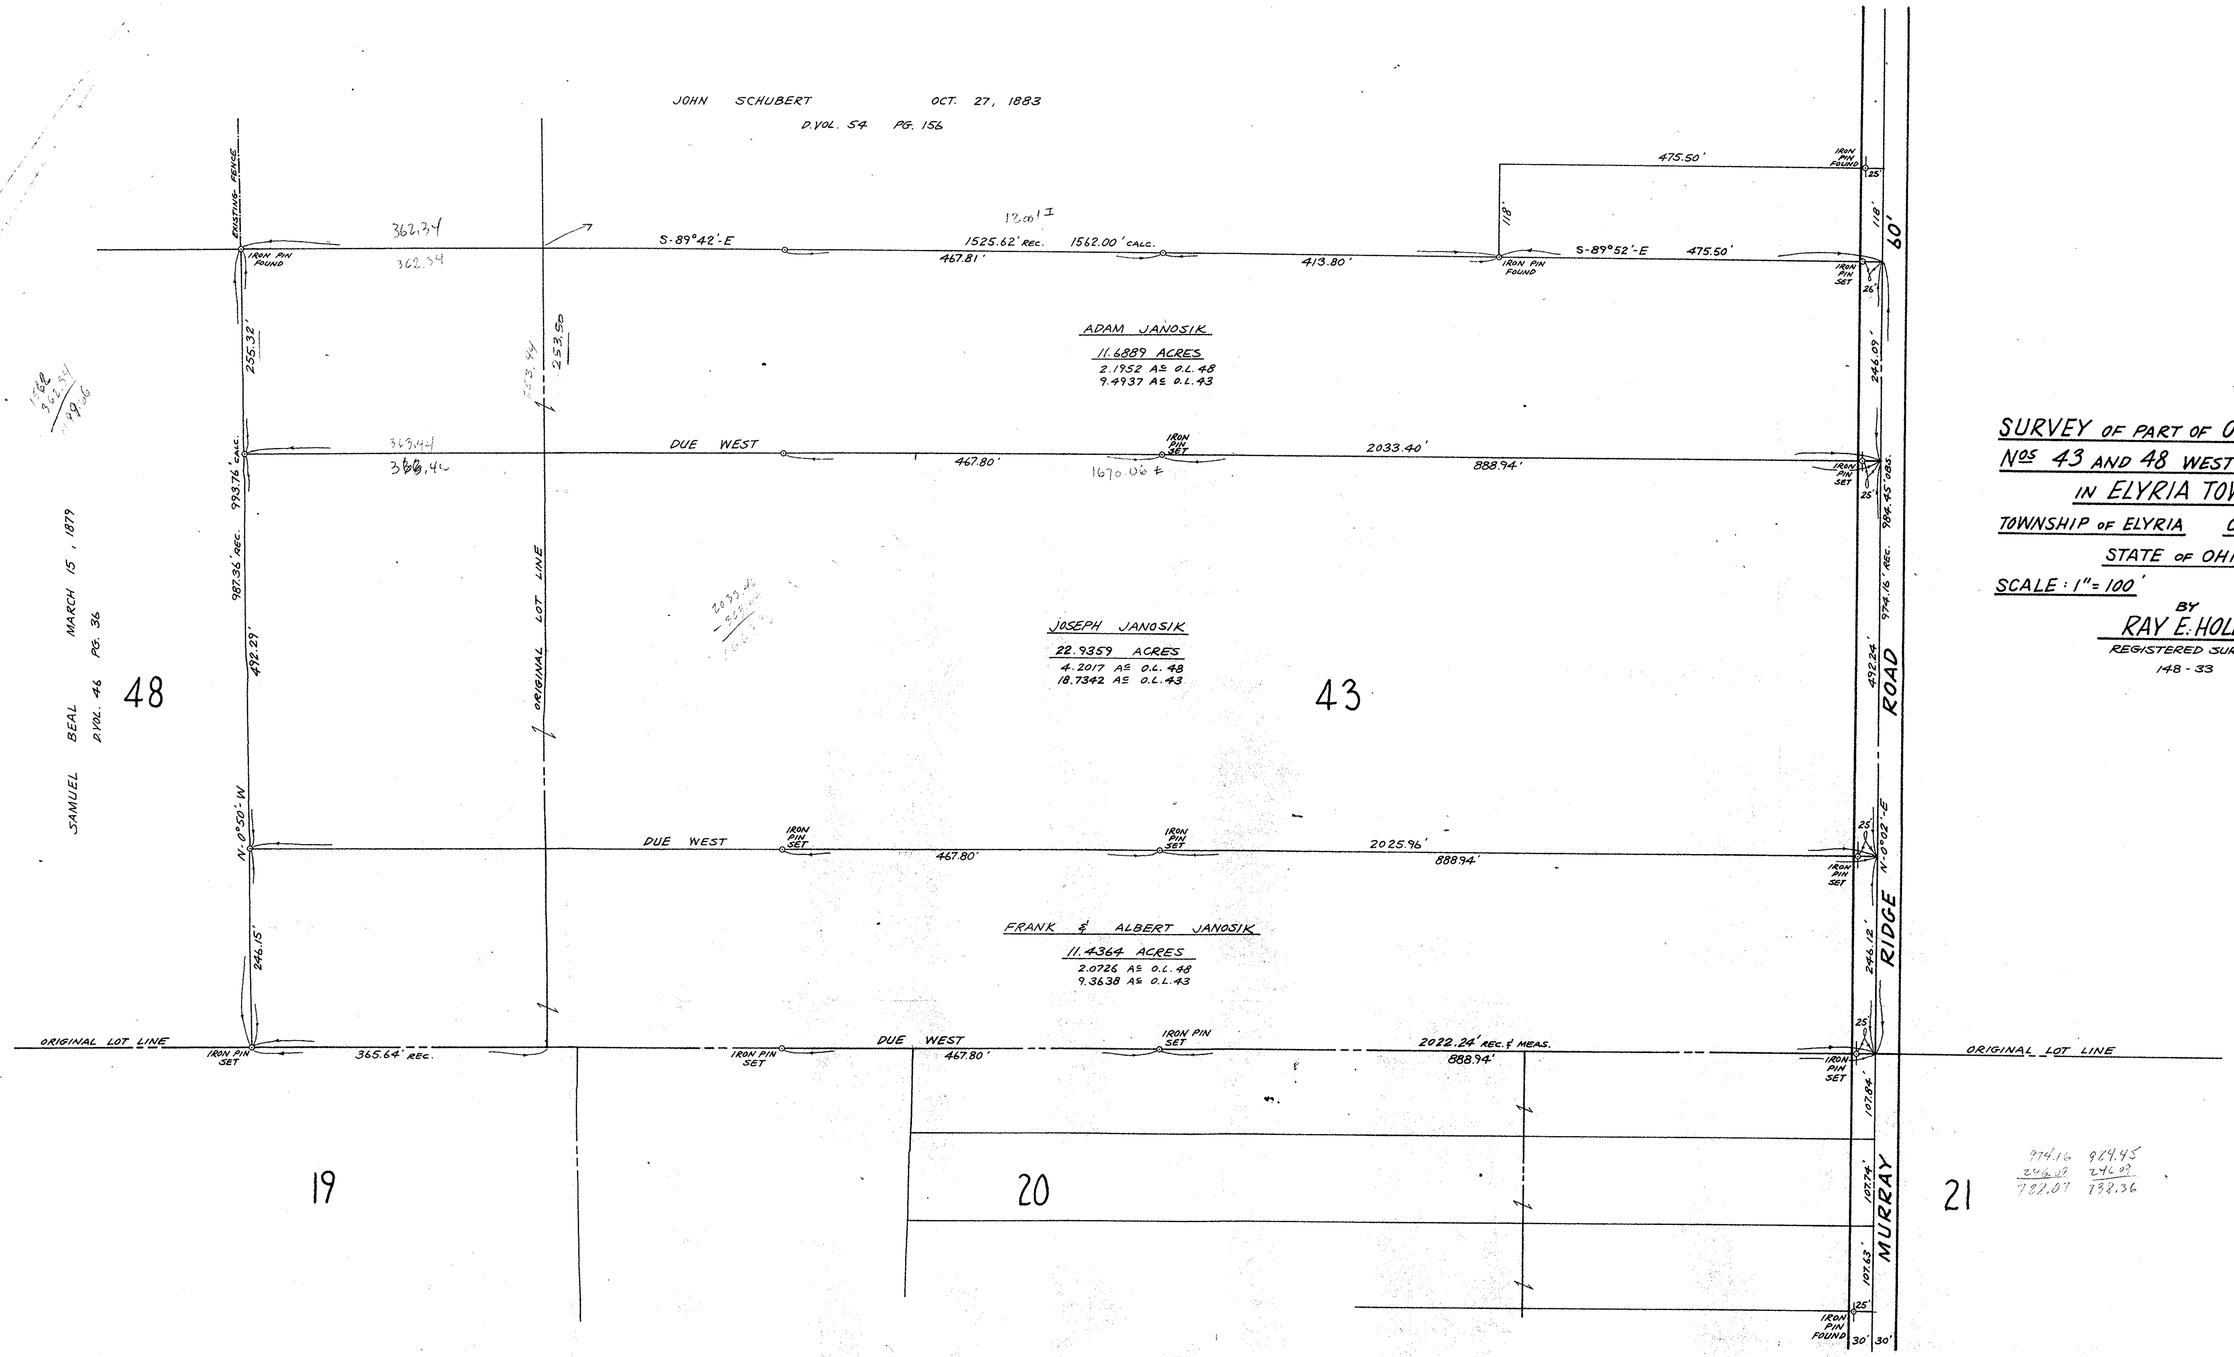

SURVEY OF PART OF ORIGINAL LOTS Nos 43 AND 48 WEST OF BLACK RIVER IN ELYRIA TOWNSHIP

TOWNSHIP OF ELYRIA COUNTY OF LORAIN

STATE OF OHIO

SCALE: 1" = 100' AUGUST 1969

BY

RAY E. HOLLIS

REGISTERED SURVEYOR

148-33

C 6-wof 8-43 48