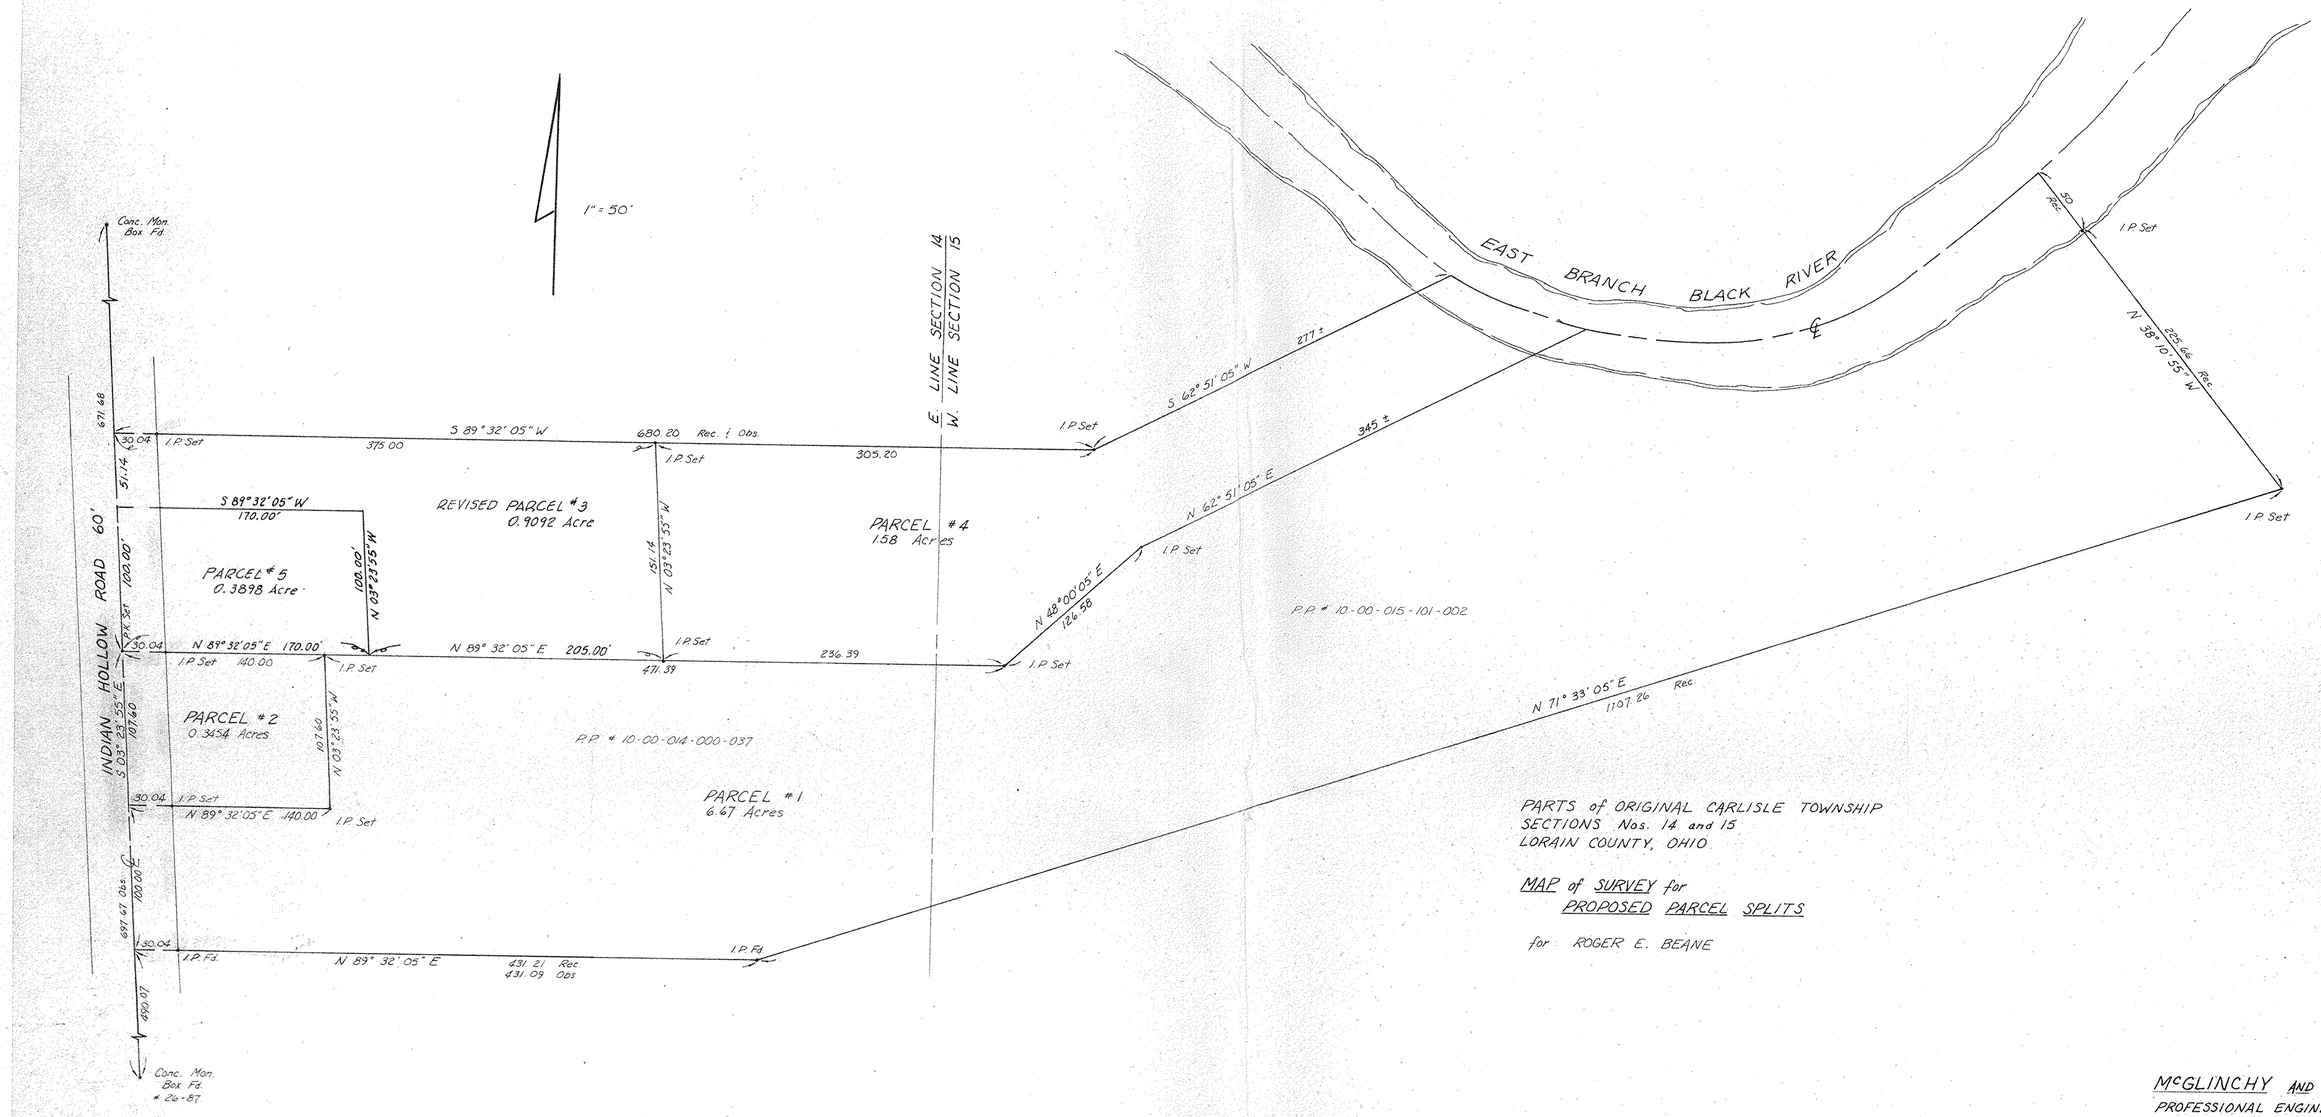

PARTS of ORIGINAL CARLISLE TOWNSHIP
SECTIONS Nos. 14 and 15
LORAIN COUNTY, OHIO

MAP of SURVEY for
PROPOSED PARCEL SPLITS

for ROGER E. BEANE

McGLINCHY AND ASSOCIATES
PROFESSIONAL ENGINEERS AND
REGISTERED SURVEYORS
538 WEST BROAD STREET ELYRIA, OHIO
JUNE 28, 1977 #772137

REV. 3-30-78 REVISED PARCEL #3, ADDED PARCEL #5