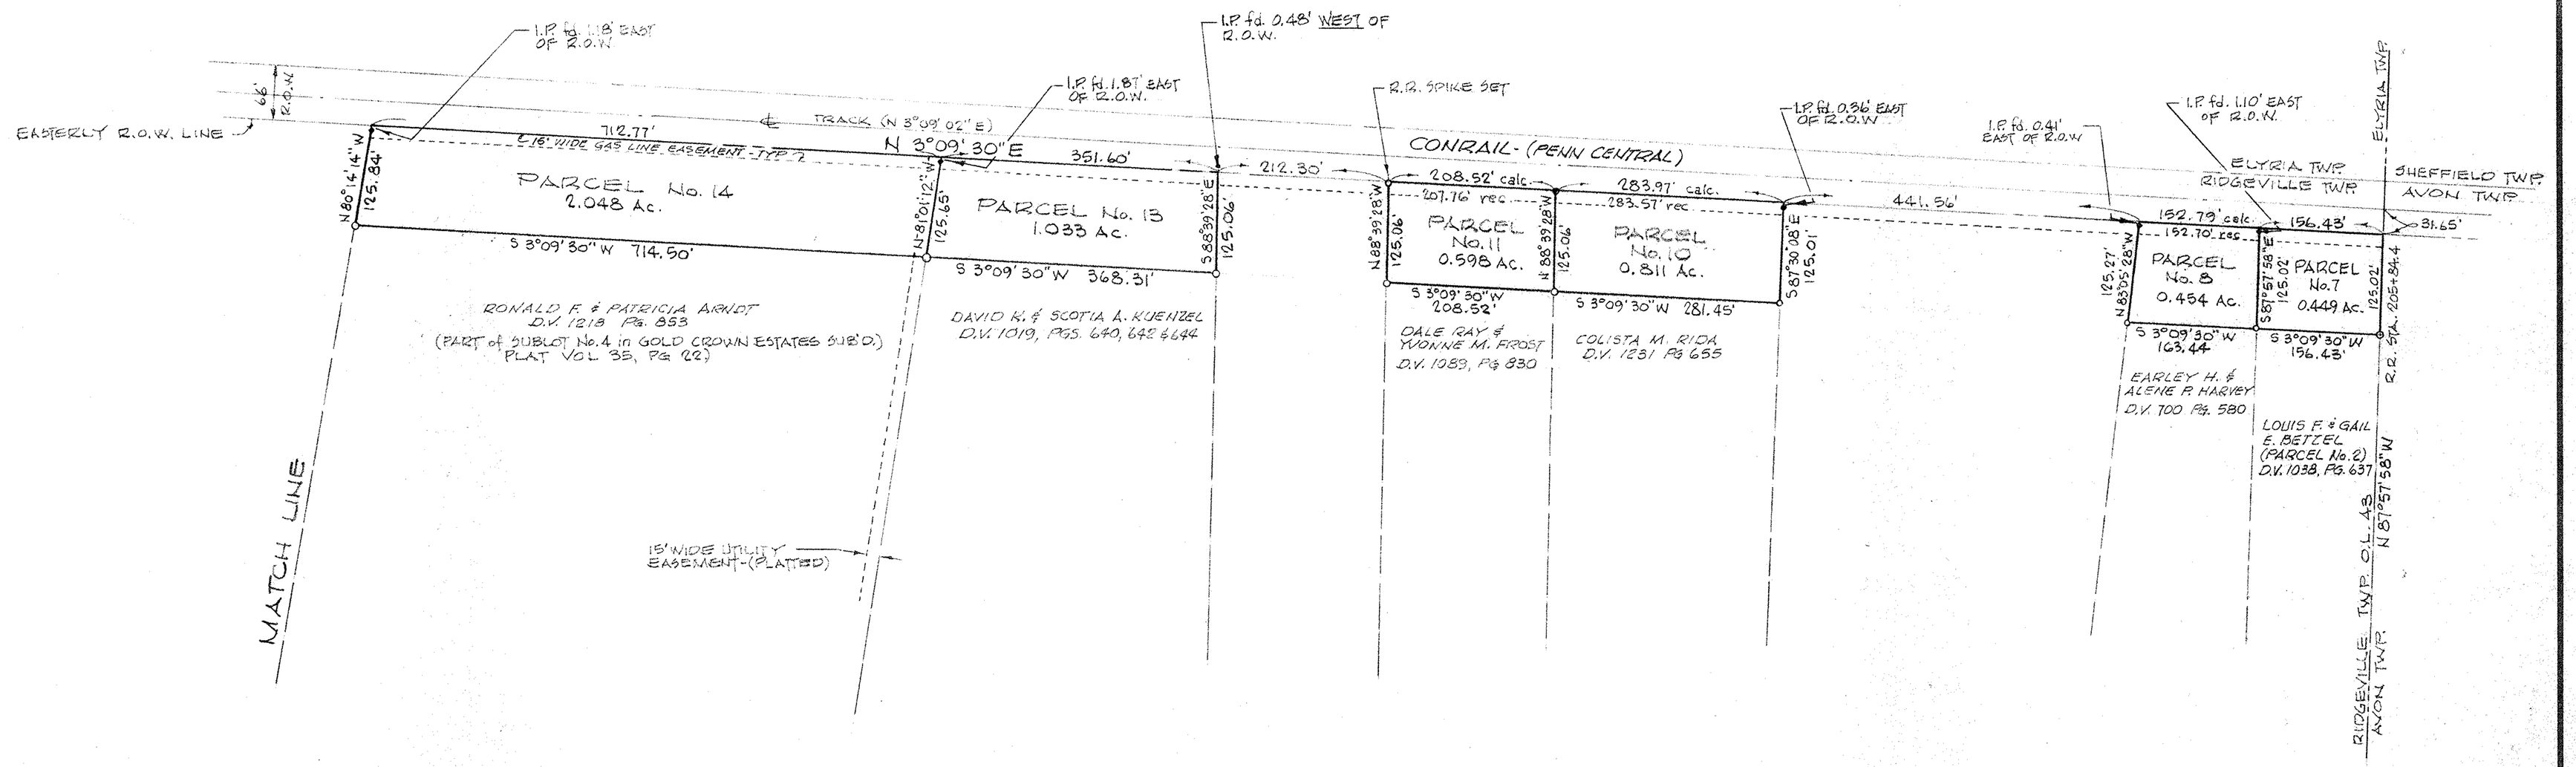

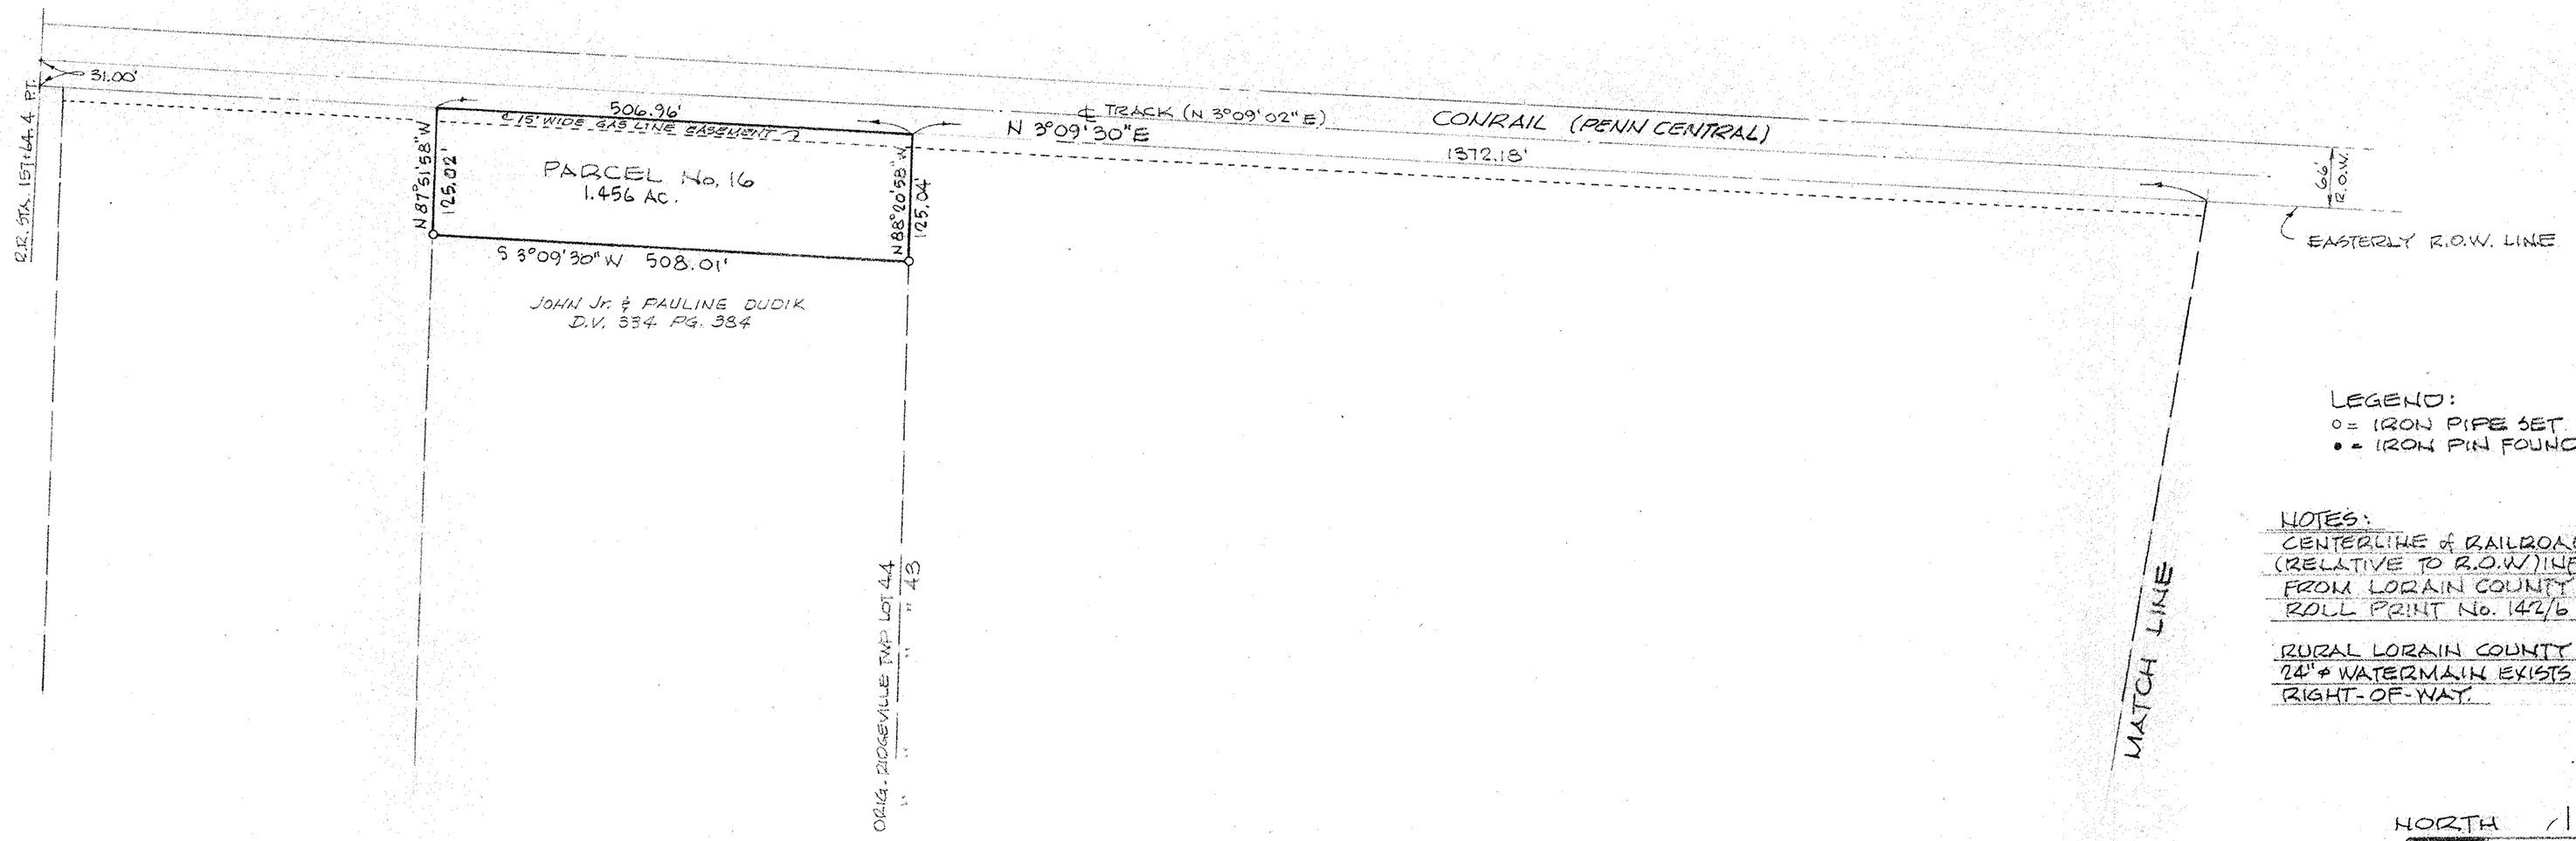

LEGEND:
○ = IRON PIPE SET
• = IRON PIN FOUND

NOTES:
CENTERLINE of RAILROAD TRACK LOCATION (RELATIVE TO R.O.W.) INFORMATION DERIVED FROM LORAIN COUNTY TAX MAP DEPT. ROLL PRINT No. 1426

RURAL LORAIN COUNTY WATER AUTHORITY'S 24"ϕ WATERMAIN EXISTS WITHIN THE RAILROAD RIGHT-OF-WAY.

NORTH

MAP of SURVEY

PREPARED FOR OHIO EDISON COMPANY

PARTS of ORIGINAL RIDGEVILLE TOWNSHIP LOT Nos. 43 & 44
CITY of NORTH RIDGEVILLE, LORAIN COUNTY, OHIO

McGLINCHY AND ASSOCIATES
PROFESSIONAL ENGINEERS AND SURVEYORS
538 WEST BROAD ST. ELYRIA, OHIO

SCALE: 1" = 100' DRAWN BY: B. THOMAS
DATE: JAN. 1980 JOB NO: 796025
REV. 7-25-80 - ADDED PARCEL #7