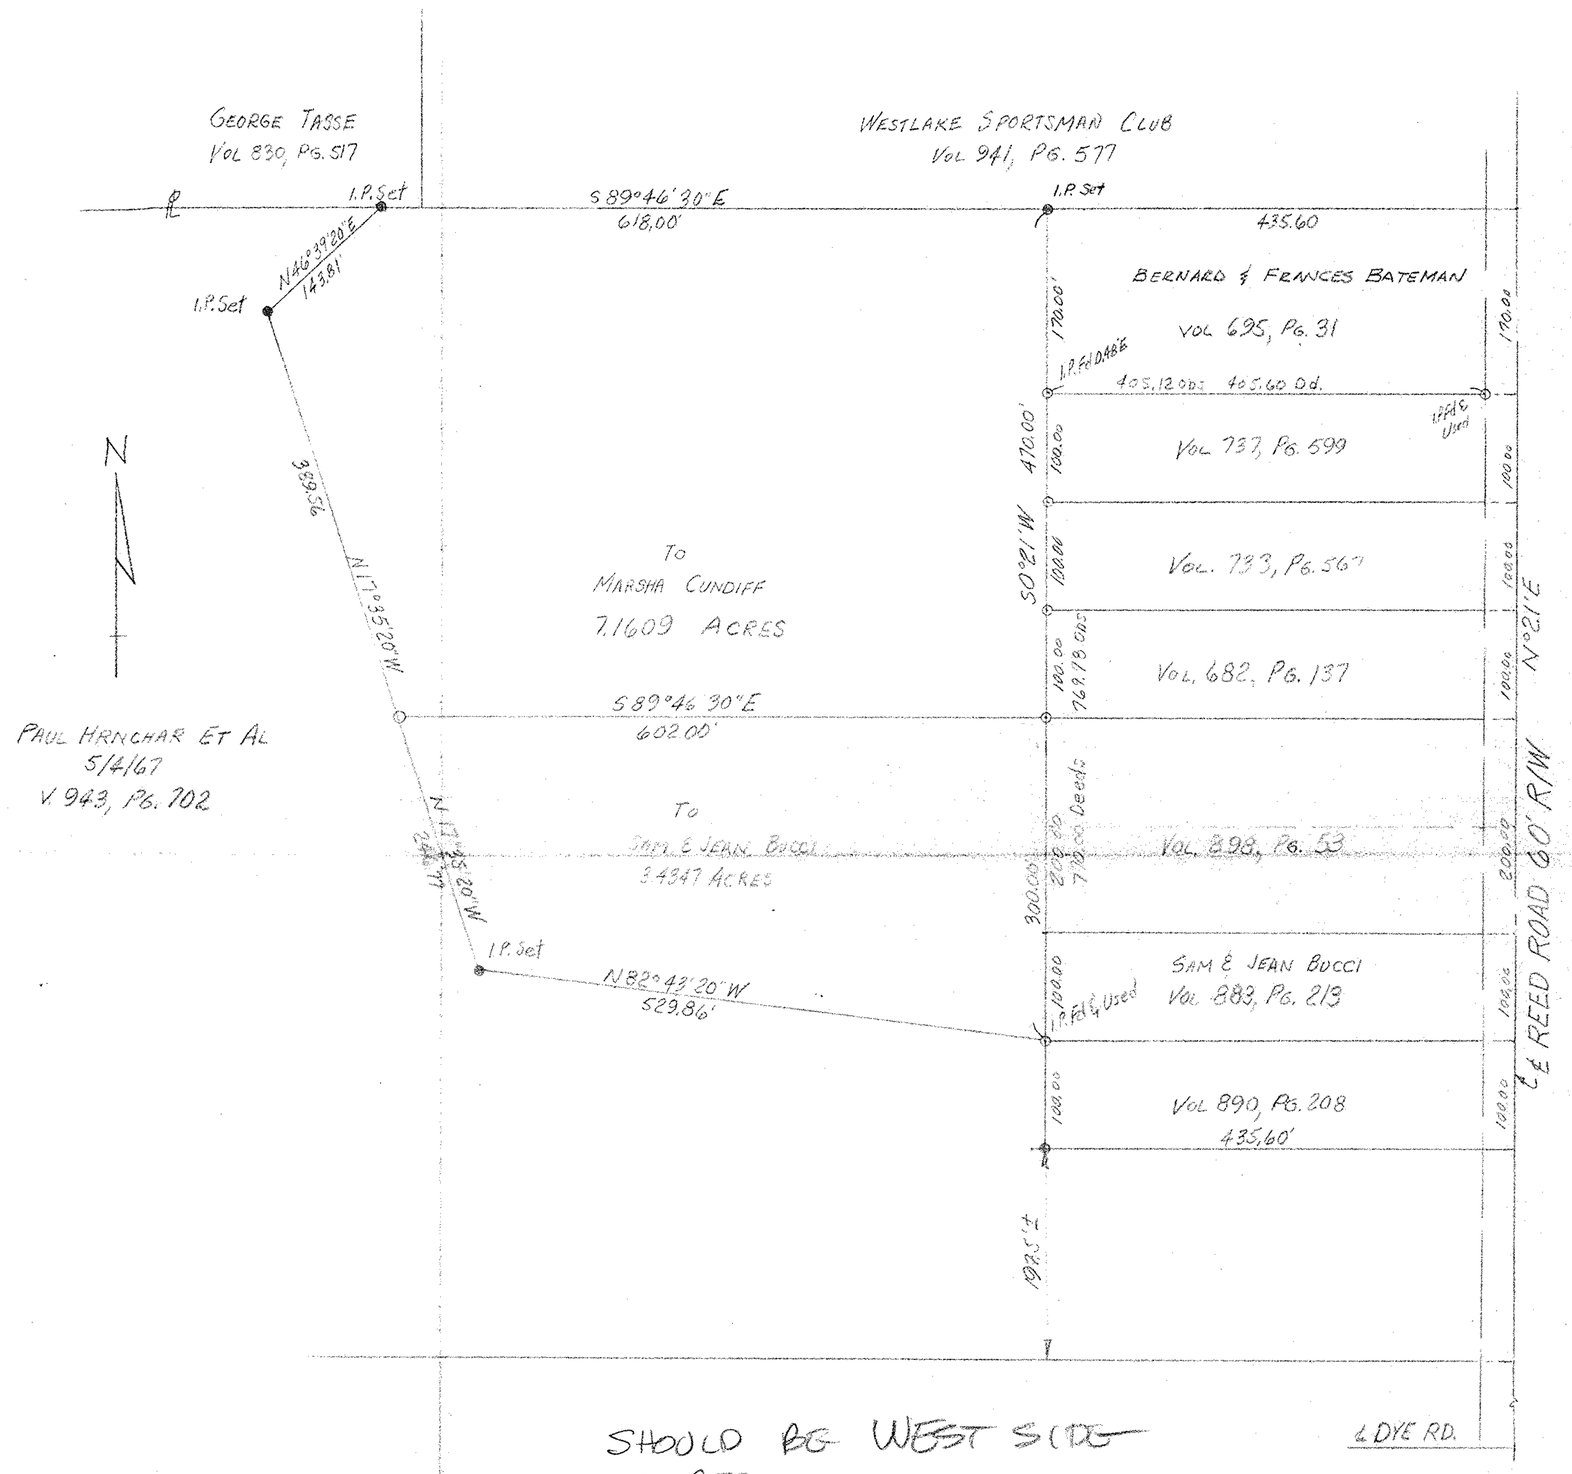


PLAT OF SURVEY FOR
ROY & MARGARET BORCHERT
(PAUL HRNCHAR ET AL PROPERTY)
O.L. 29, EATON TWP., LORAIN CO., OHIO

McGLINCHY & ASSOCIATES
PROFESSIONAL ENGINEERS & SURVEYORS
538 W. BROAD ST. ELYRIA, OHIO 44035
JOB No 75168 1" = 100' FEB. 1975

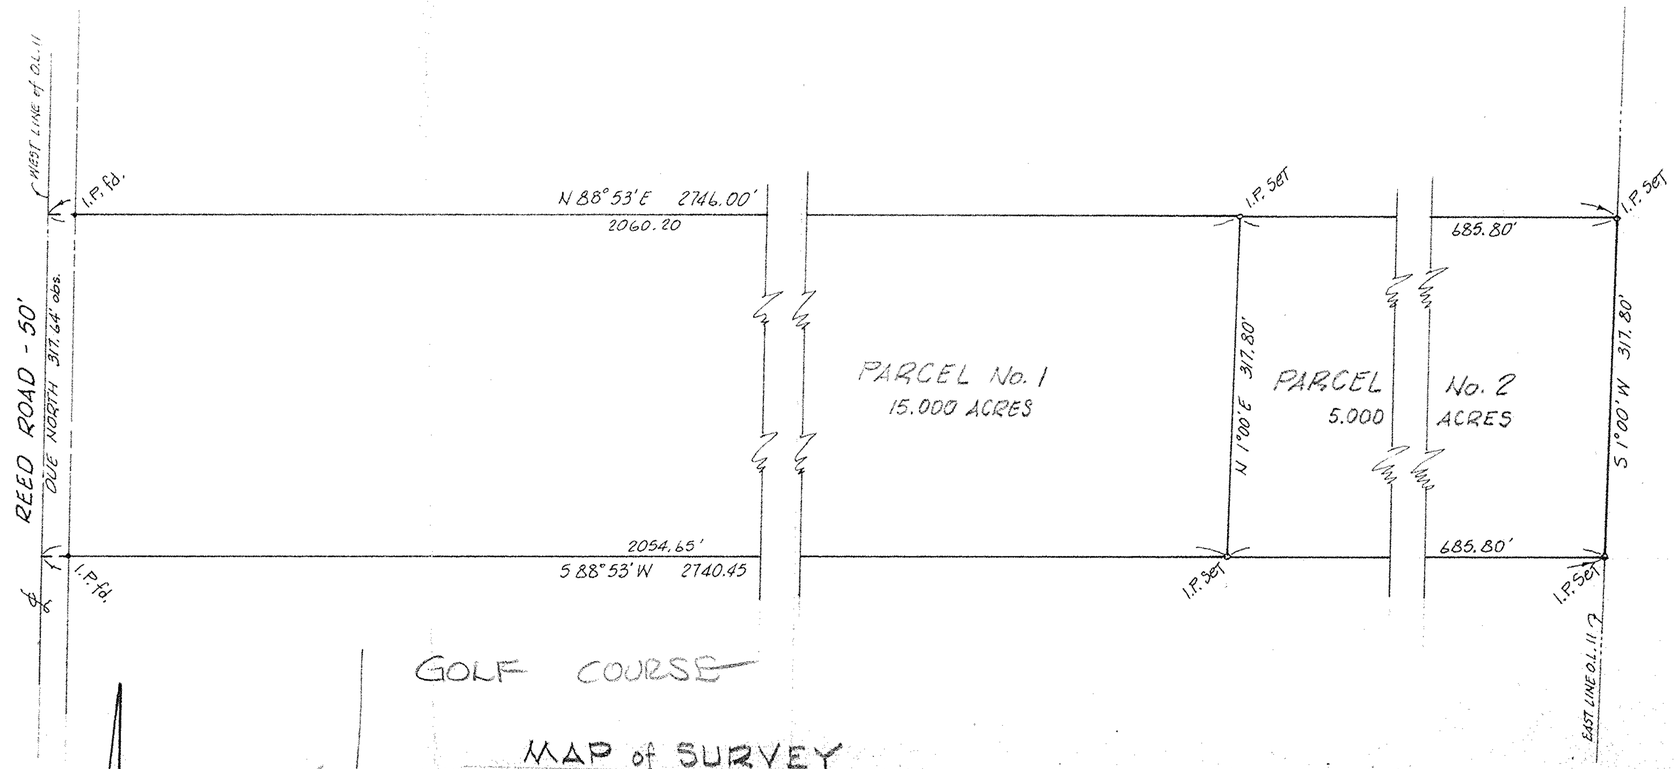


MAP of SURVEY
for
JOHN P. BERENA
PART of ORIGINAL EATON TOWNSHIP LOT No. 11
EATON TOWNSHIP, LORAIN COUNTY, OHIO

McGLINCHY and ASSOCIATES
PROFESSIONAL ENGINEERS and SURVEYORS
ELYRIA, OHIO
OCTOBER 6, 1977 JOB # 772525