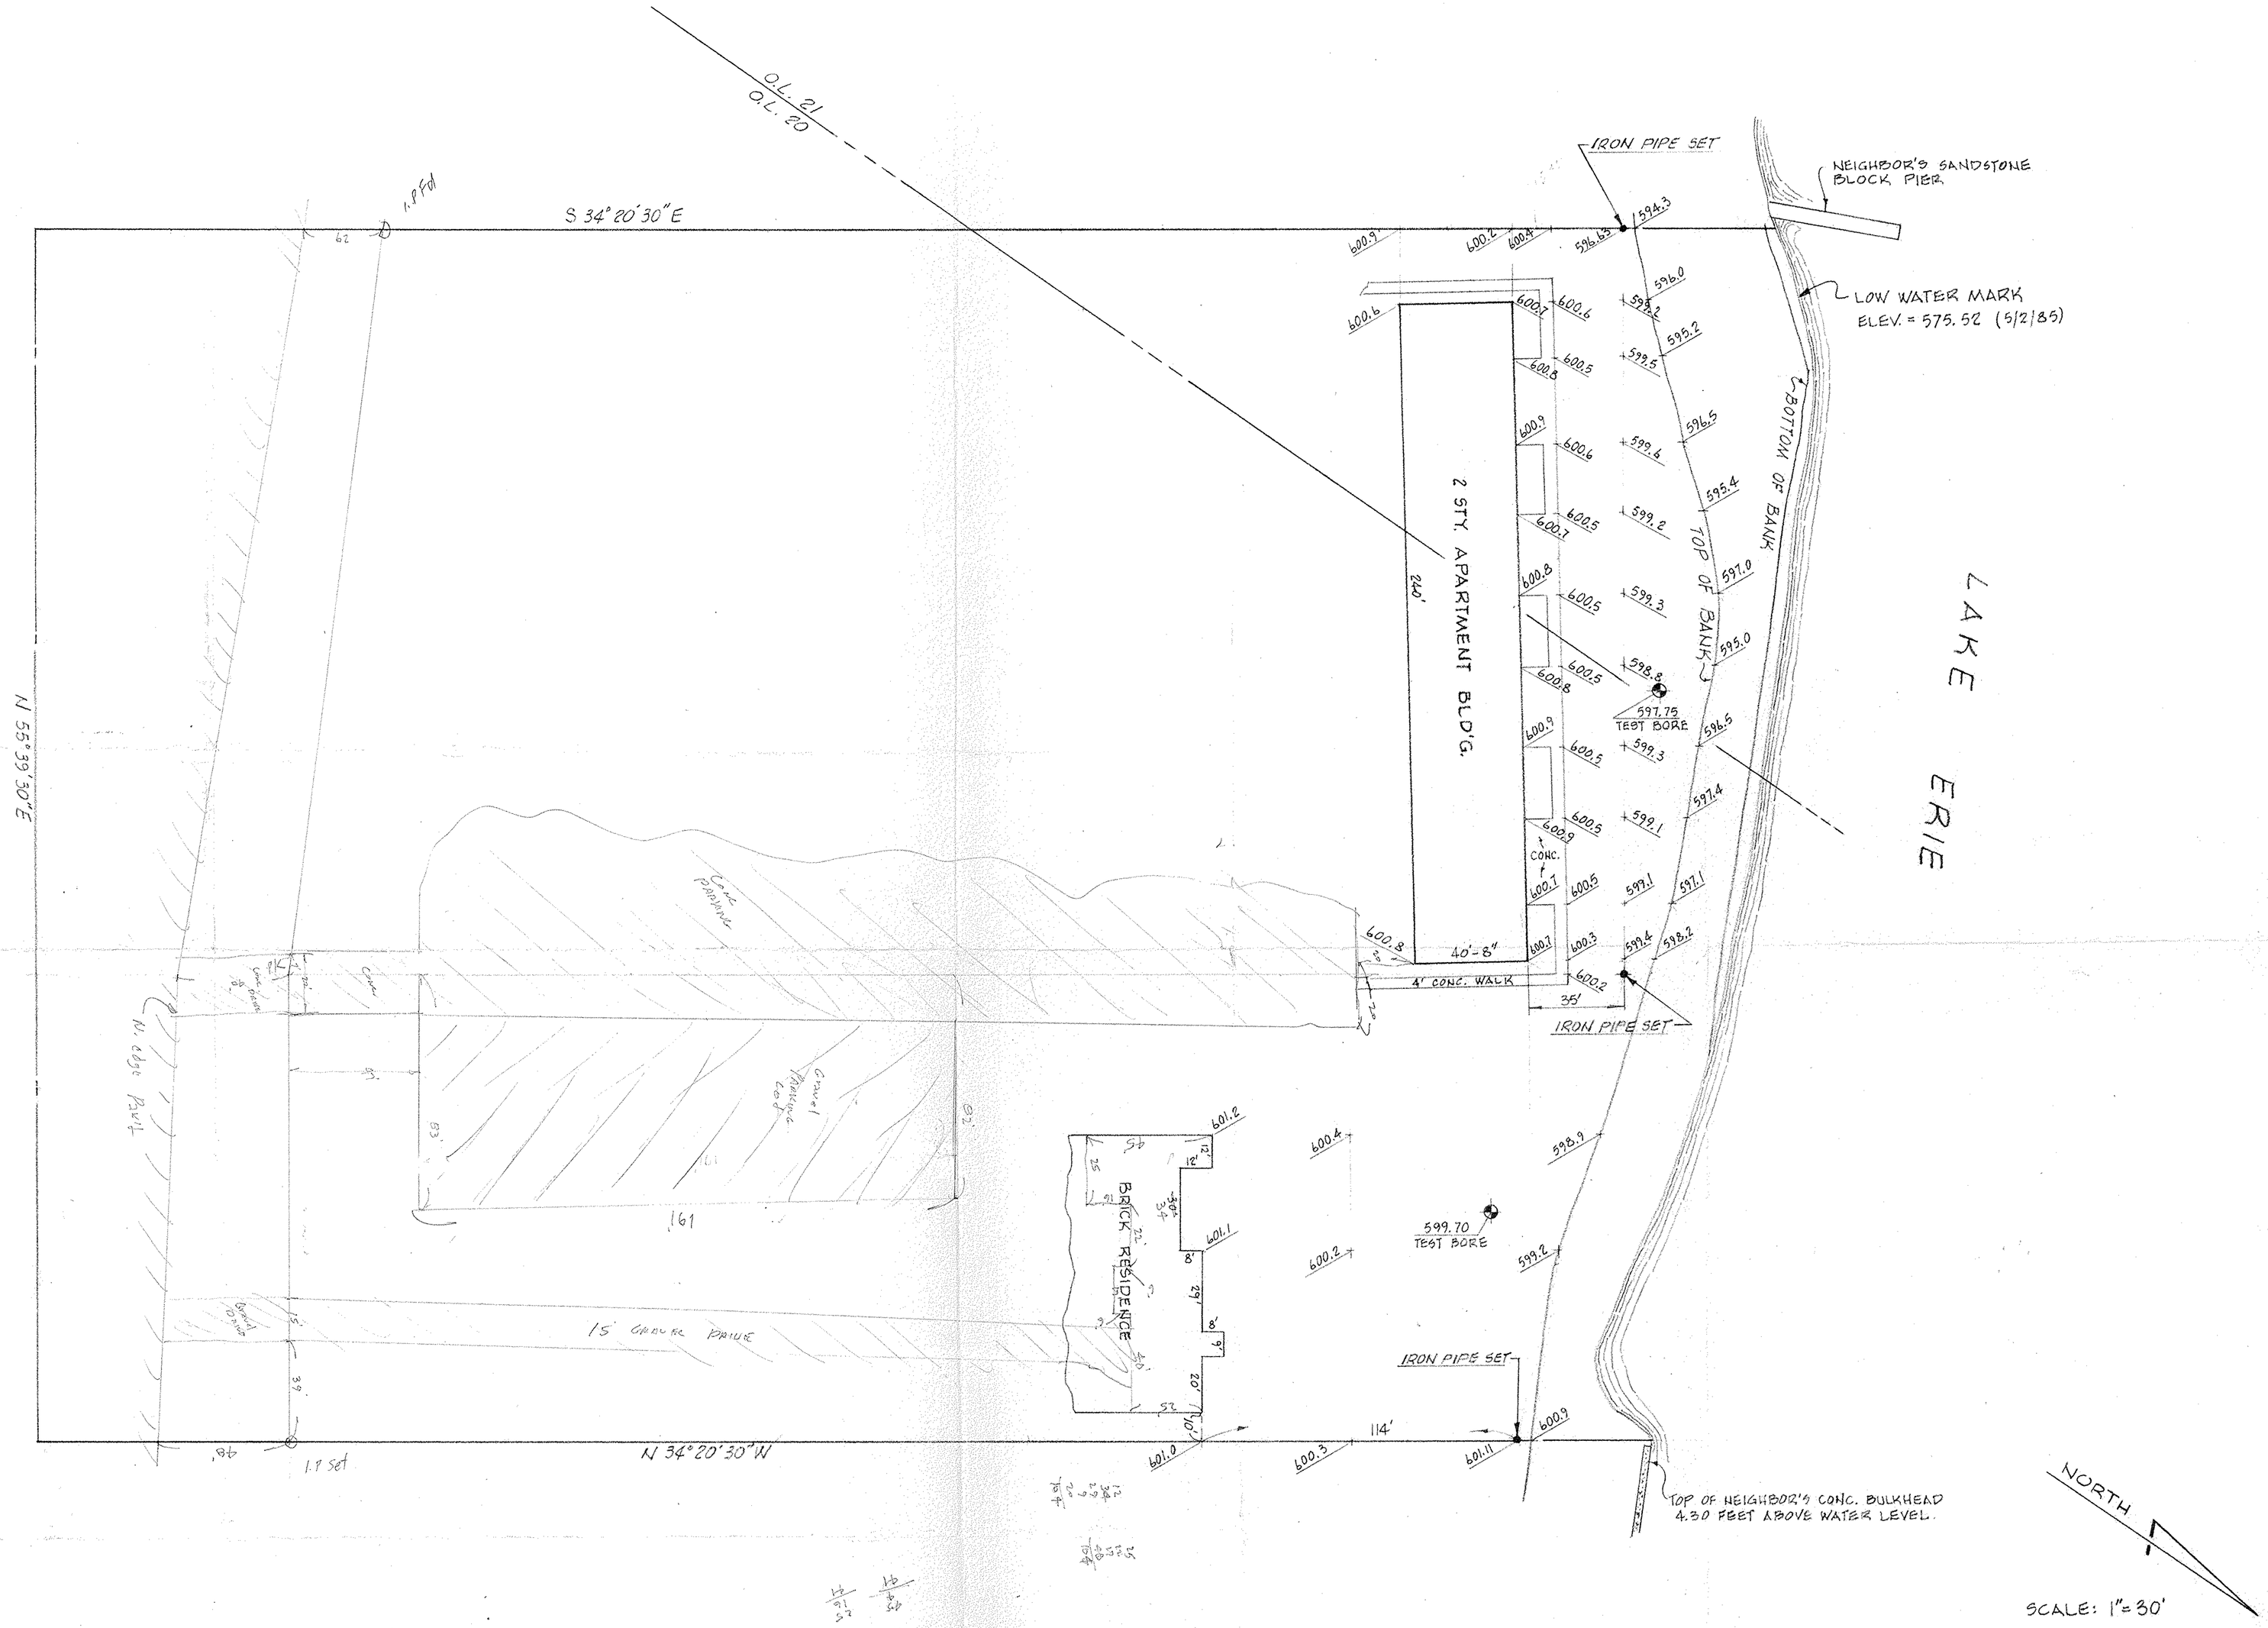

PARTIAL BOUNDARY and TOPOGRAPHIC SURVEY

PART OF ORIGINAL BLACK RIVER TWP LOT Nos. 20 & 21, TRACT 2
CITY of LORAIN LORAIN COUNTY OHIO

McGLINCHY and ASSOCIATES INC.
PROFESSIONAL ENGINEER and SURVEYORS
110½ MIDDLE AVE. ELYRIA, OHIO
MAY, 1985 #848480