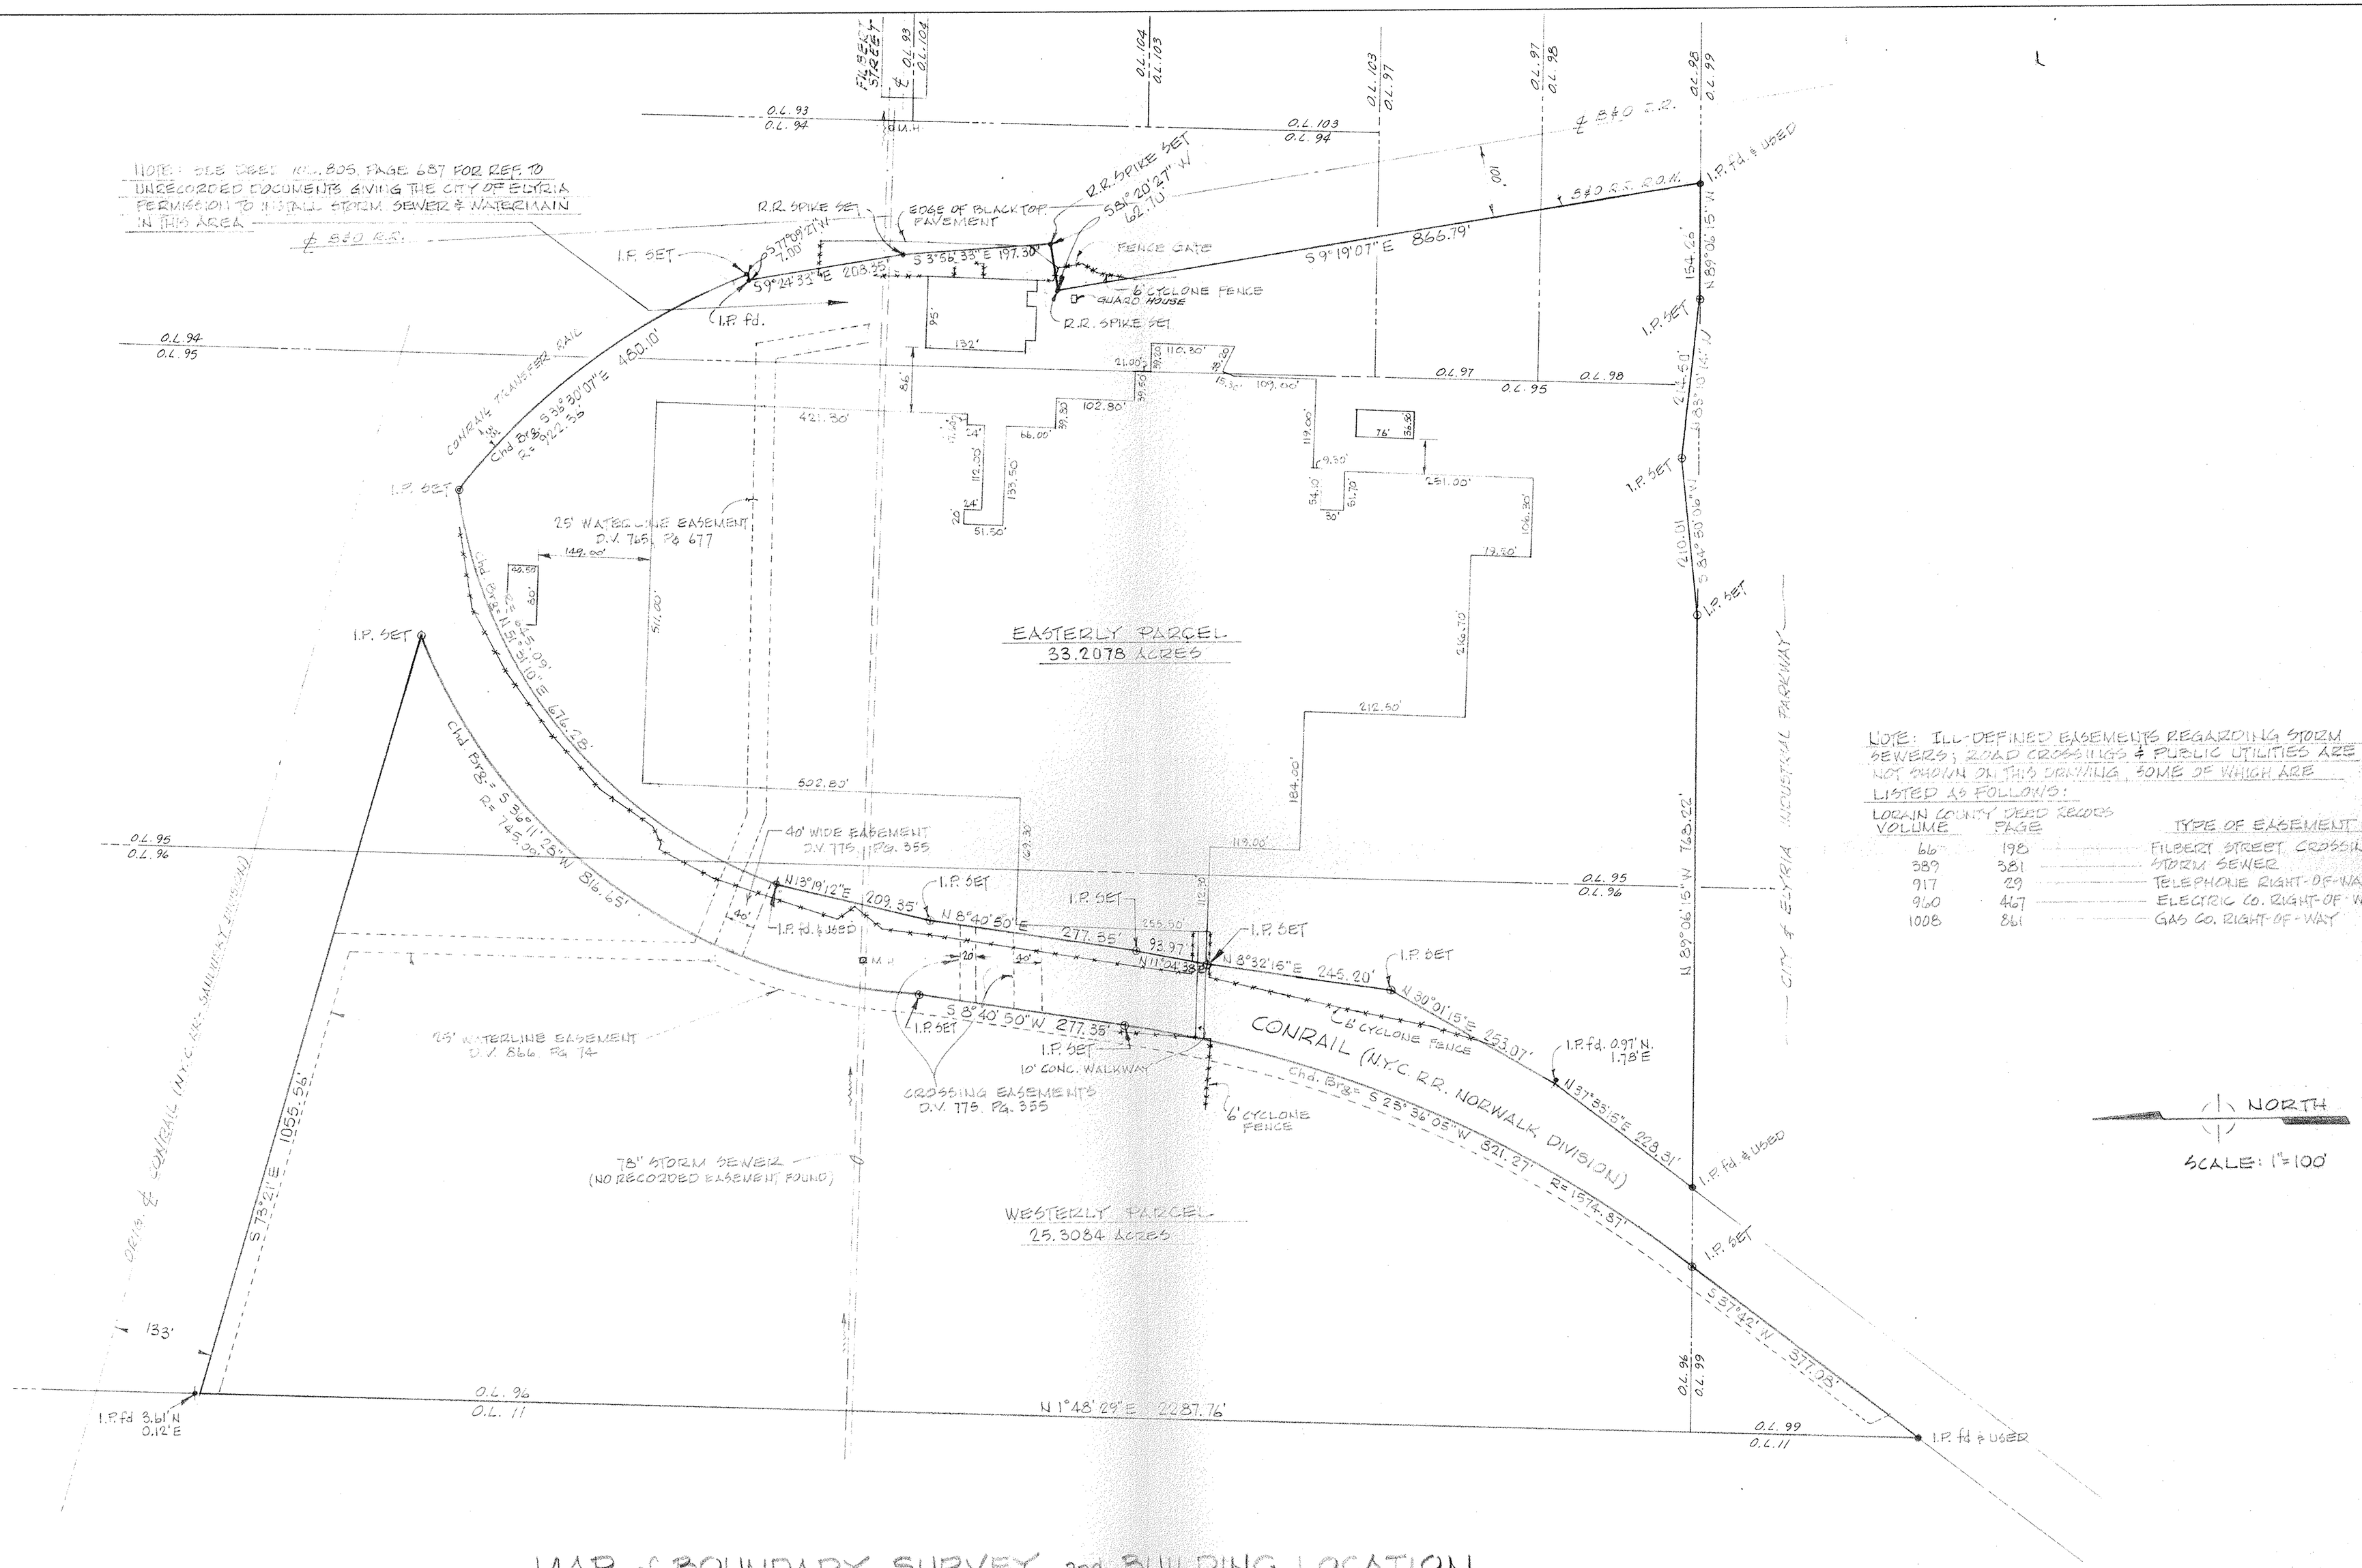

NOTE: ILL-DEFINED EASEMENTS REGARDING STORM SEWERS; ROAD CROSSINGS & PUBLIC UTILITIES ARE NOT SHOWN ON THIS DRAWING, SOME OF WHICH ARE LISTED AS FOLLOWS:

LORAIN COUNTY DEED RECORDS VOLUME	PAGE	TYPE OF EASEMENT
66	198	FILBERT STREET CROSSING
389	381	STORM SEWER
917	29	TELEPHONE RIGHT-OF-WAY
960	467	ELECTRIC CO. RIGHT-OF-WAY
1008	861	GAS CO. RIGHT-OF-WAY

MAP of BOUNDARY SURVEY and BUILDING LOCATION

PREPARED AT THE INSTANCE OF LAWYERS TITLE INSURANCE COMPANY

PARTS of ORIGINAL ELYRIA TOWNSHIP LOTS Nos. 94, 95, 96, 97, 98 & 99 WEST of BLACK RIVER

CITY of ELYRIA LORAIN COUNTY OHIO

McGLINCHY and ASSOCIATES INC.
PROFESSIONAL ENGINEER and SURVEYORS
110½ MIDDLE AVE ELYRIA OHIO
JUNE, 1981 #816874

REV. 9-9-81