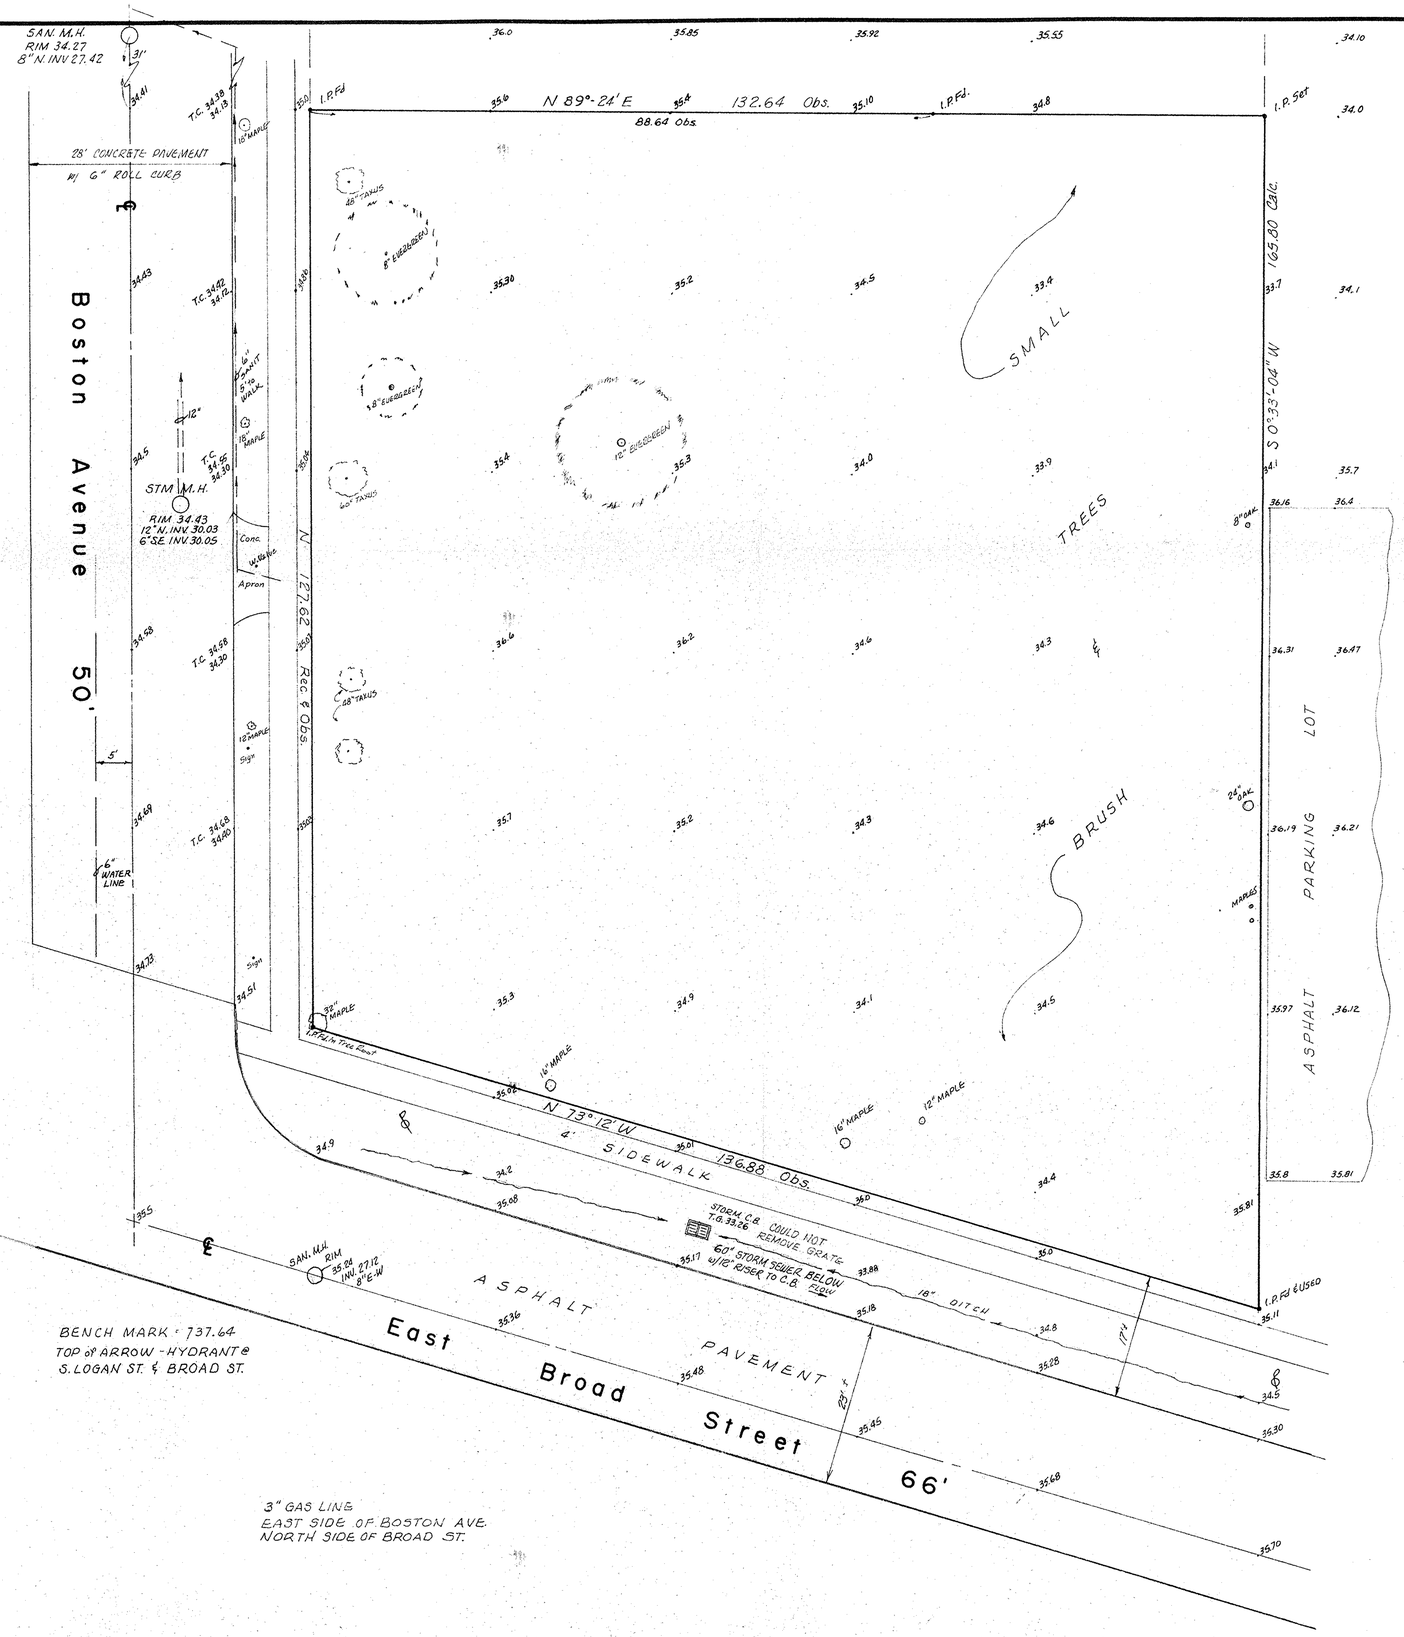

1" = 10'

N

PLAN of BOUNDARY & TOPOGRAPHIC SURVEY

by

McGLINCHY & ASSOCIATES Inc.

REGISTERED SURVEYORS & ENGINEERS

MAY 1982 827208

WYKOFF-LANDIG ASSOCIATES
ARCHITECTS

230 THIRD ST. • ELYRIA, OHIO 44035 216-322-7616
777 W. MARKET ST. • AKRON, OHIO 44303 216-376-1100

PROJECT:

DWG. NO.	JOB	DATE	REV.

OF