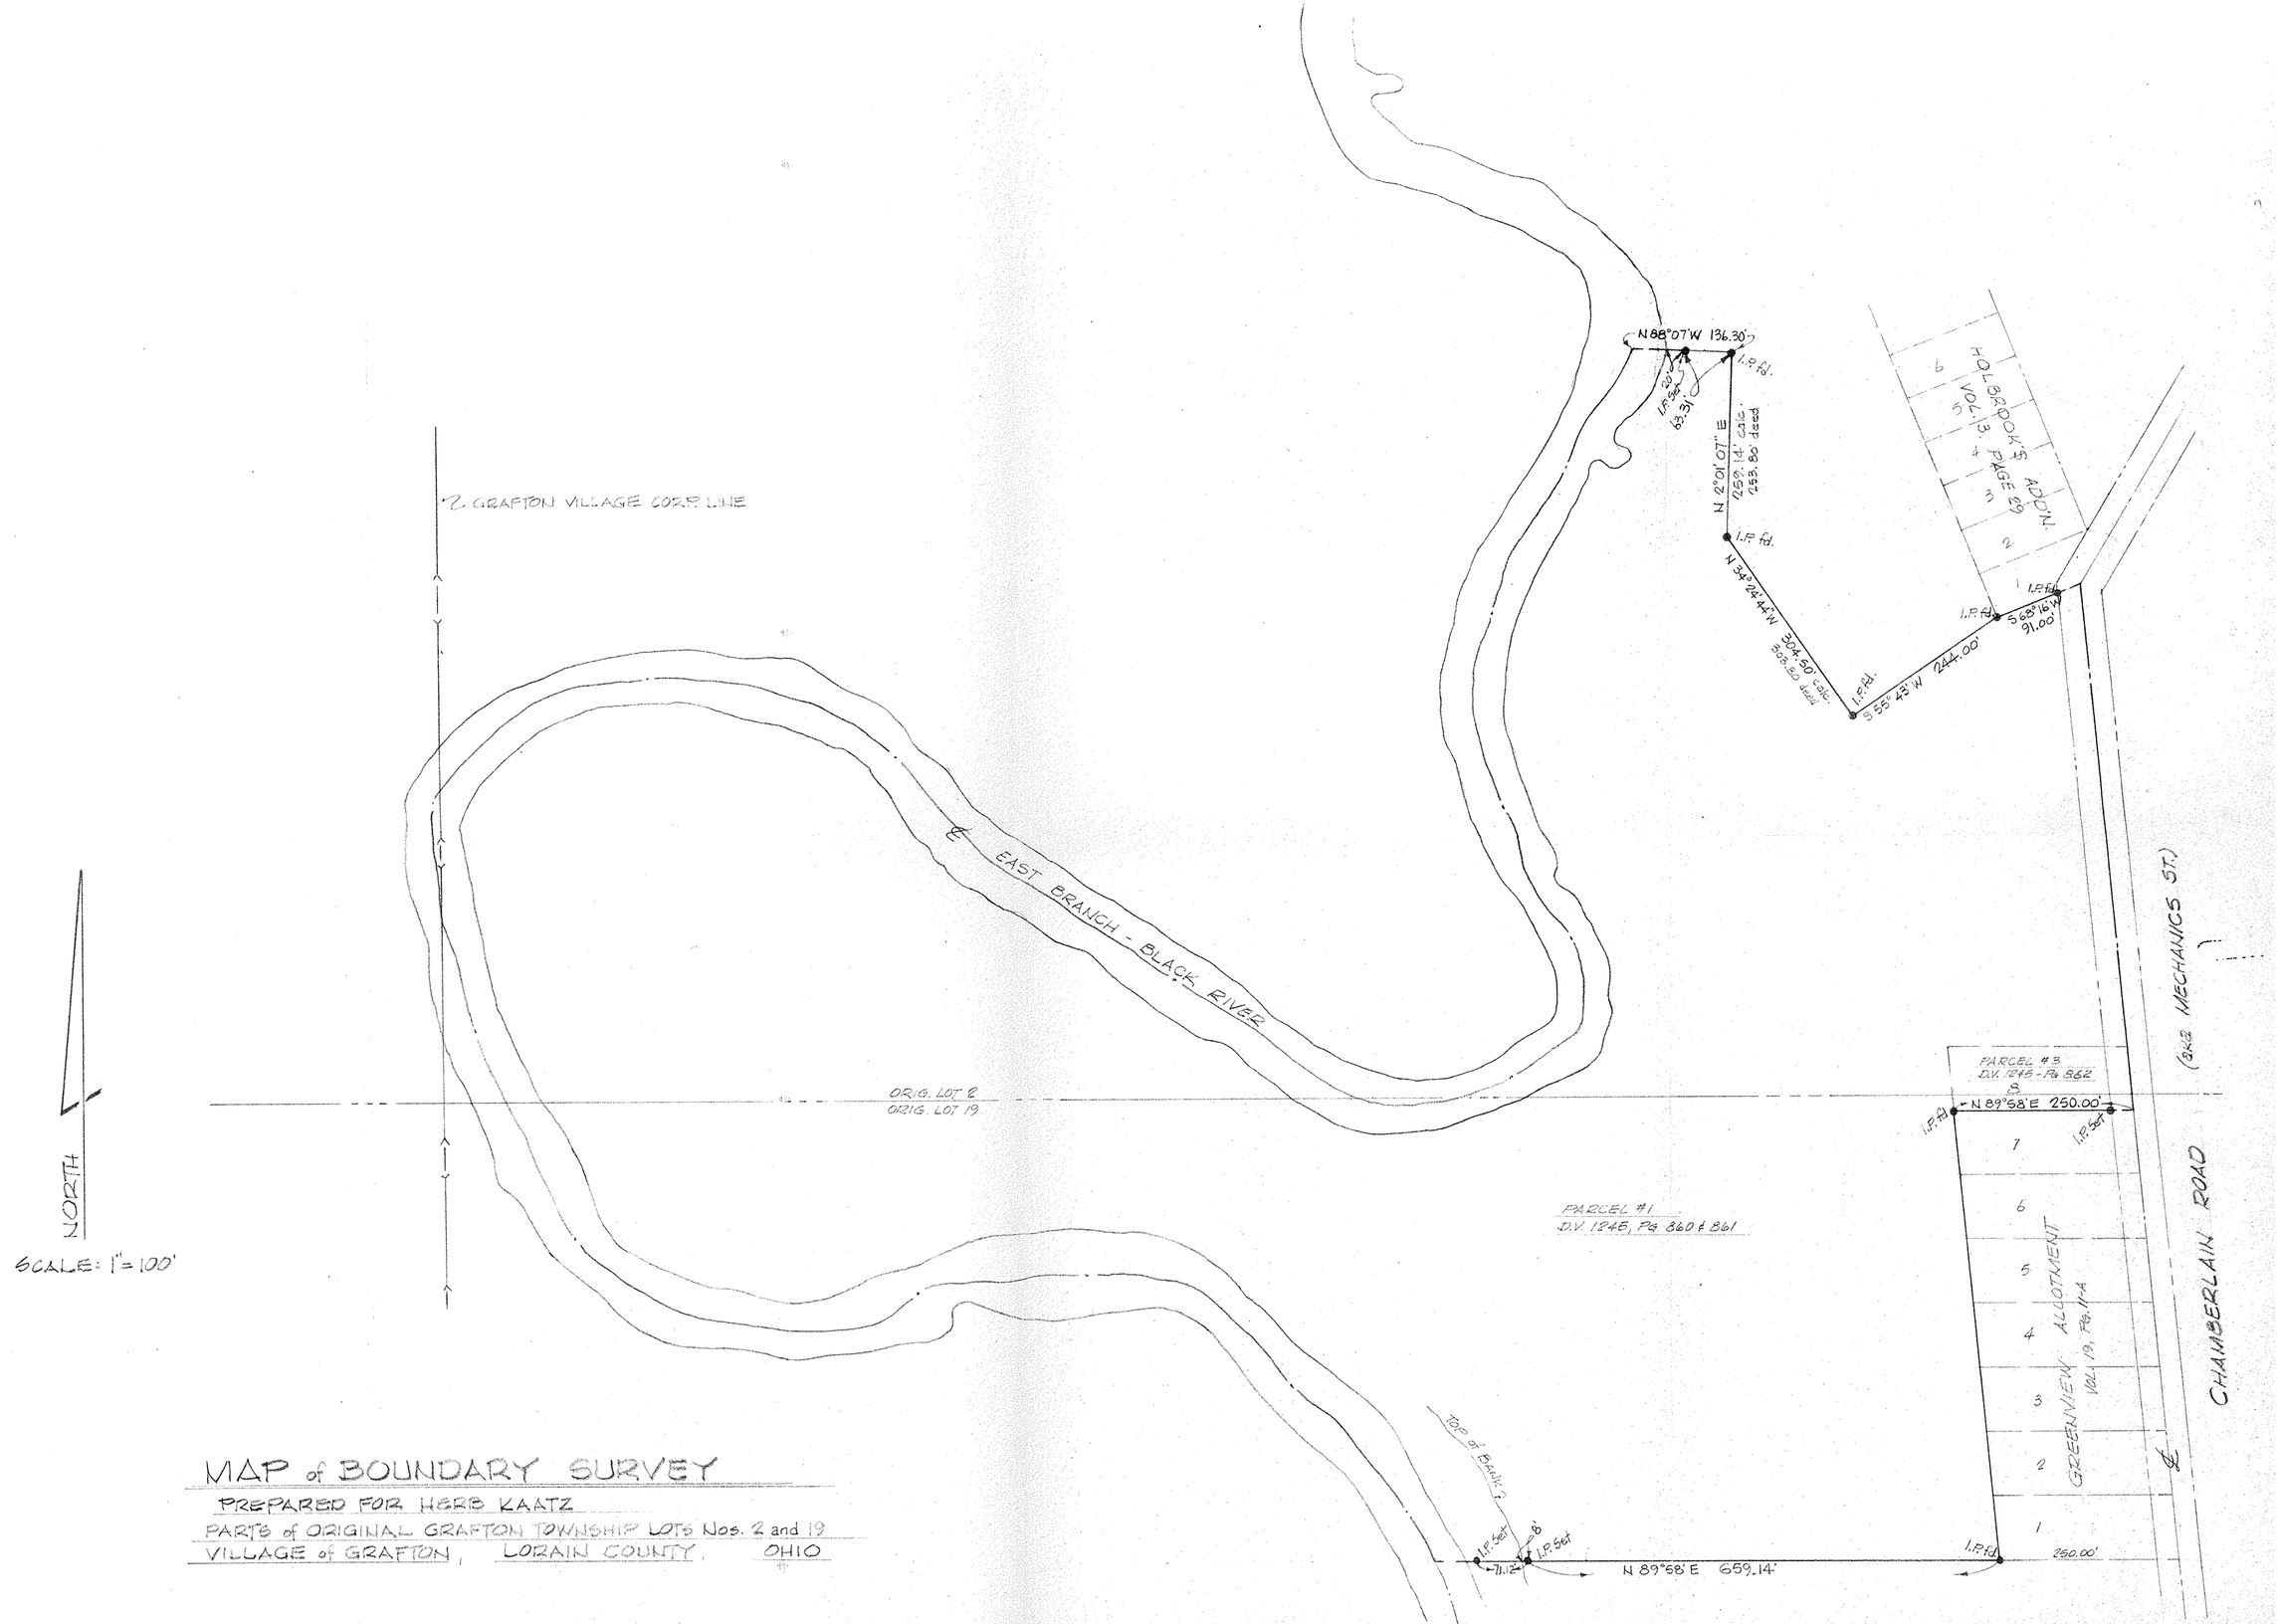

MAP of BOUNDARY SURVEY

PREPARED FOR HERB KAATZ

PARTS of ORIGINAL GRAFTON TOWNSHIP LOTS Nos. 2 and 19

VILLAGE of GRAFTON, LORAIN COUNTY, OHIO

McGLINCHY and ASSOCIATES INC.
PROFESSIONAL ENGINEER and SURVEYORS
110½ MIDDLE AVE. ELYRIA, OHIO
MAY 1982 # 82-7194

SHEET 1 of