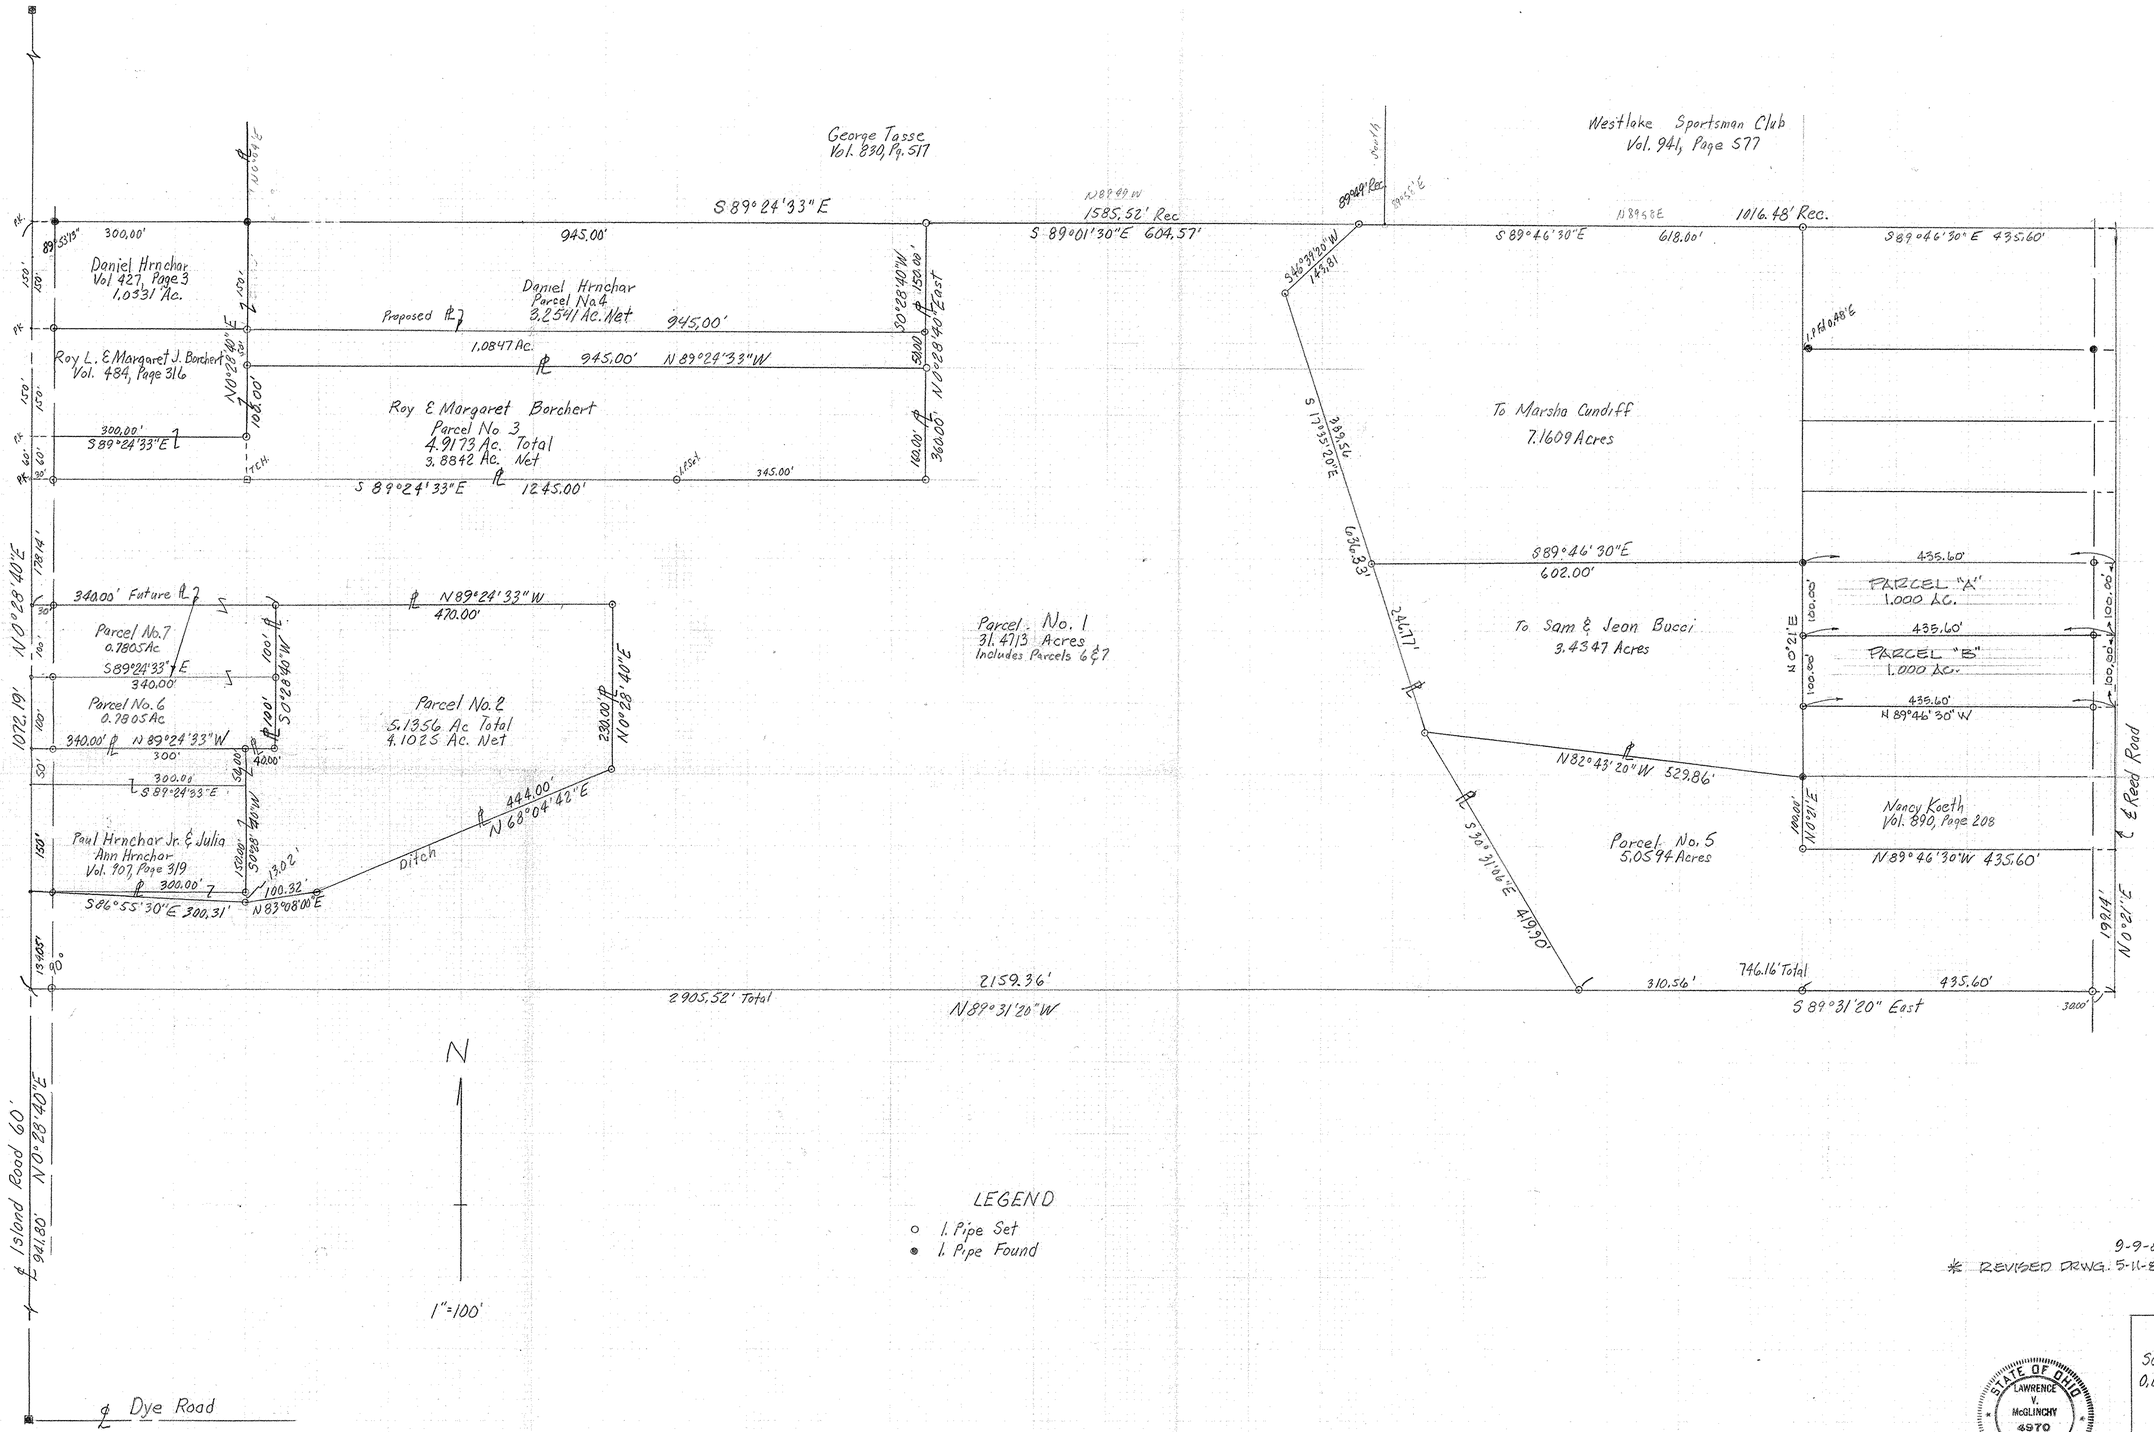

9-9-81 SPLIT HRNCHAR PARCEL 4
* REVISED DRWG. 5-11-81 (ADDED PARCELS "A" & "B")

STATE OF OHIO
LAWRENCE V. McGLINCHY
4970
REGISTERED SURVEYOR

PLAT OF SURVEY FOR
SUBDIVISION OF PAUL HRNCHAR PROPERTY
O.L. 29 EATON TWP. LORAIN COUNTY

McGLINCHY & ASSOCIATES
PROFESSIONAL ENGINEERS & SURVEYORS
110 ½ MIDDLE AVE. ELYRIA, OHIO
JOB No 75168 C SEPT. 1975