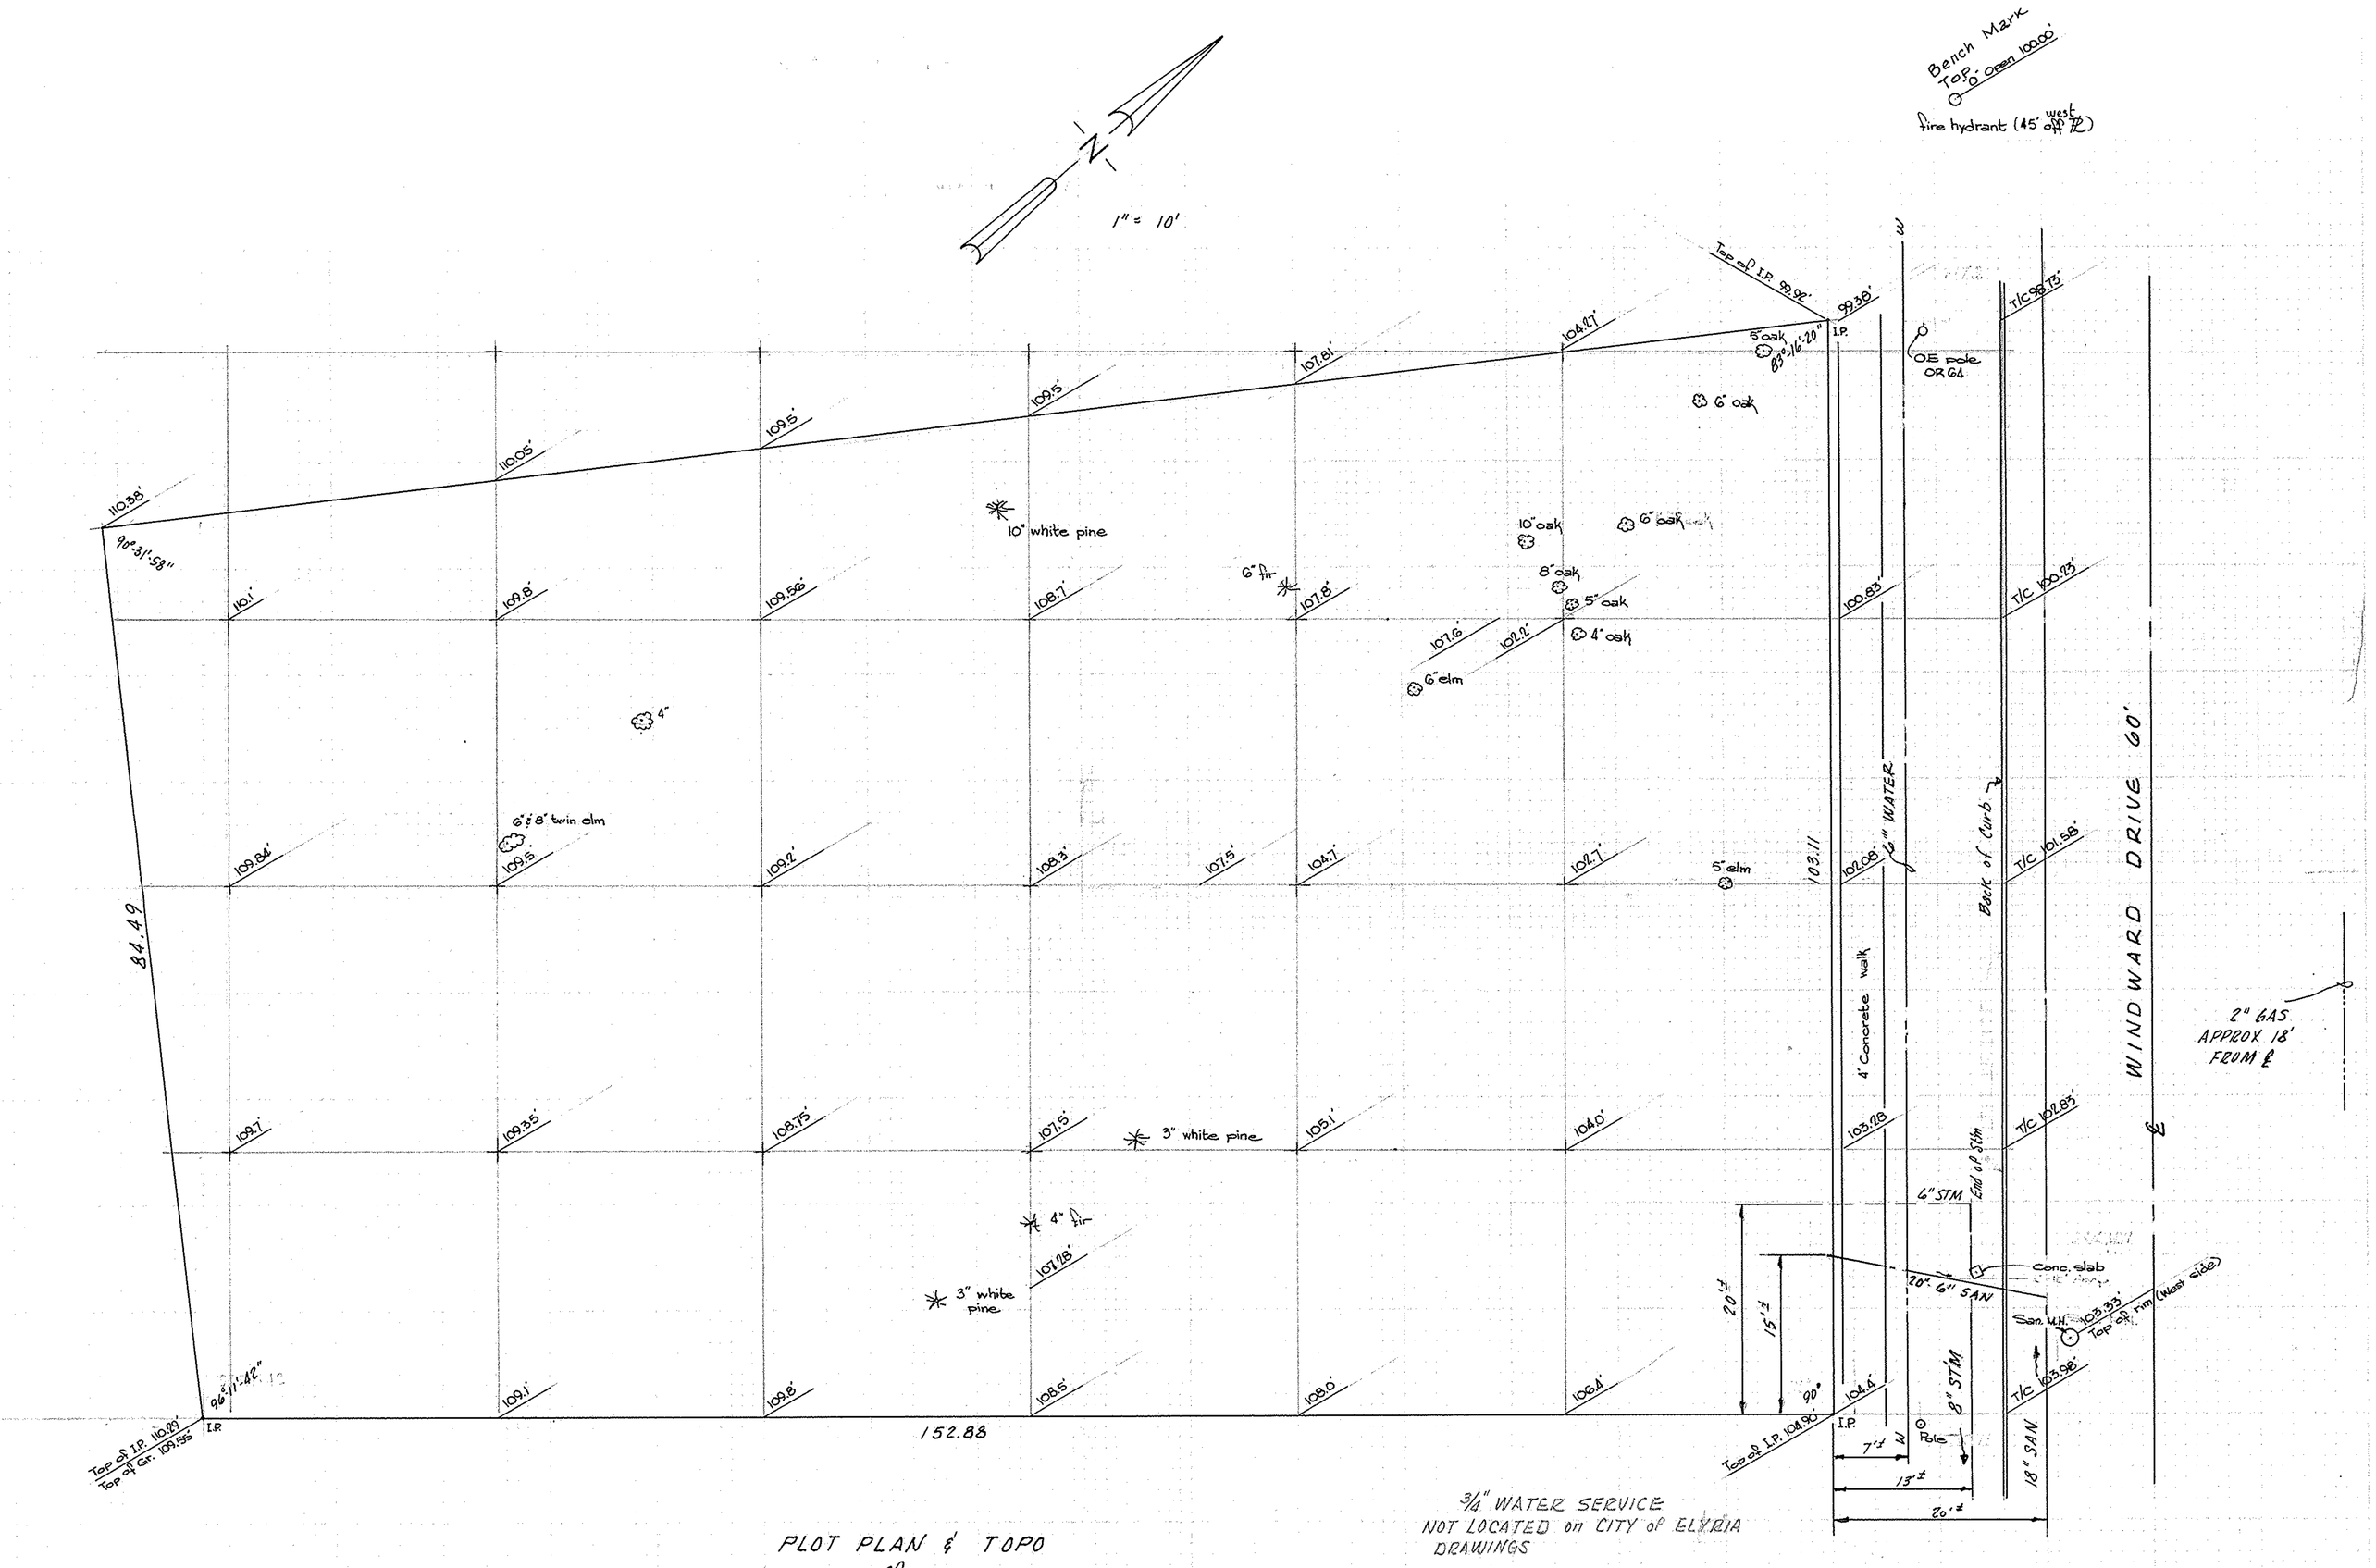

3/4" WATER SERVICE
NOT LOCATED on CITY of ELYRIA
DRAWINGS

PLOT PLAN & TOPO
of
SUBLOT #17 of BRIAR LAKE SUBD'N #2
PLAT VOL. 23, PG. 80
ELYRIA, OHIO

FOR JOSEPH MECKLER &
LANDIG & WYKOFF - ARCHITECTS
LORAIN COUNTY SAVING & TRUST BLDG
ELYRIA, OHIO

McGLINCHY & ASSOCIATES
MAY 6, 1976 #76884