

F & Durkee Road

Elmer Balogh
Vol. 963, Page 187

0° South 3520.75'

25.64 Ac. O.L. 76

108.0005 Acres Total
82.36 Ac O.L. 65


0° North 3511.02'

1380.66 Rec.
John G. & Lynn Nasse
Vol. 1064, Page 900

0° N 3511.02'

Eaton Auto Wrecking
Vol. 1067, Page 61

- 1. Pipe Set
- 1' Pipe Found & Used
- State Monument Found & Used (58' South & R/W)

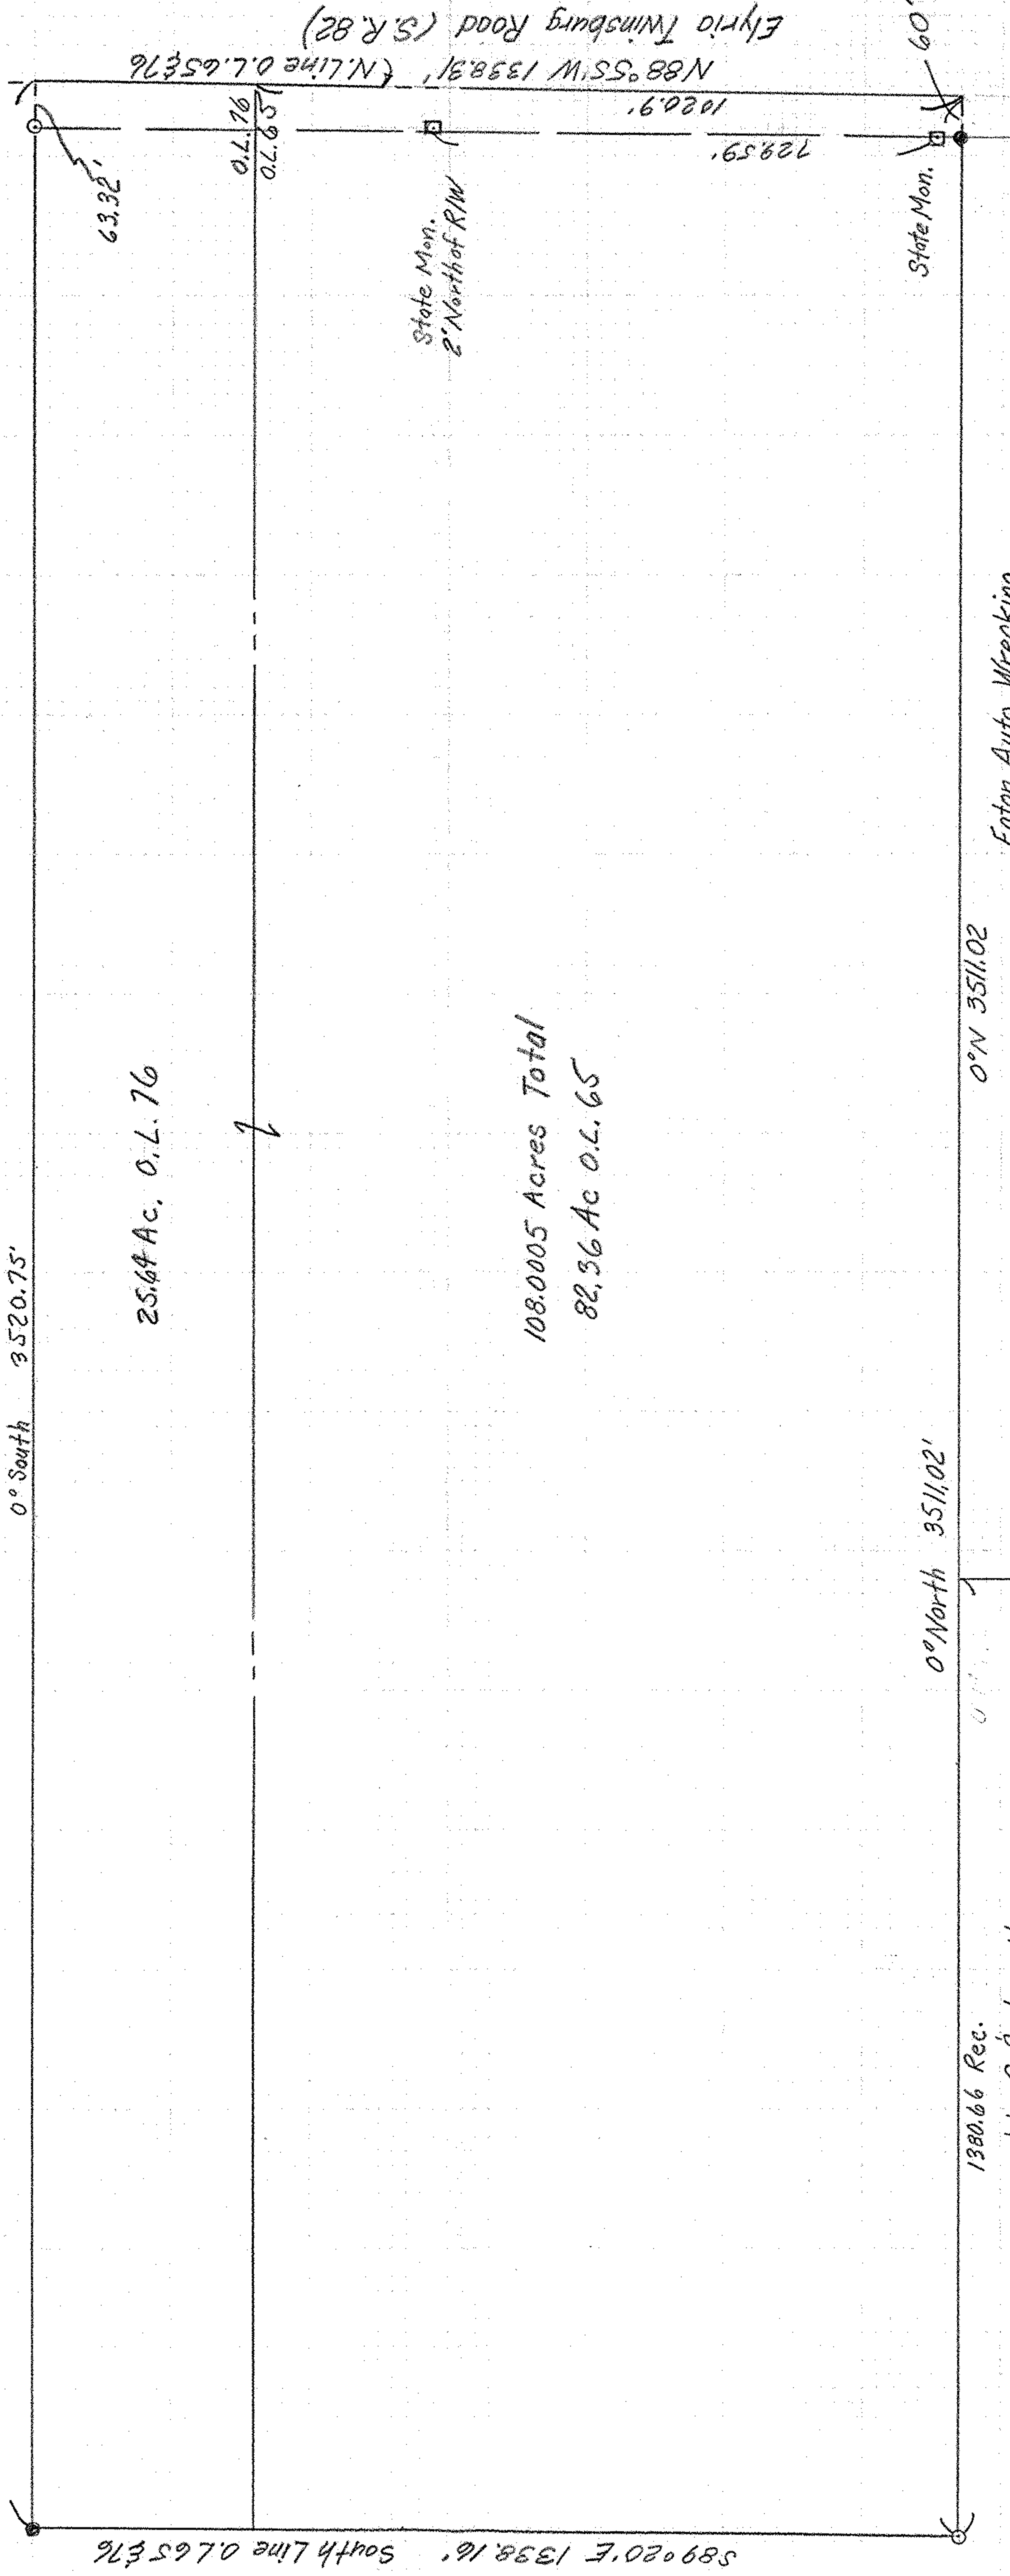

Elyria Twinsburg Road (S.R. 82)



1020.91'

728.59'

60'

State Mon.

State Mon.
2' North R/W

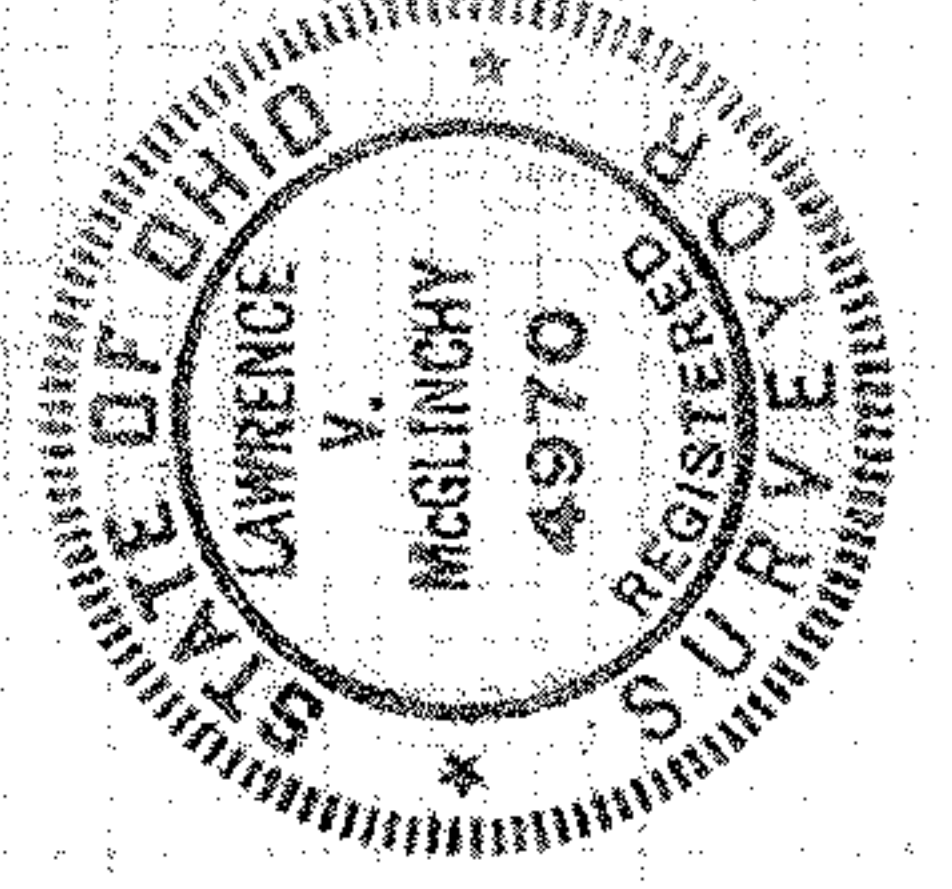

MAP OF SURVEY FOR
 WALTER L. HYLE
 0.465 & 76, EATON TWR
 LORAIN COUNTY, OHIO

McGLINCHY & ASSOCIATES
 538 W. BROAD ST. ELYRIA, OHIO
 Job No. 75248 1"=200'
 PROFESSIONAL ENGINEER & SURVEYOR