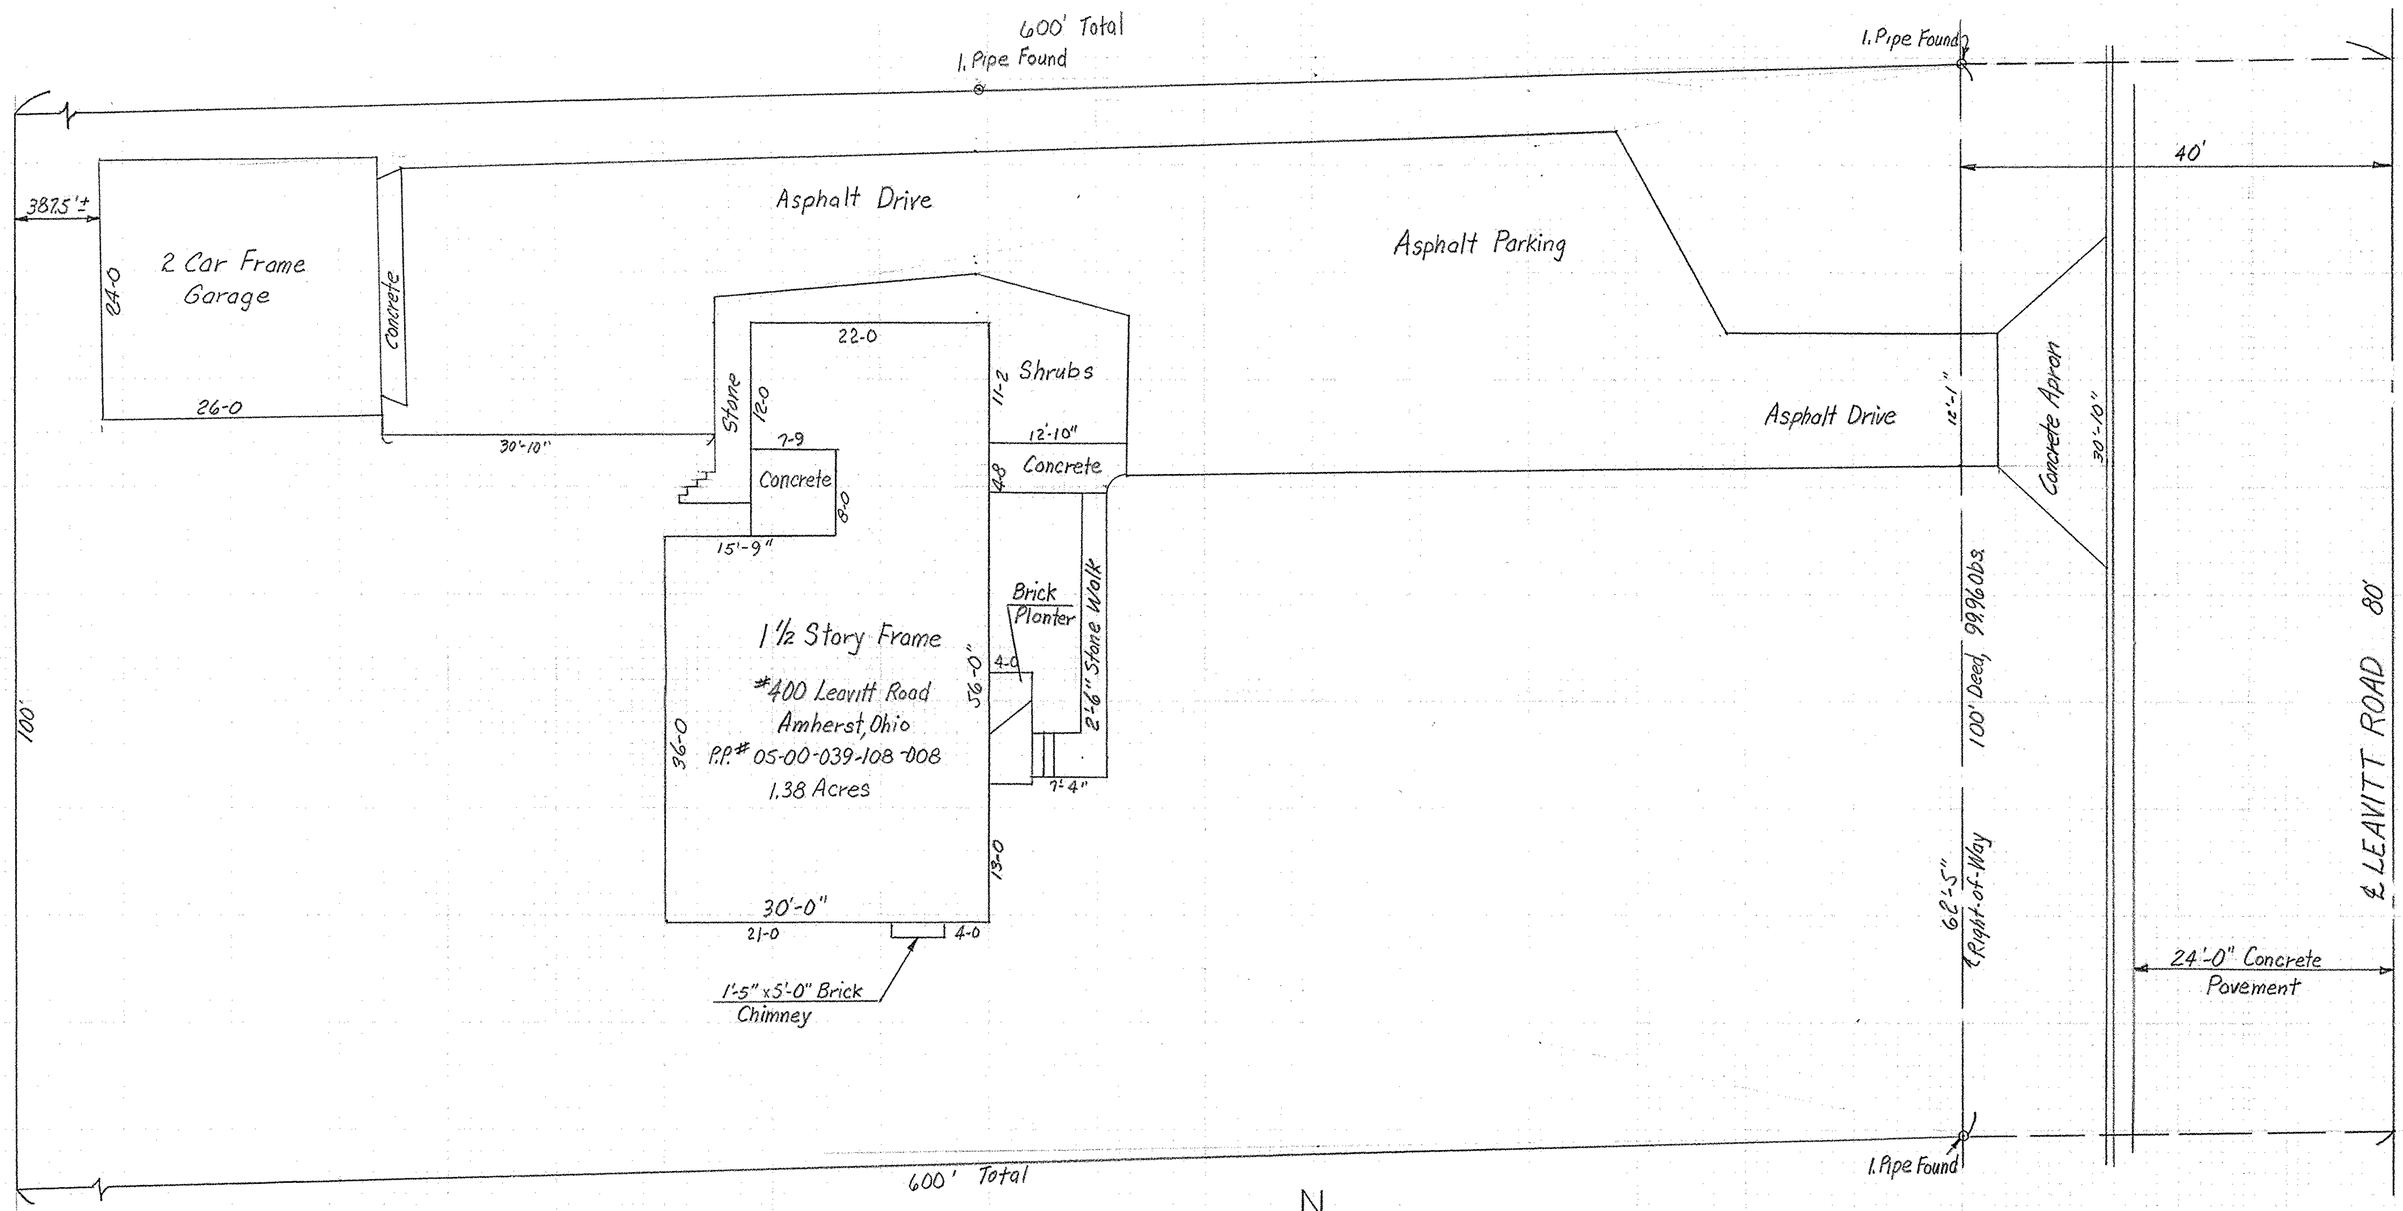

STATE OF OHIO
LAWRENCE V. McGLINCHY
4970
REGISTERED SURVEYOR

LIMITED TOPOGRAPHY

LEHMAN-JOHNSON-YOUNG
CORPORATION
138 Middle Ave. Elyria, Ohio

Prepared By
McGlinchy & Associates
538 W. Broad Street Elyria, Oh.
Job No 75511 Sept. 22, 1975
Professional Engineers & Surveyors