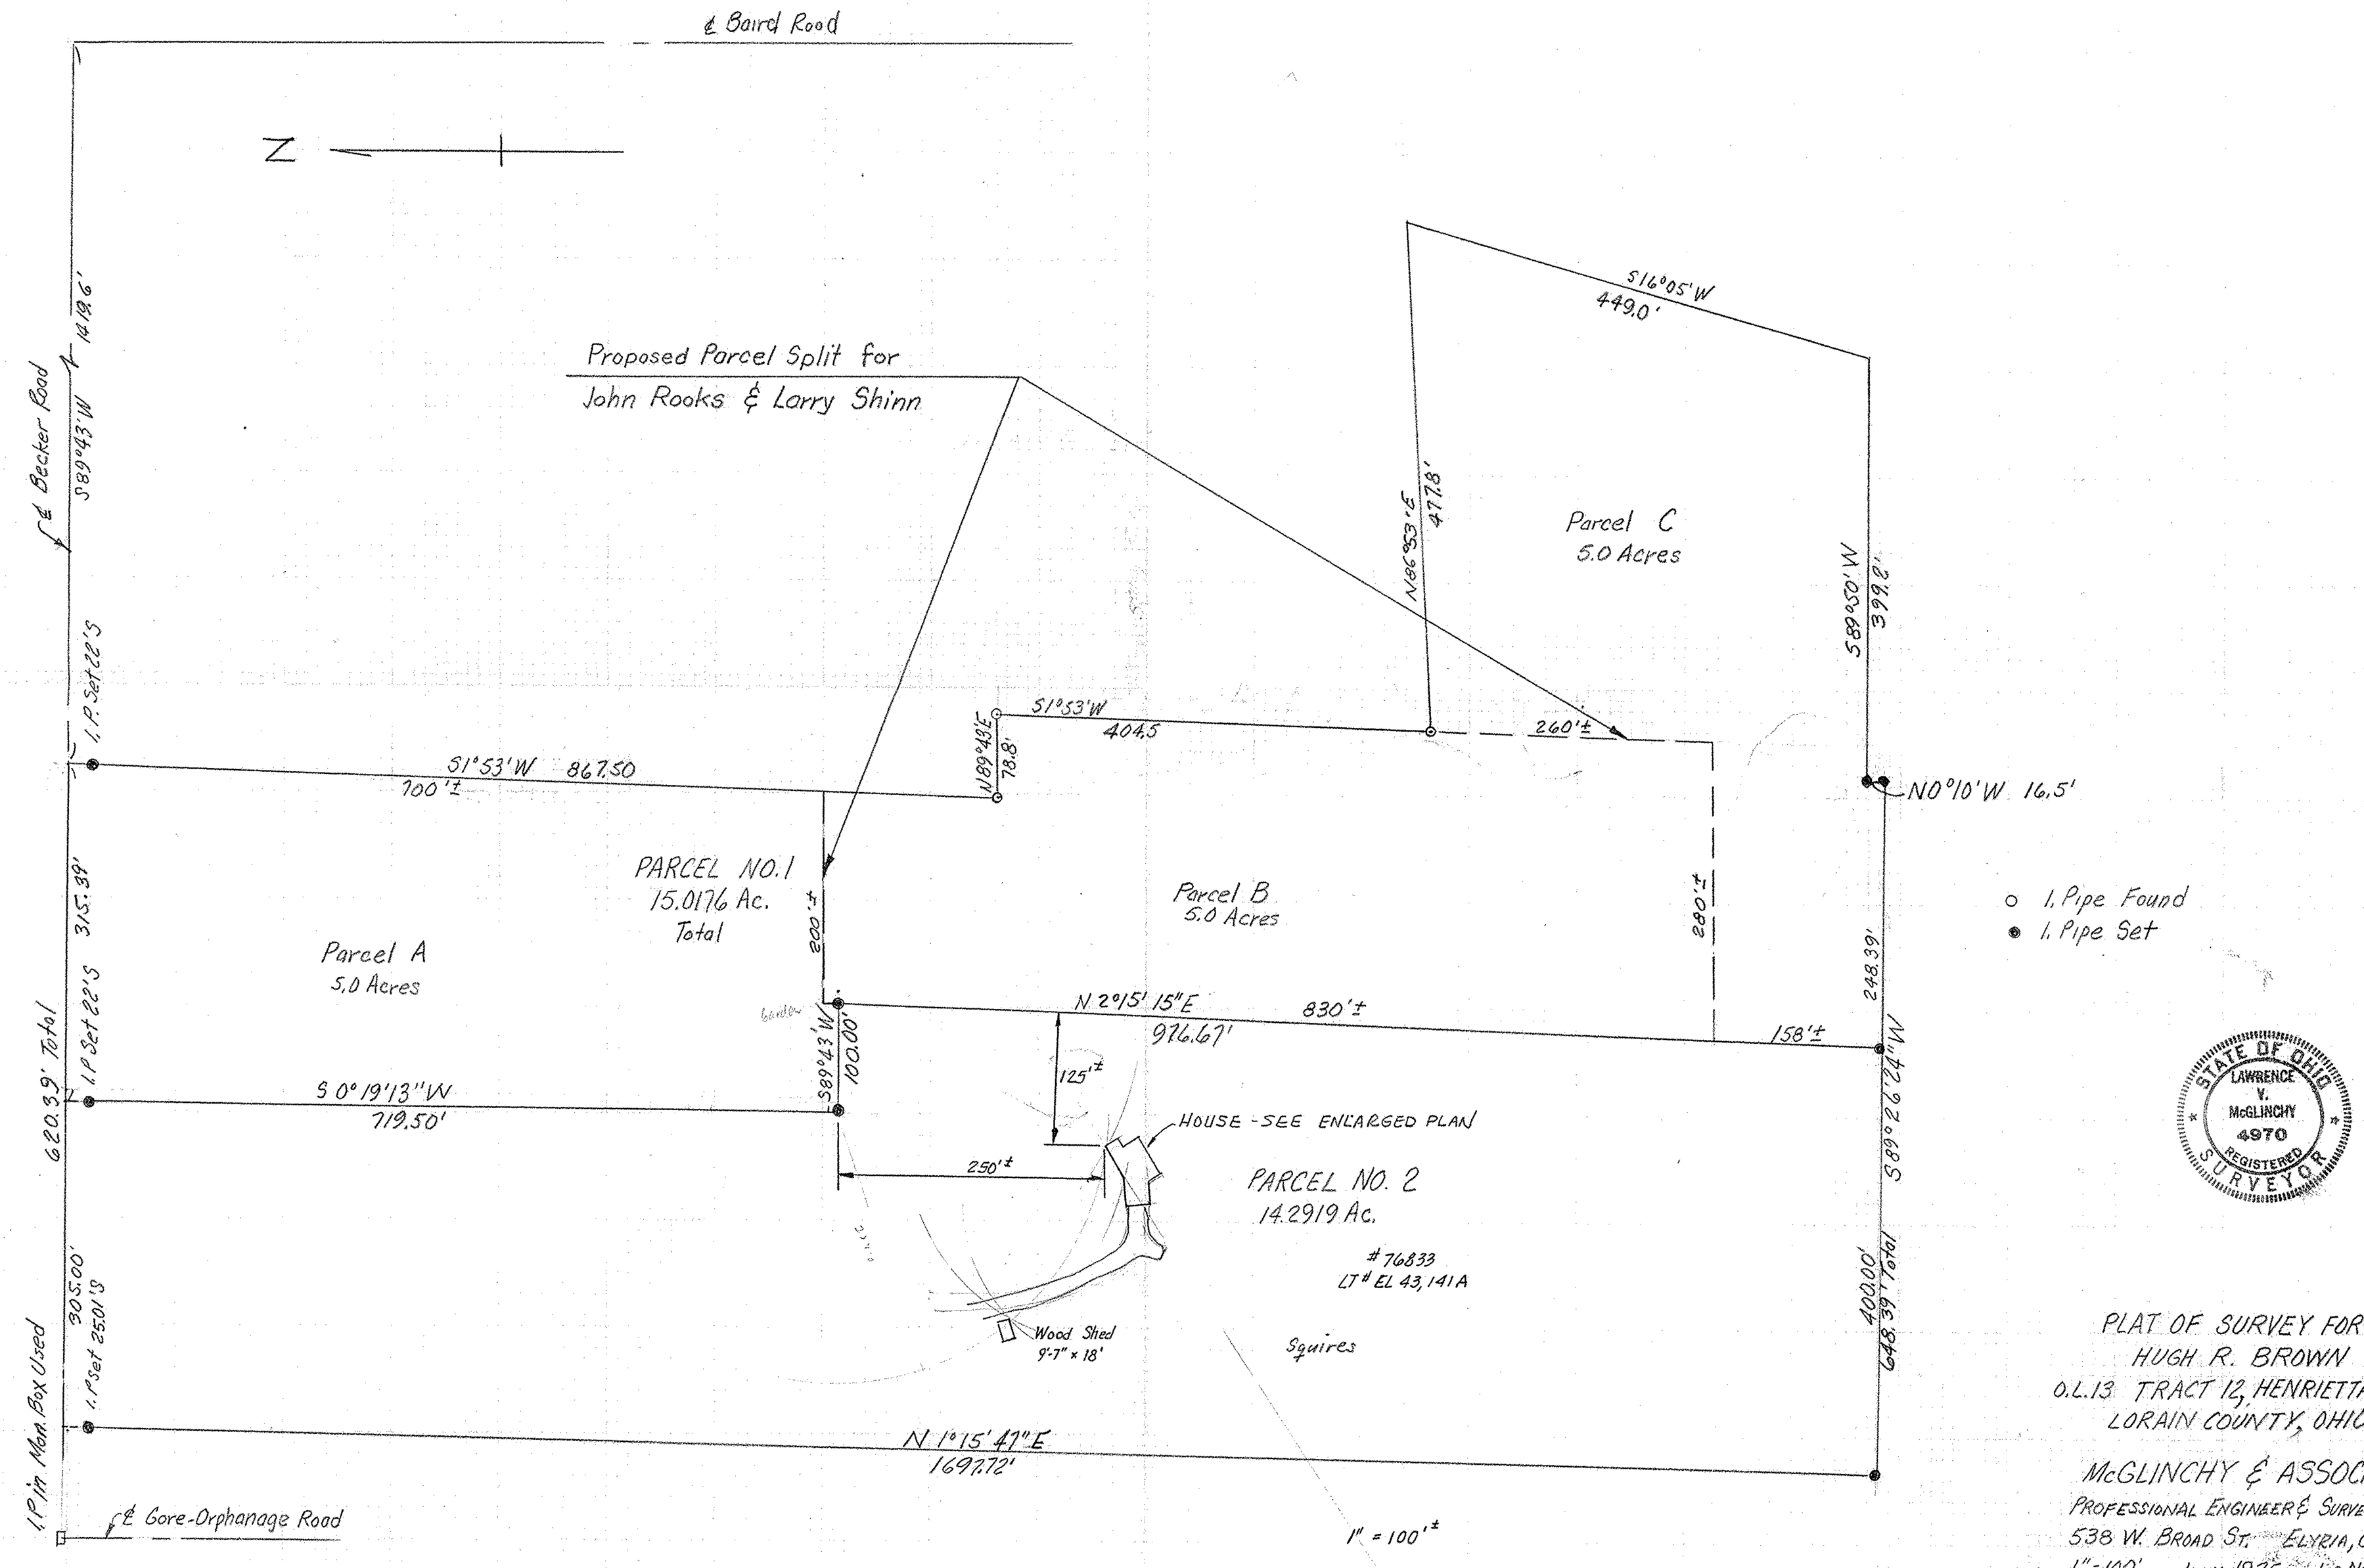

PLAT OF SURVEY FOR
HUGH R. BROWN
O.L.13 TRACT 12, HENRIETTA TWP.
LORAIN COUNTY, OHIO

McGLINCHY & ASSOCIATES
PROFESSIONAL ENGINEER & SURVEYOR
538 W. BROAD ST. ELYRIA, OHIO
1"=100' JULY, 1975 JOB No 75377
ADDED ESMT SEPT 9, 1975 75491