SUBLOTS 8, 9, 10, 43 OF LAUNDON ALLOTMENT
LORAIN COUNTY PLAT VOL. 8, PG 1
PART OF ORIG. LOT'S 77 & 78 - EAST OF RIVER
LOCATED IN CITY OF ELYRIA, OHIO

S.L. 8	- P.P. # 06-25-077-102-002	DEED VOL. 670	PG 489
S.L. 9	" " -003	" " 600	" 52
S.L. 10	" " -004	" " 511	" 75
S.L. 43	" " -007	" " 891	" 363

LOCATION PLAN
SCALE: 1" = 1000'

TOPOGRAPHIC SURVEY & PLOT PLAN
FOR
FRIENDLY ICE CREAM CORPORATION

1855 BOSTON ROAD
WILBRAHAM, MASSACHUSETTS
& CHICAGO TITLE INSURANCE COMPANY
BY

McGLINCHY & ASSOCIATES
538 W. BROAD ST.-SUITE 403
ELYRIA, OHIO 44035
PROJECT 75209 MAR 26, 1975 DLI

STATE OF OHIO — LAWRENCE V. McGLINCHY 4970 — REGISTERED SURVEYOR

STATE OF OHIO — LAWRENCE V. McGLINCHY 27501 — REGISTERED PROFESSIONAL ENGINEER

THIS SURVEY IS TO BE CERTIFIED TO FRIENDLY ICE CREAM CORPORATION AND ANY TITLE INSURANCE CO OF FRIENDLY ICE CREAM CORP'S CHOOSING.

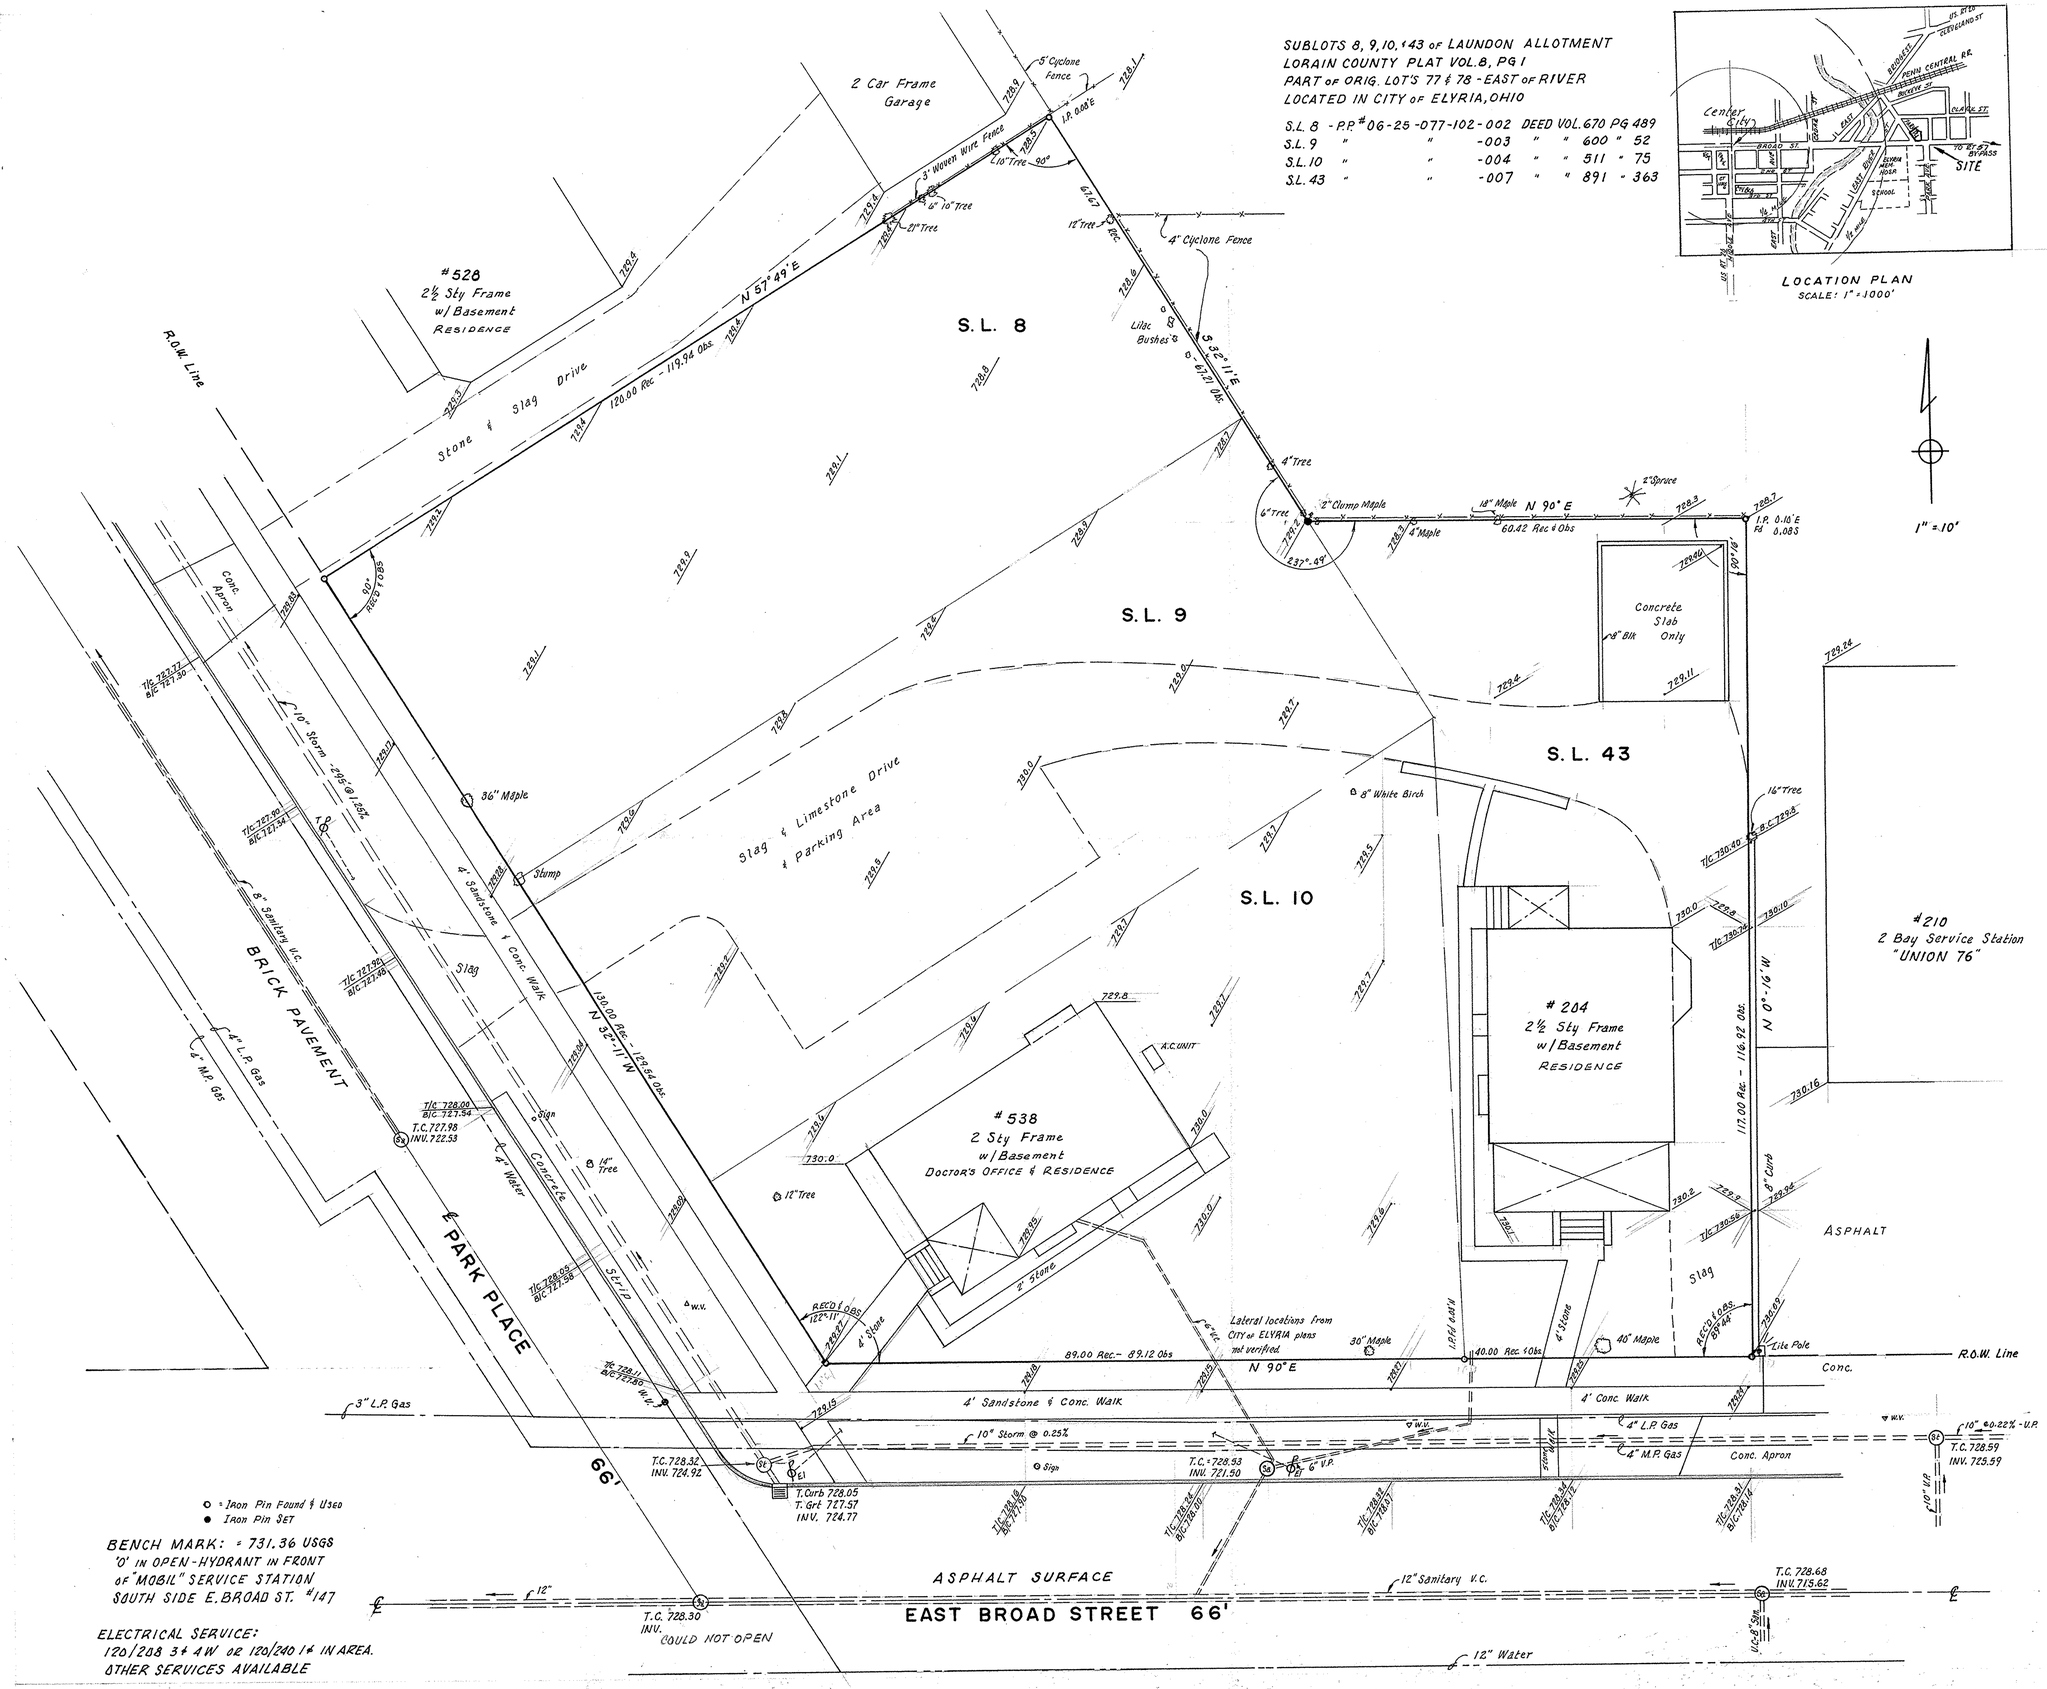

○ = Iron Pin Found & Used
● Iron Pin Set

BENCH MARK: = 731.36 USGS
'0' IN OPEN-HYDRANT IN FRONT
OF "MOBIL" SERVICE STATION
SOUTH SIDE E. BROAD ST. #147

ELECTRICAL SERVICE:
120/208 3φ 4W OR 120/240 1φ IN AREA.
OTHER SERVICES AVAILABLE