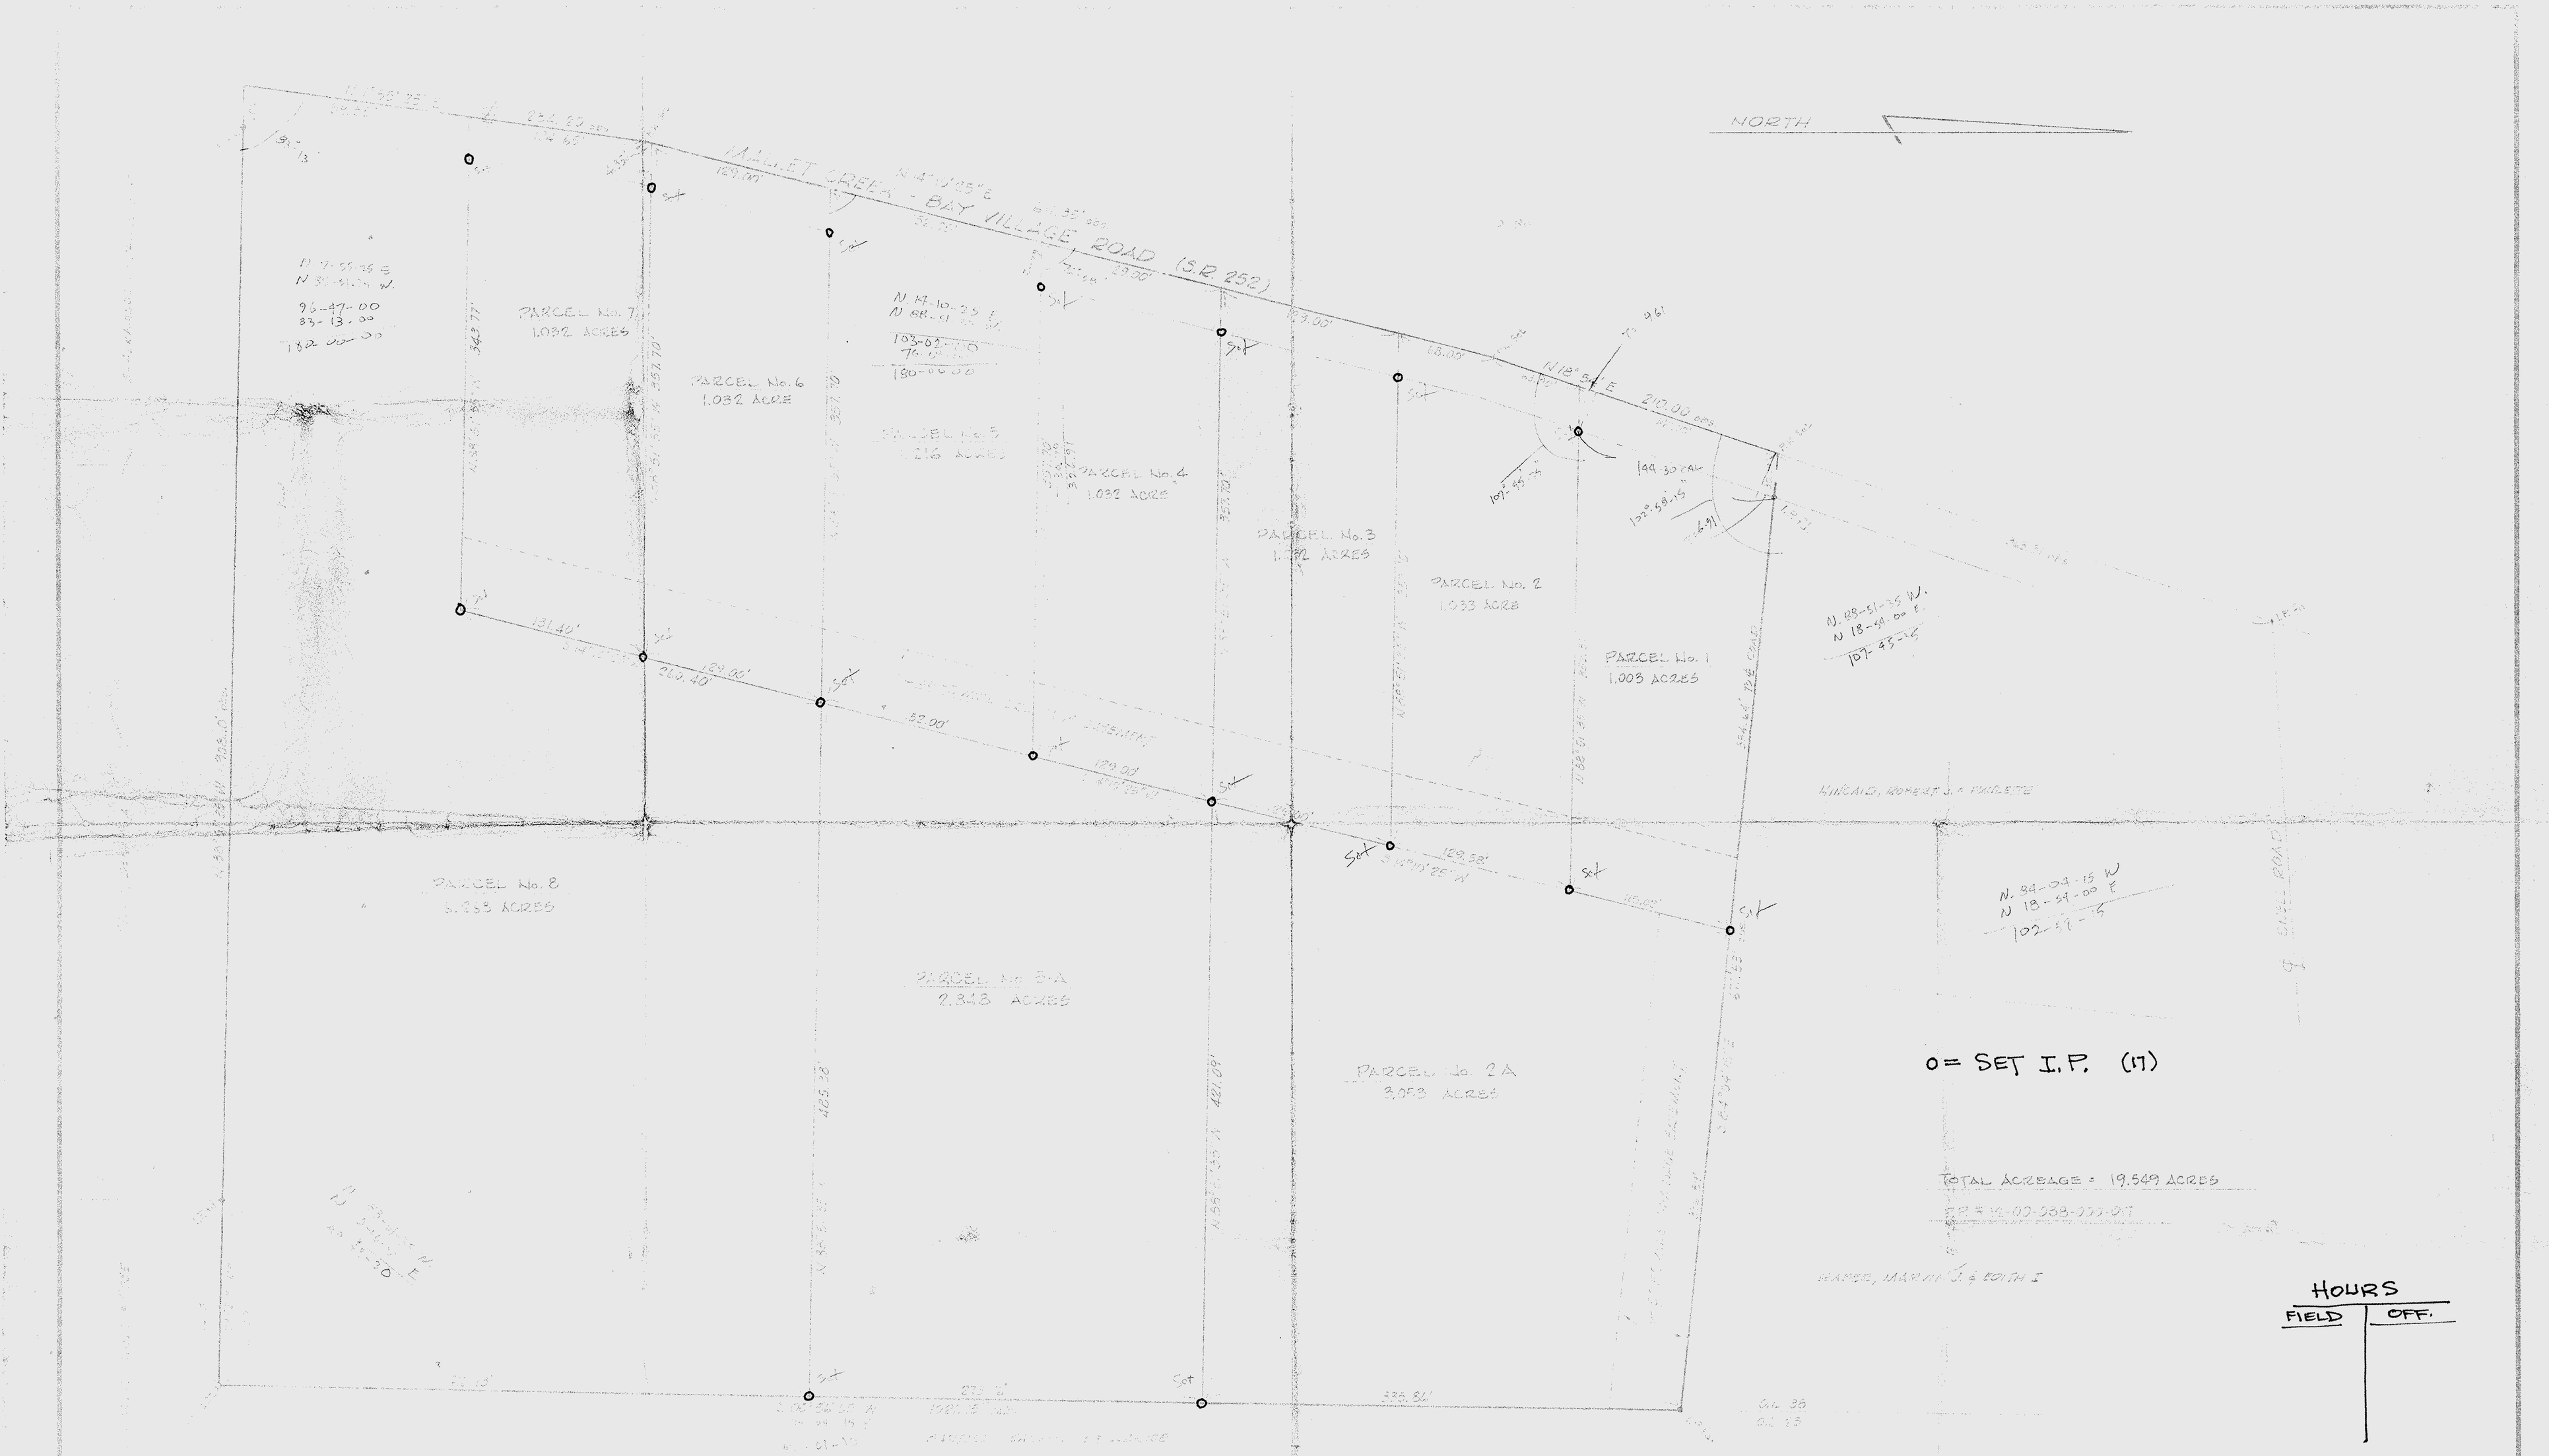

MAP of SURVEY & PROPOSED PARCEL SPLIT

PREPARED FOR

MOR-VALUE HOMES INC. (KENNETH MORRISON)

PART of ORIGINAL COLUMBIA TOWNSHIP LOT 38

COLUMBIA TOWNSHIP LORAIN COUNTY OHIO

McGINCHY AND ASSOCIATES

PROFESSIONAL ENGINEERS AND SURVEYORS

538 WEST BROAD ST ELYRIA, OHIO

SCALE: 1" = 50' DRAWN BY: BOB

DATE: 2-16-78 JOB NO: 782930

REV. 2-27-78