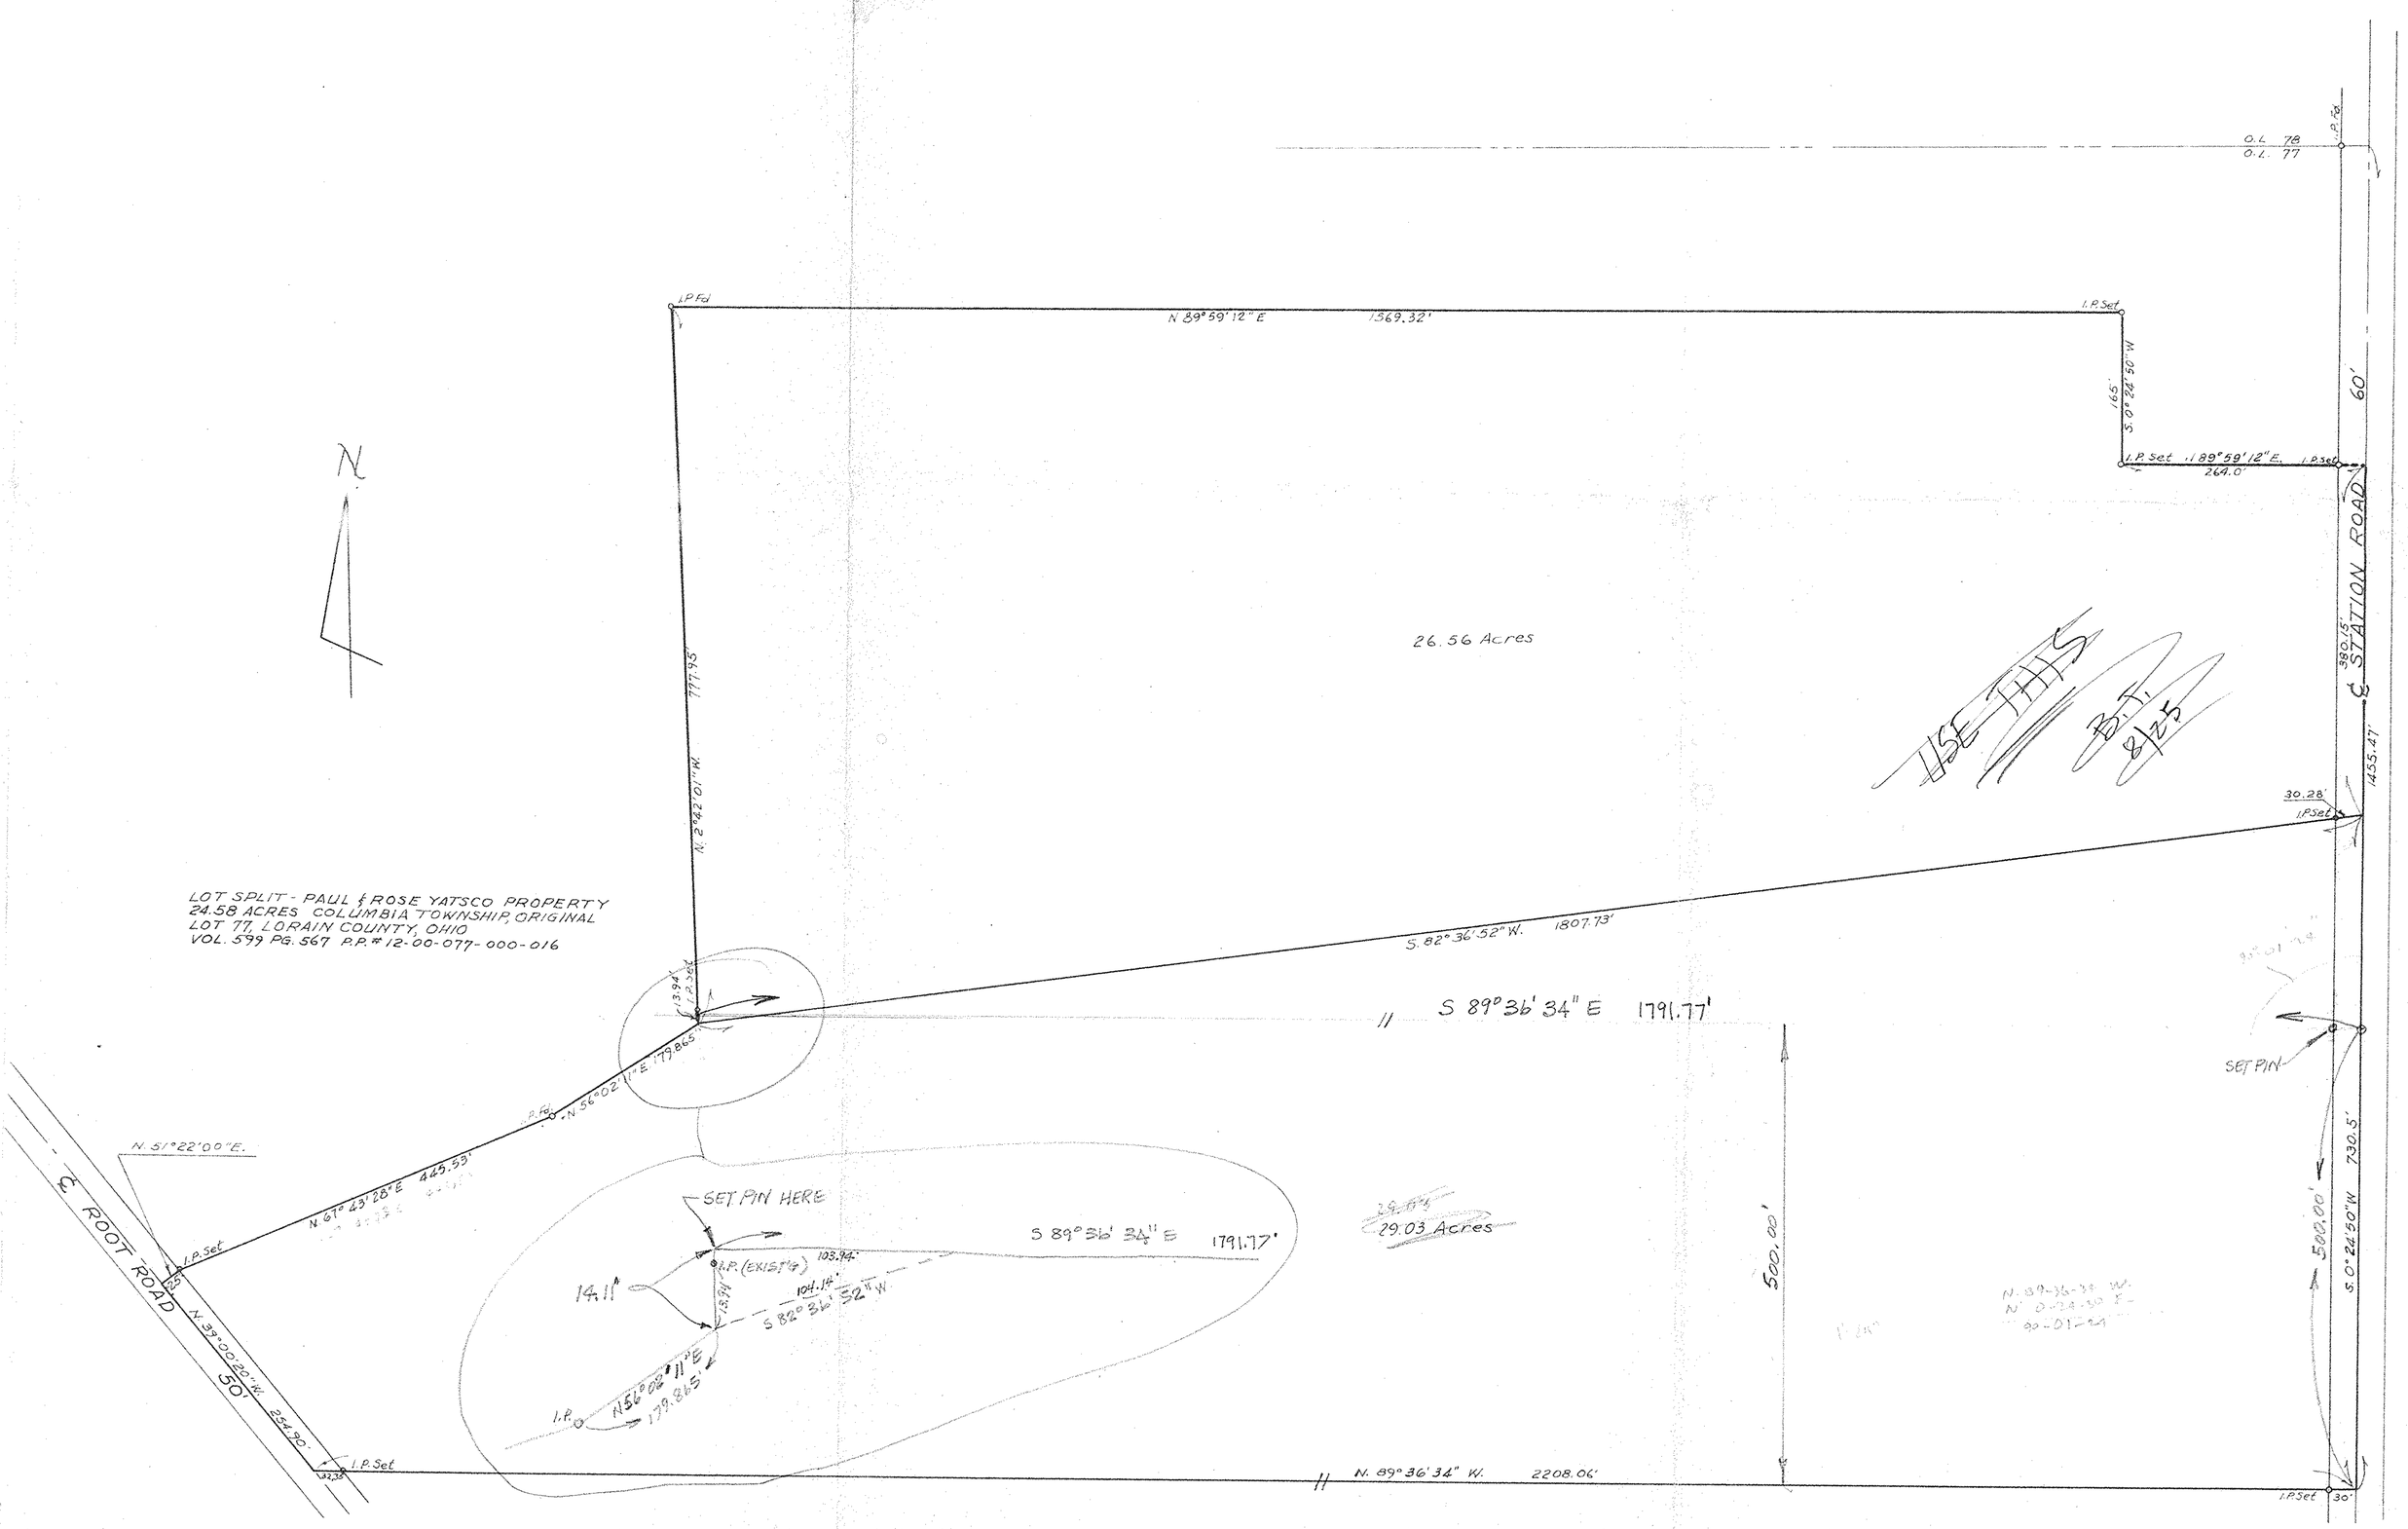

McGLINCHY & ASSOCIATES
DECEMBER 22 1976 #76 1403