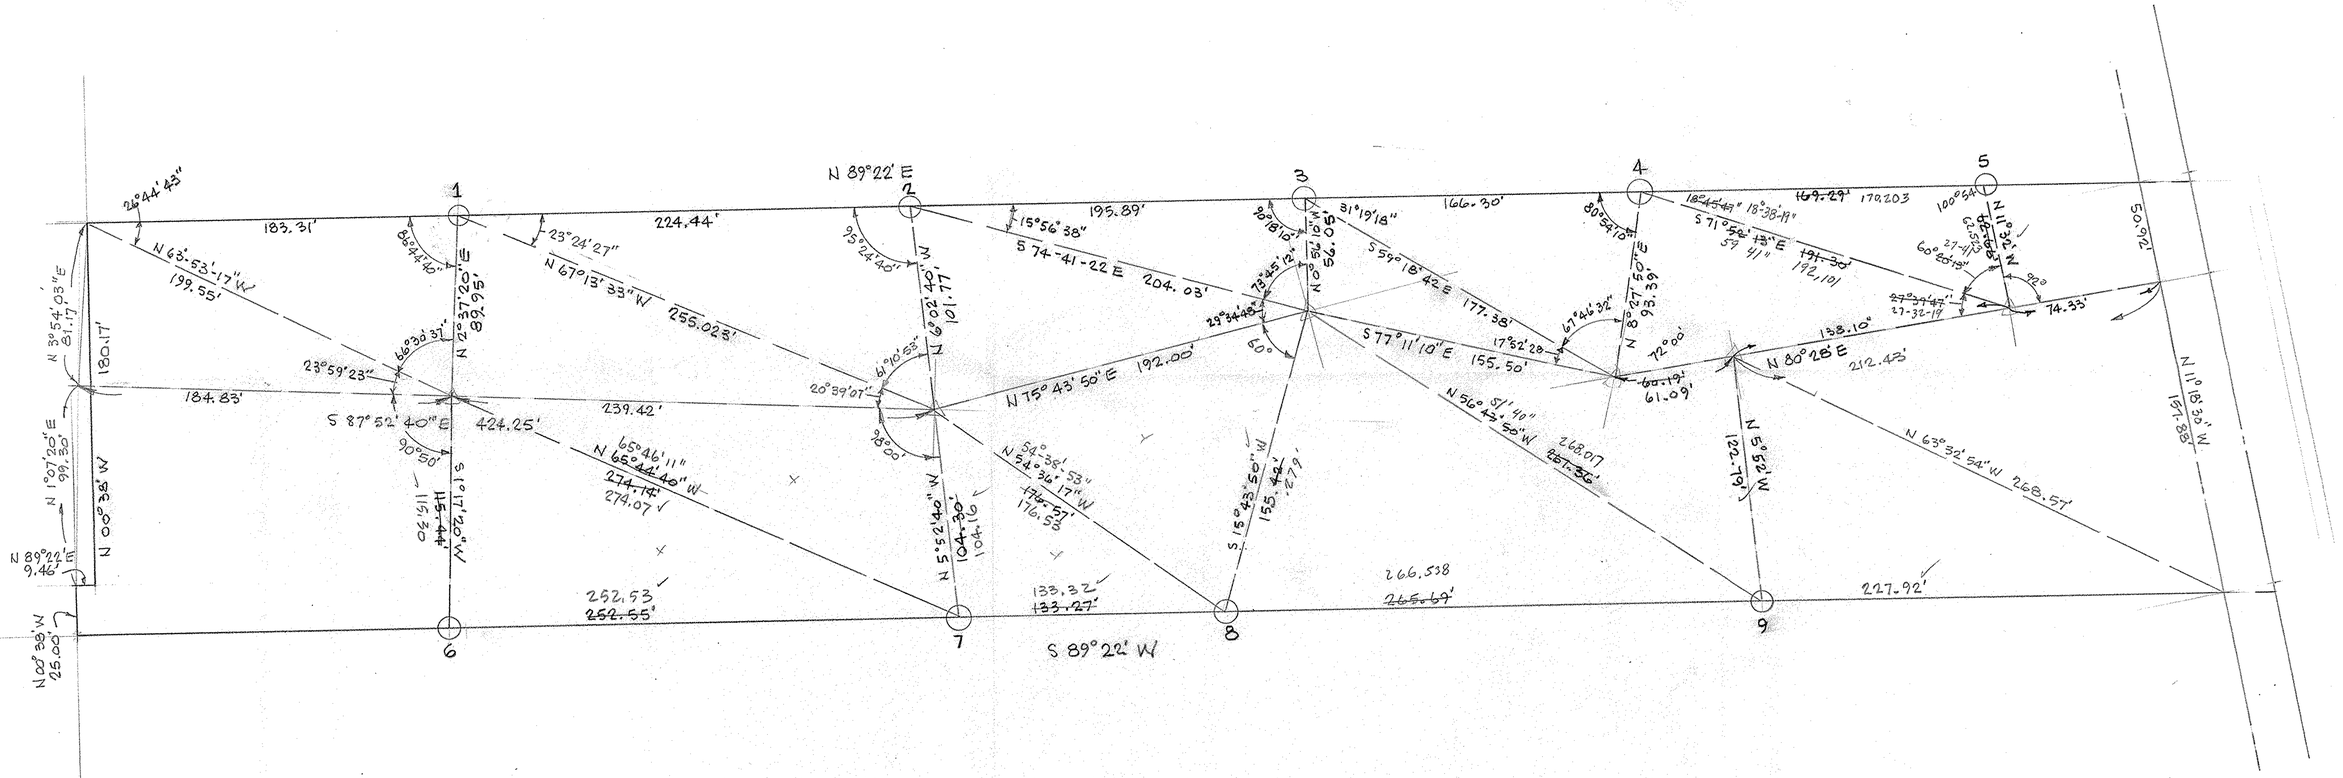
1
2
3
4
5
6
7
8
9
N 89°22' E
S 89°22' W
26°44'43"
183.31'
N 63°53'17" W
199.55'
N 39°54'03" E
81.17'
180.17'
N 00°38' W
N 1°07'20" E
99.30'
N 89°22' E
9.46'
N 00°38' W
25.00'
23°24'27"
224.44'
N 67°13'33" W
255.028'
N 2°37'20" E
89.95'
23°59'23"
184.83'
S 87°52'40" E
424.25'
239.42'
90°50'
S 1°17'20" W
115.20
115.44'
N 65°46'11"
274.14'
274.07
252.53
252.55'
N 89°22' E
15°56'38"
195.89'
S 74°41'22" E
204.03'
95°24'40"
N 2°02'40" W
101.77'
20°39'07"
N 75°43'50" E
192.00'
98°00'
N 5°52'40" W
104.30'
104.16
54°36'53"
N 54°36'17" W
176.37'
176.52
133.32
133.27'
S 15°43'50" W
155.42'
155.279'
266.538
265.69'
S 10°52'10" W
56.
31°19'18"
166.30'
S 59°18'42" E
177.38'
S 77°11'10" E
155.50'
N 56°43'50" W
268.017
267.36'
N 8°27'50" E
93.39'
67°46'32"
72°00'
60.19'
61.09'
N 5°52' W
122.79'
N 80°28' E
212.43'
N 63°32'54" W
268.57'
227.92'
170.203
169.29'
S 71°58'13" E
192.101
191.30'
100°54'
N 1°32' W
62.23
60°00'13"
27°37'47"
27-32-19
92°
74.33'
138.10'
50.92'
N 11°18'30" W
197.88'