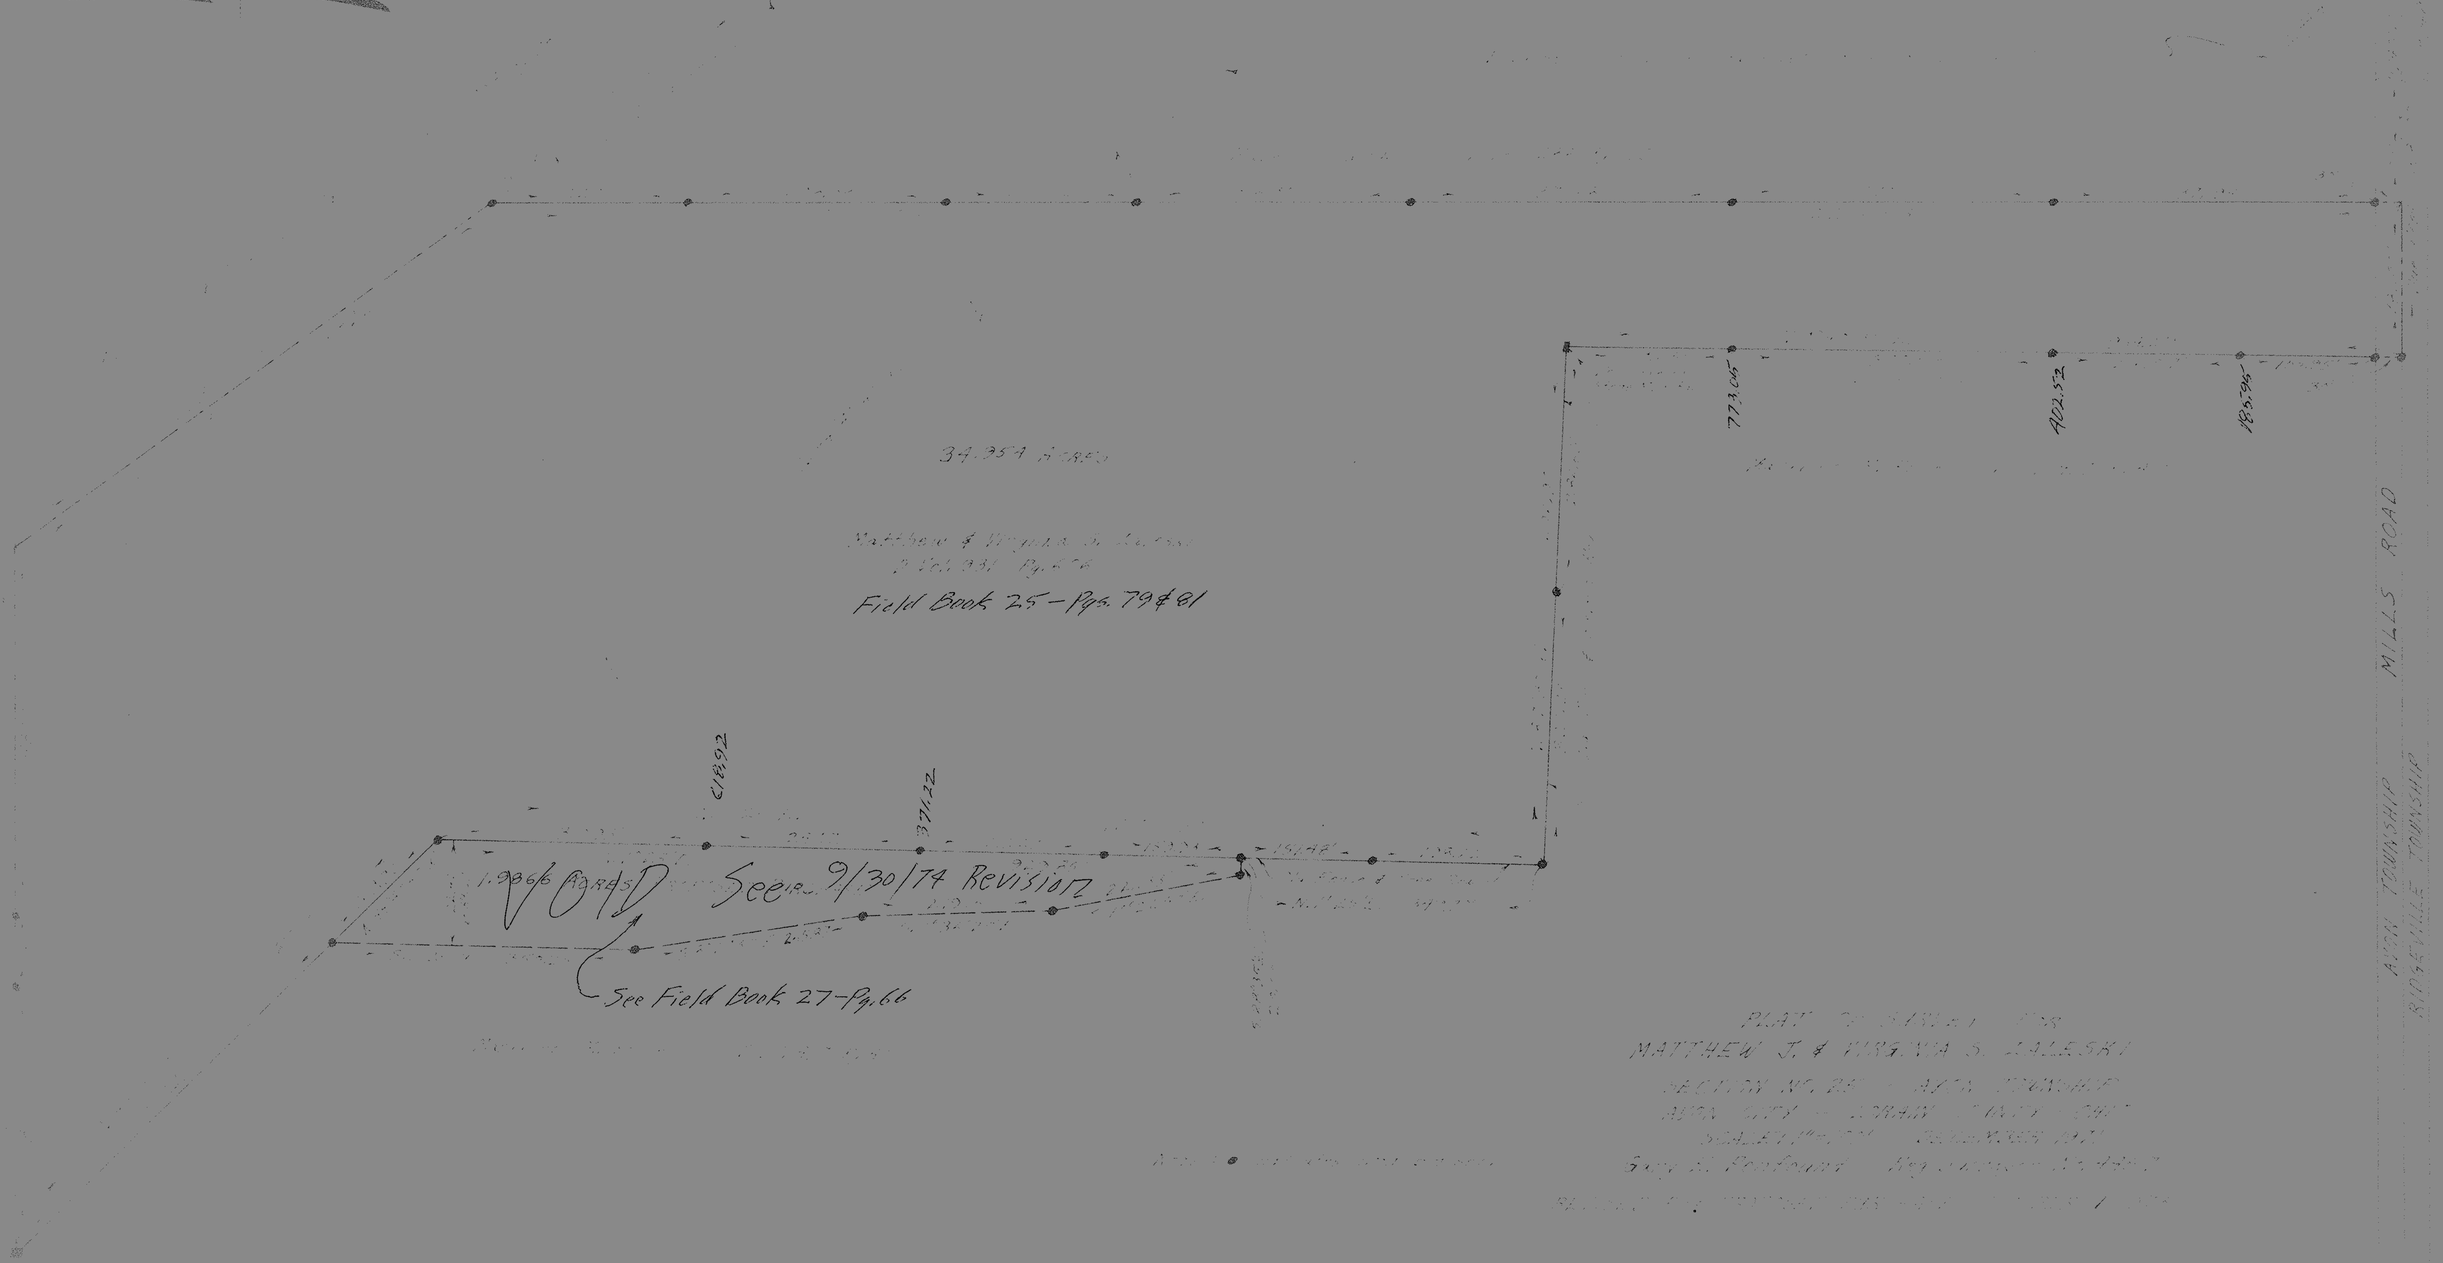
34.954 ACRES
Field Book 25 - Pgs. 79 & 81
618.92
371.22
See 9/30/74 Revision
See Field Book 27 - Pg. 66
773.06
402.52
186.96
MILLS ROAD
AVON TOWNSHIP
PLAT
MATTHEW J. & VIRGINIA S. LALESKI