HOY-LO-MAE ALLOTMENT

6TH. ADDITION
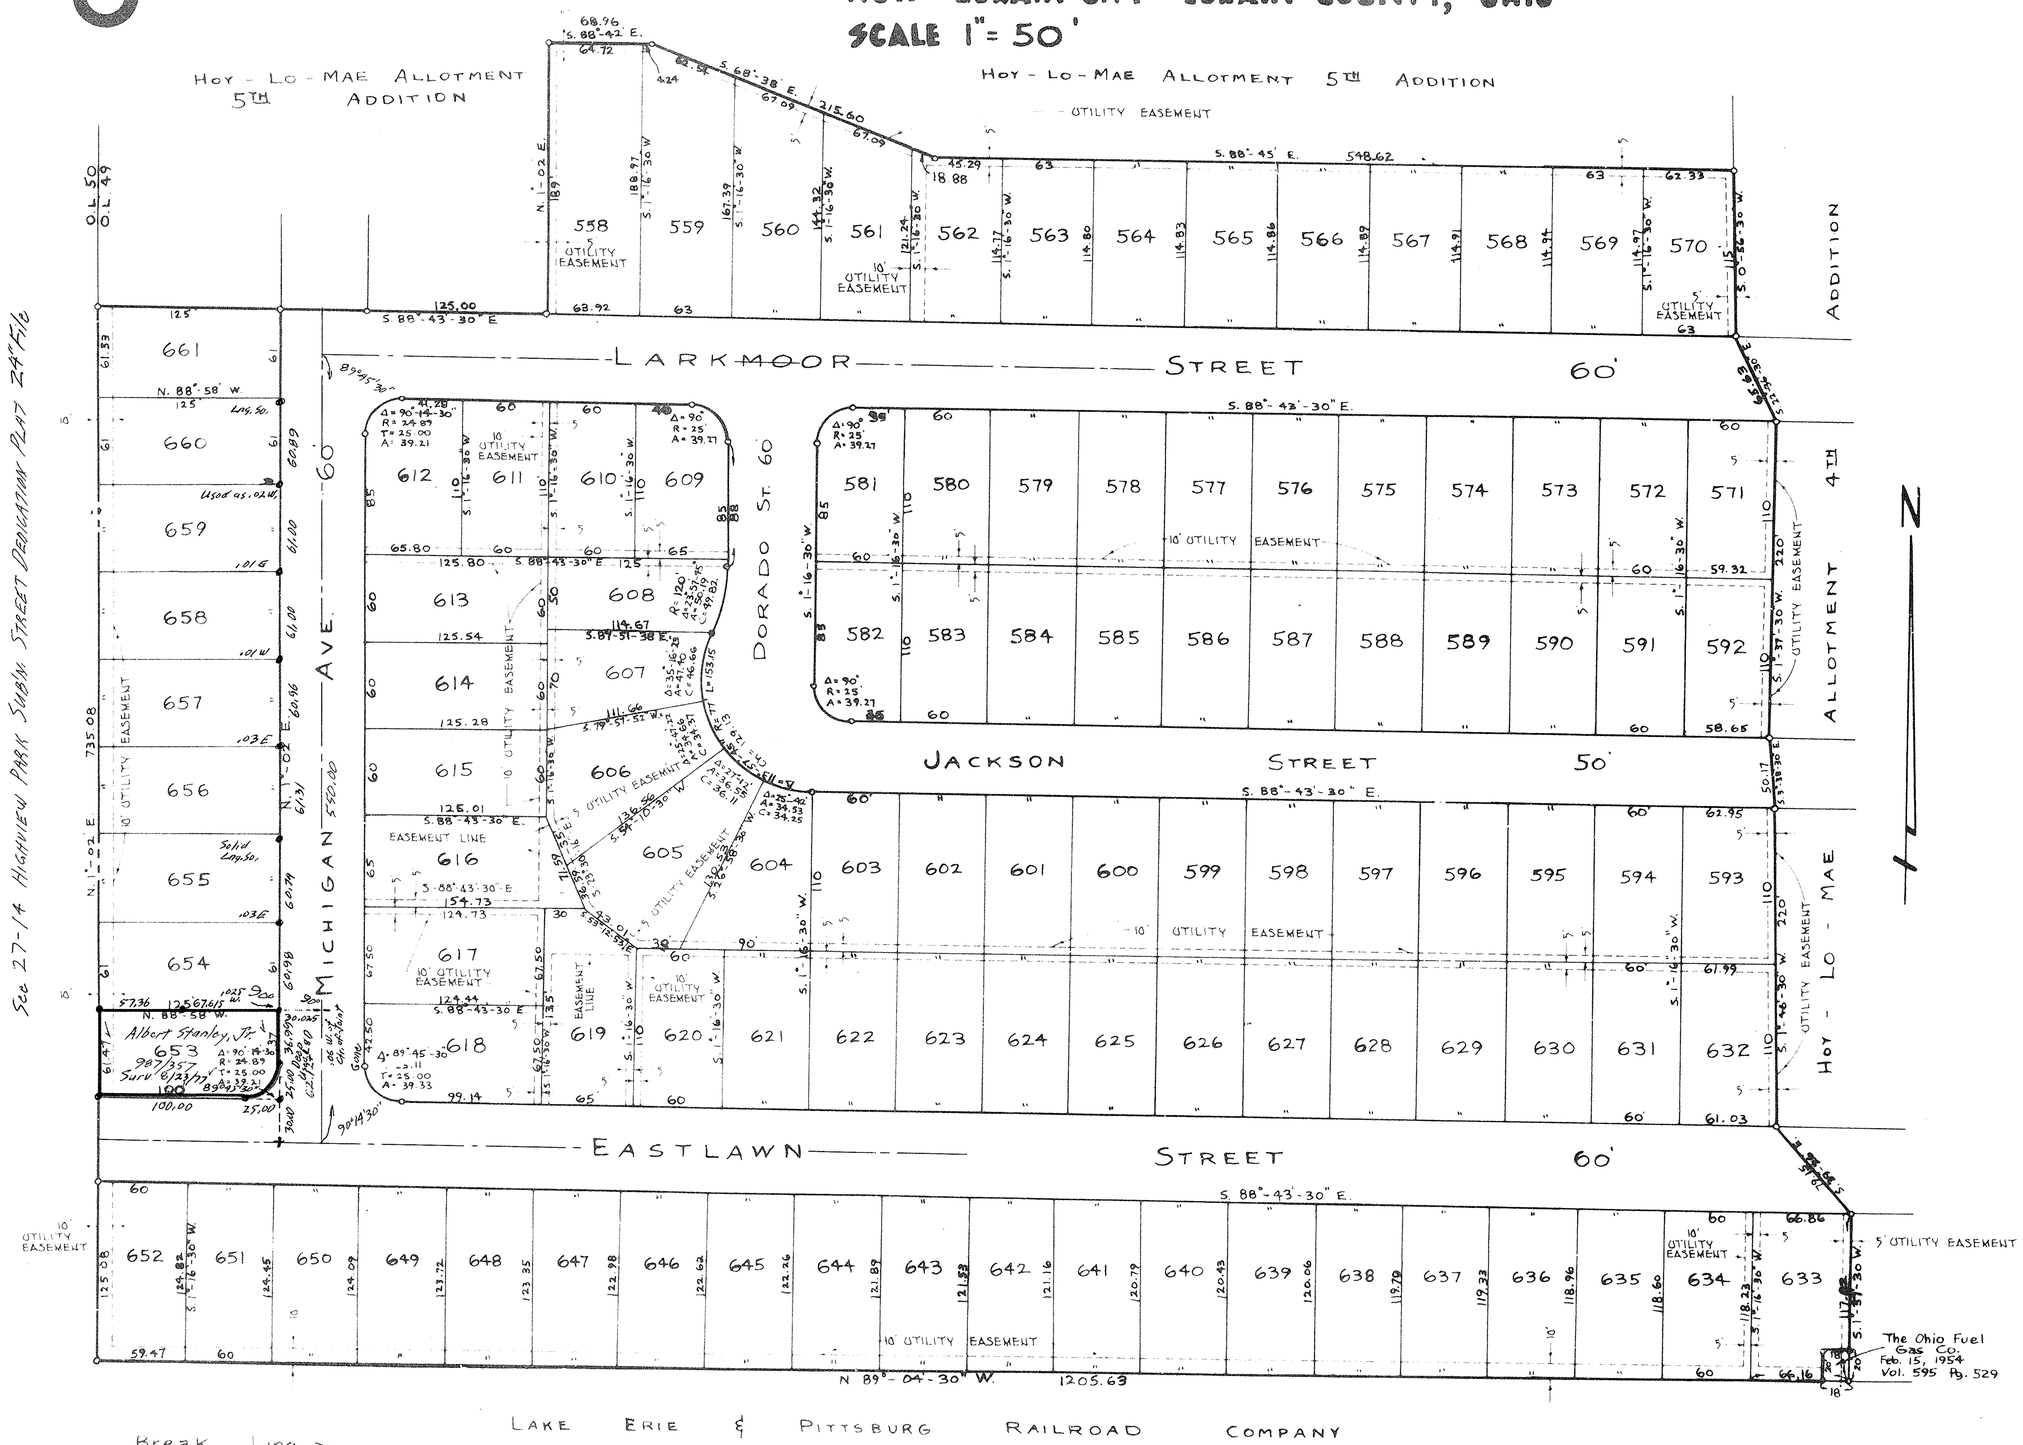
PART OF ORIGINAL LOT #49 - SHEFFIELD TWP.,
NOW LORAIN CITY - LORAIN COUNTY, OHIO
SCALE 1" = 50'