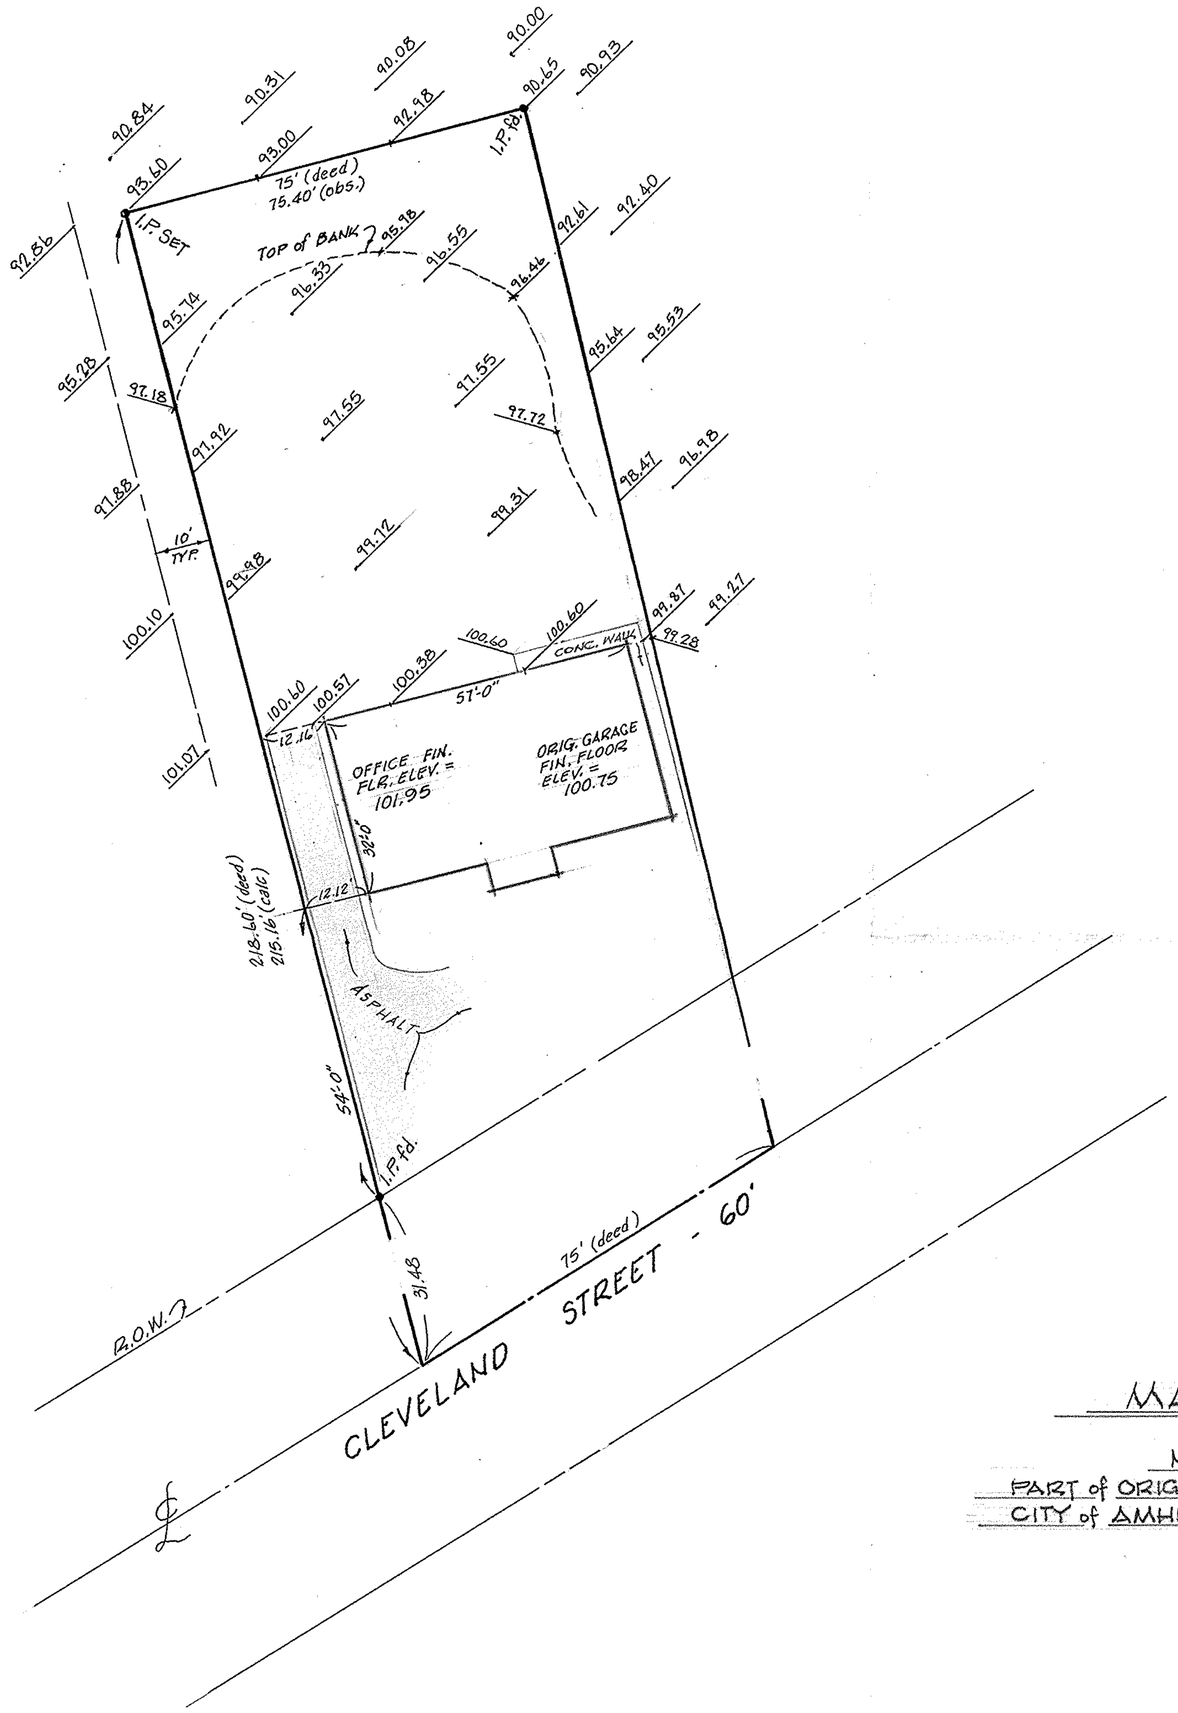

MAP of SURVEY

PREPARED FOR
NORDSON CORP.
PART of ORIGINAL AMHERST TWP. LOT No. 38
CITY of AMHERST, LORAIN COUNTY, OHIO

McGLINCHY and ASSOCIATES
PROFESSIONAL ENGINEERS and SURVEYORS
ELYRIA, OHIO

OCTOBER, 1977 JOB# 772695