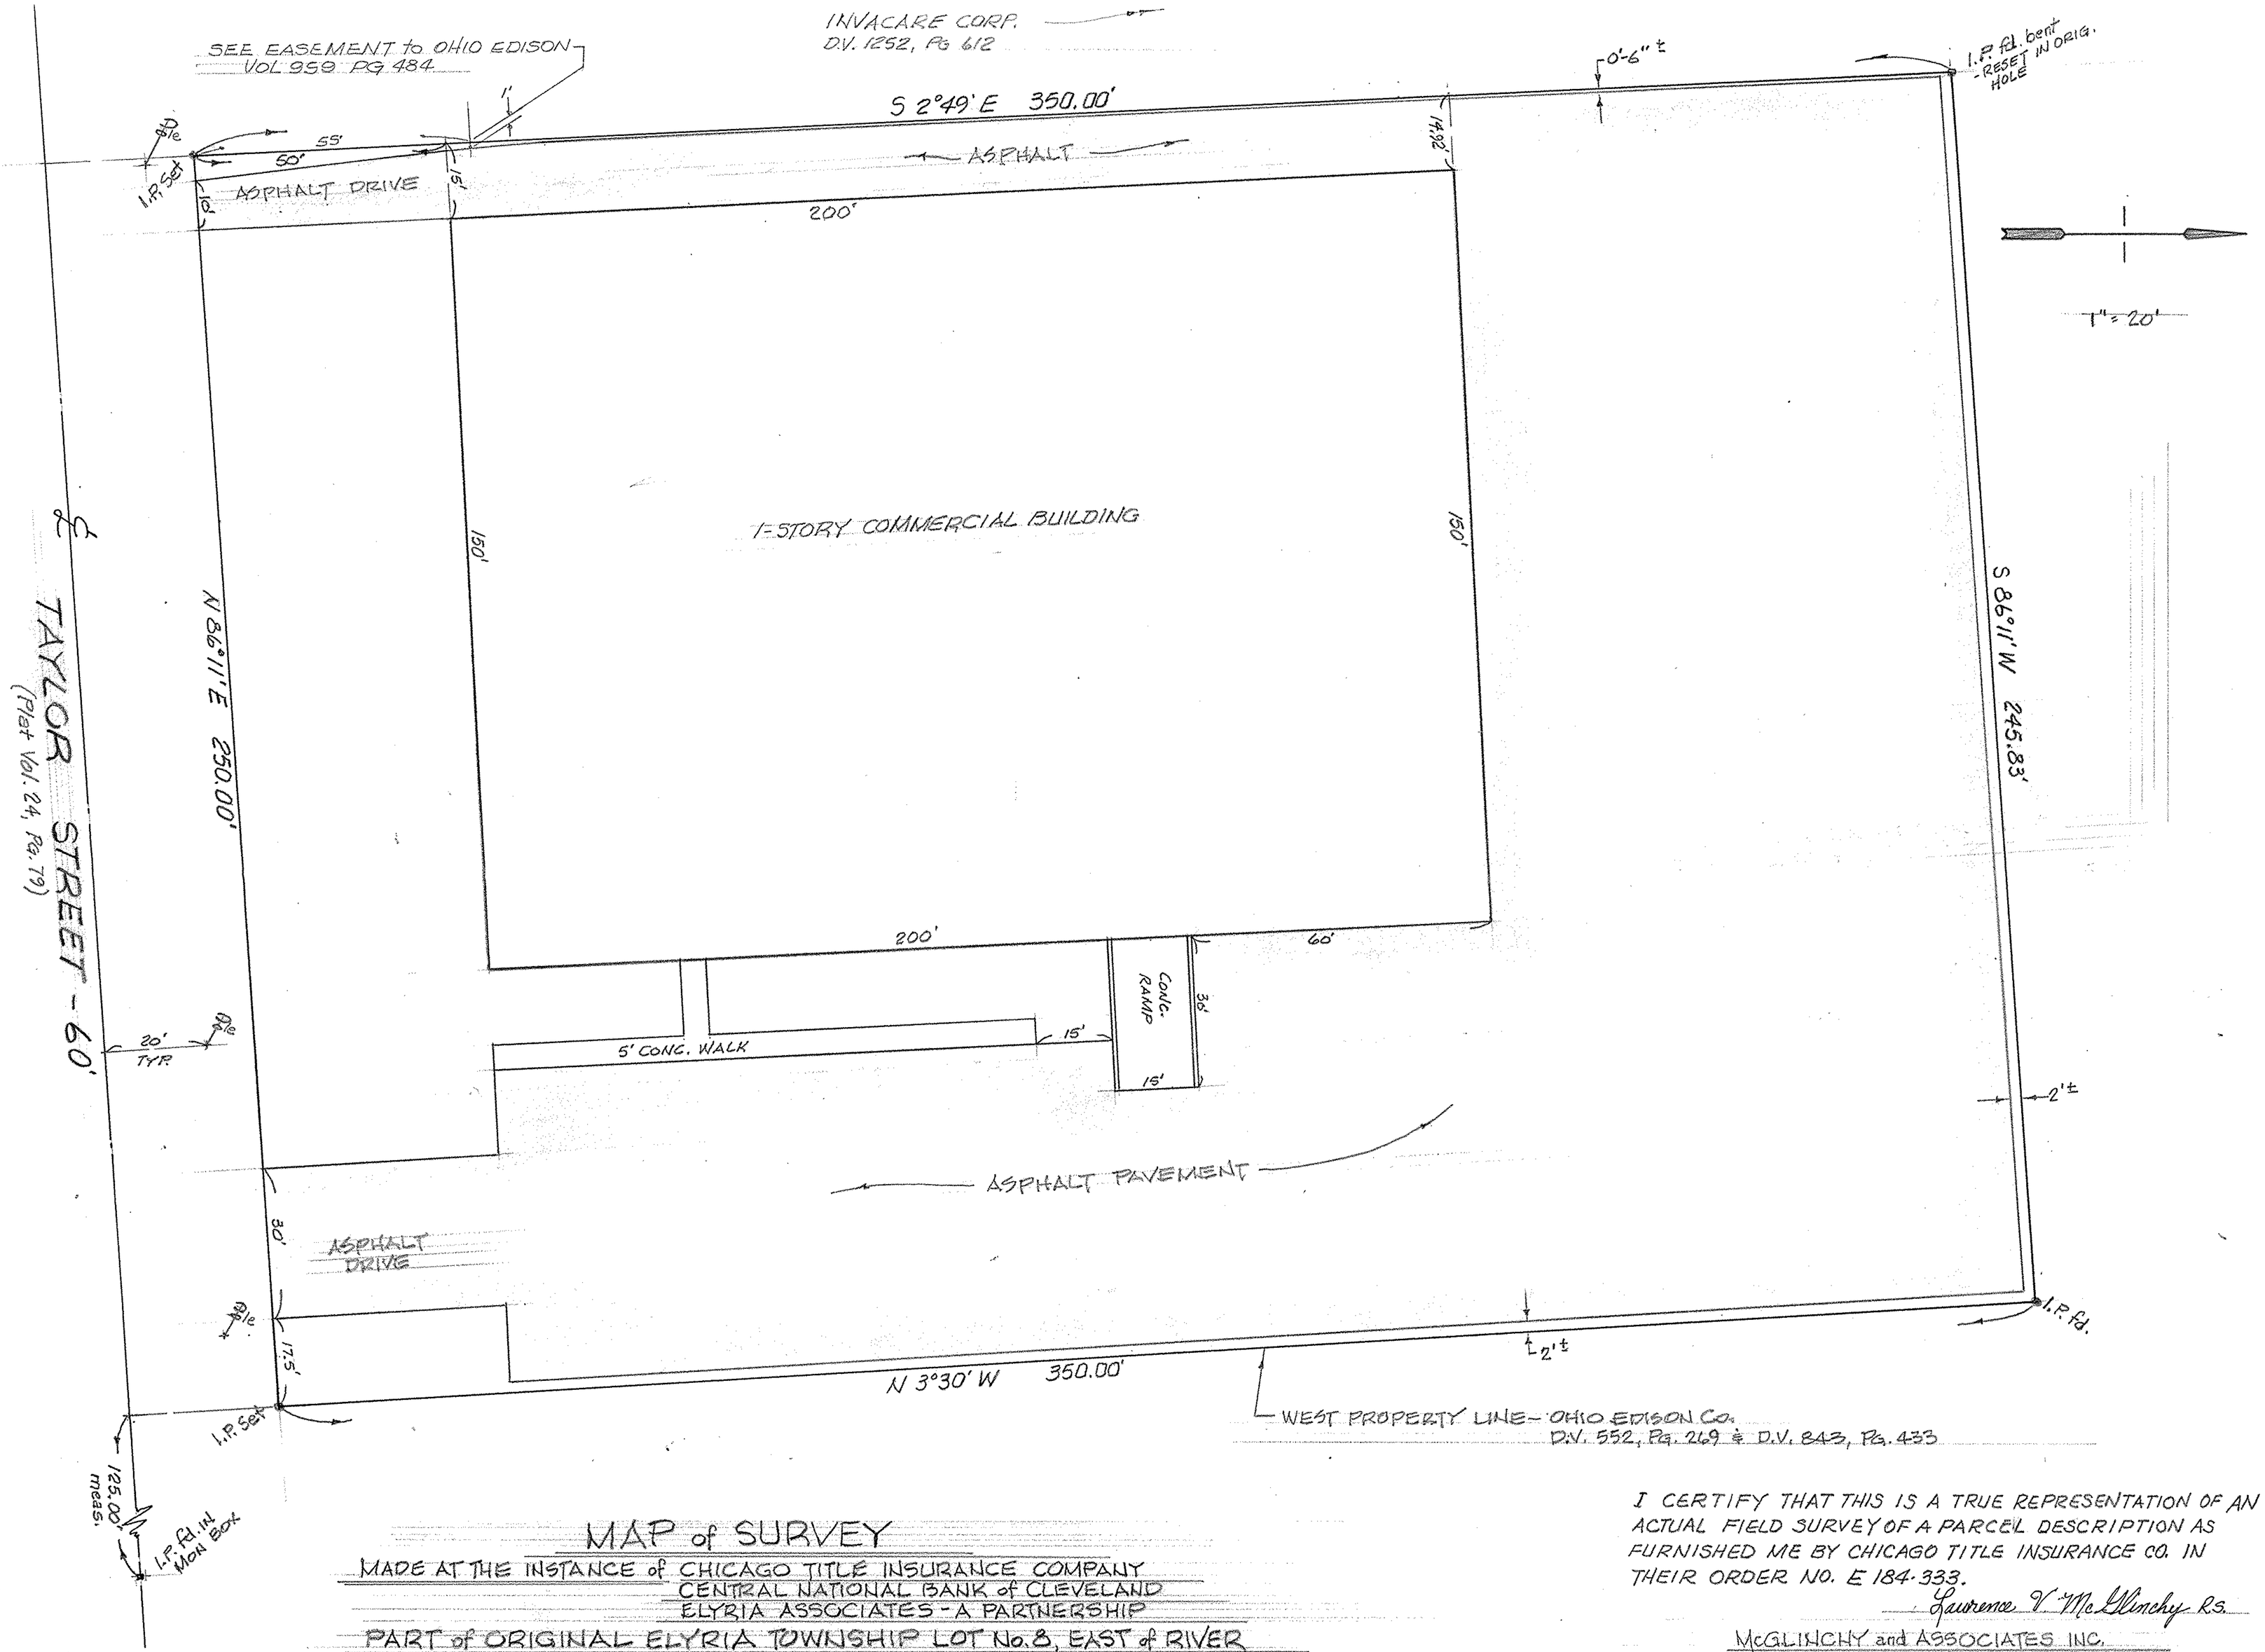

MAP of SURVEY

MADE AT THE INSTANCE of CHICAGO TITLE INSURANCE COMPANY
CENTRAL NATIONAL BANK of CLEVELAND
ELYRIA ASSOCIATES - A PARTNERSHIP

PART of ORIGINAL ELYRIA TOWNSHIP LOT No. 8, EAST of RIVER
CITY of ELYRIA, LORAIN COUNTY, OHIO

I CERTIFY THAT THIS IS A TRUE REPRESENTATION OF AN ACTUAL FIELD SURVEY OF A PARCEL DESCRIPTION AS FURNISHED ME BY CHICAGO TITLE INSURANCE CO. IN THEIR ORDER NO. E 184-333.

Lawrence V. McGlinchy R.S.

McGLINCHY and ASSOCIATES INC.
PROFESSIONAL ENGINEER & SURVEYORS
110½ MIDDLE AVE. ELYRIA, OHIO
DECEMBER, 1982 # 827486