NOTES: o indicates iron pin previously set unless otherwise designated.
● indicates iron pin set in March of 1979.

Gary E. Penfound Reg. Surveyor No. 4457

PLAT OF SURVEYS FOR EDGAR C. & HELEN CLARK AND FOR EDGAR A. & MITSUKO CLARK

SECTION NO. 20 CARLISLE TOWNSHIP
LORAIN COUNTY OHIO
SCALE: 1" = 100' MARCH - 1979

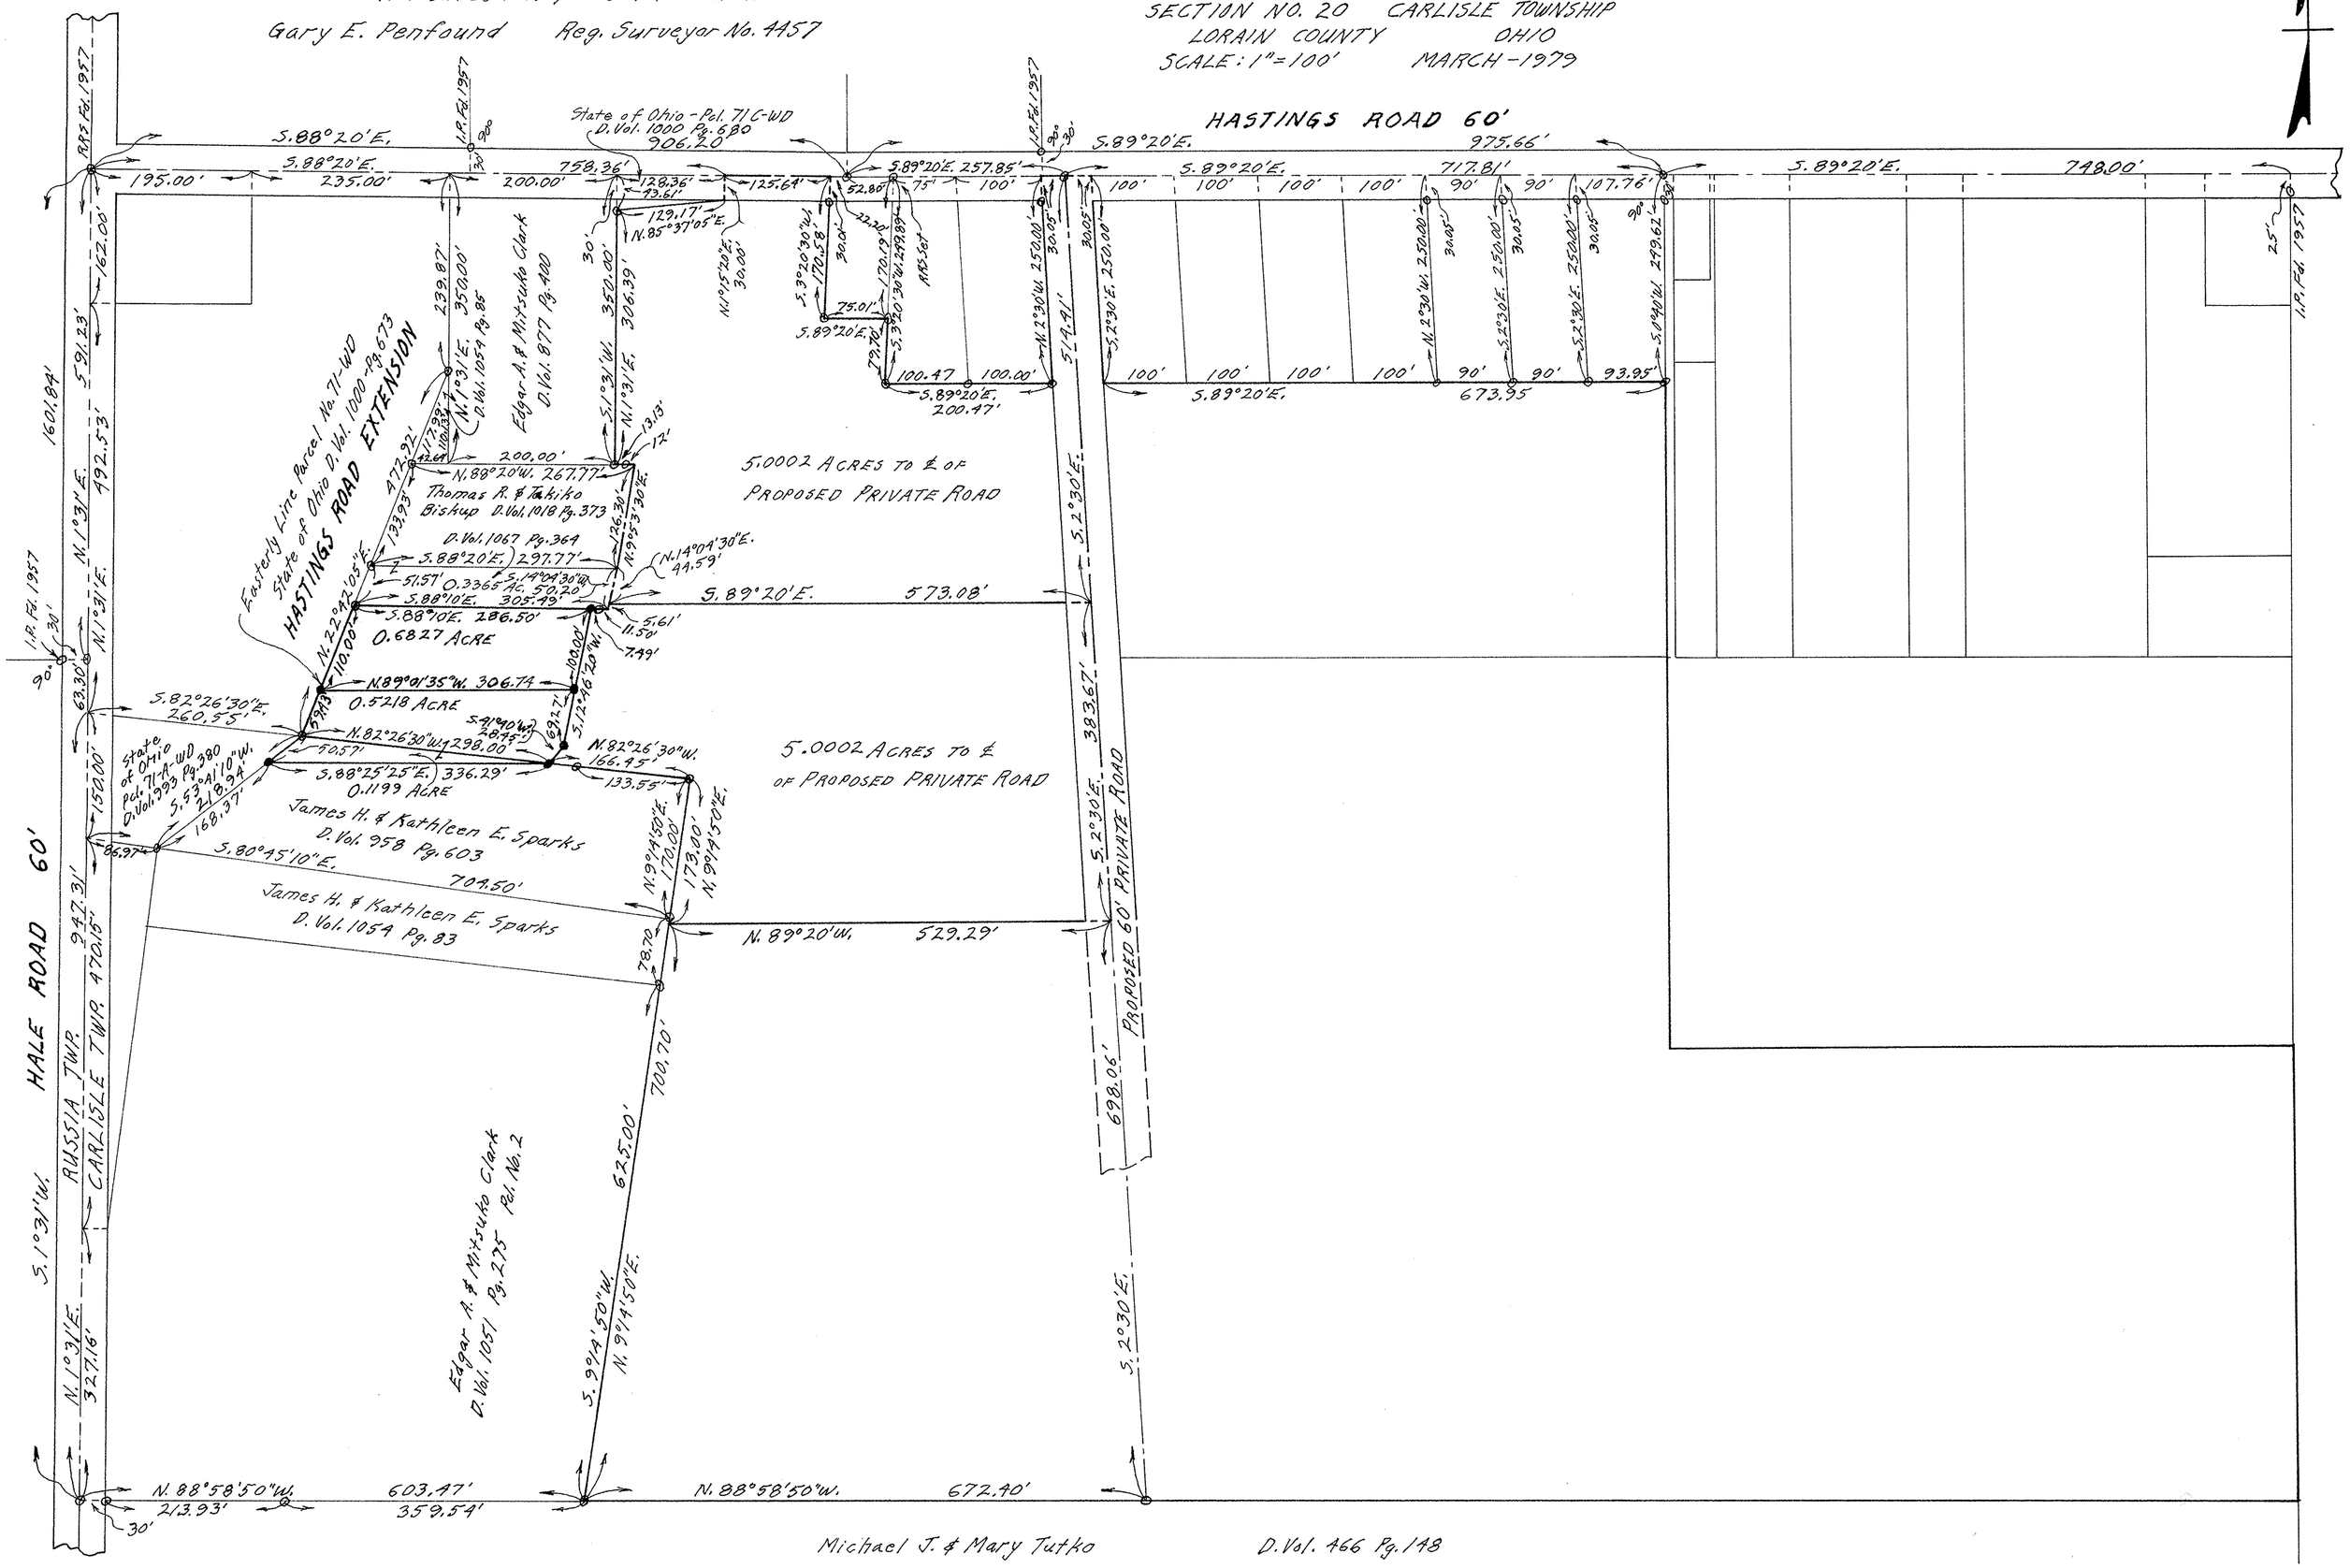

10-00-020