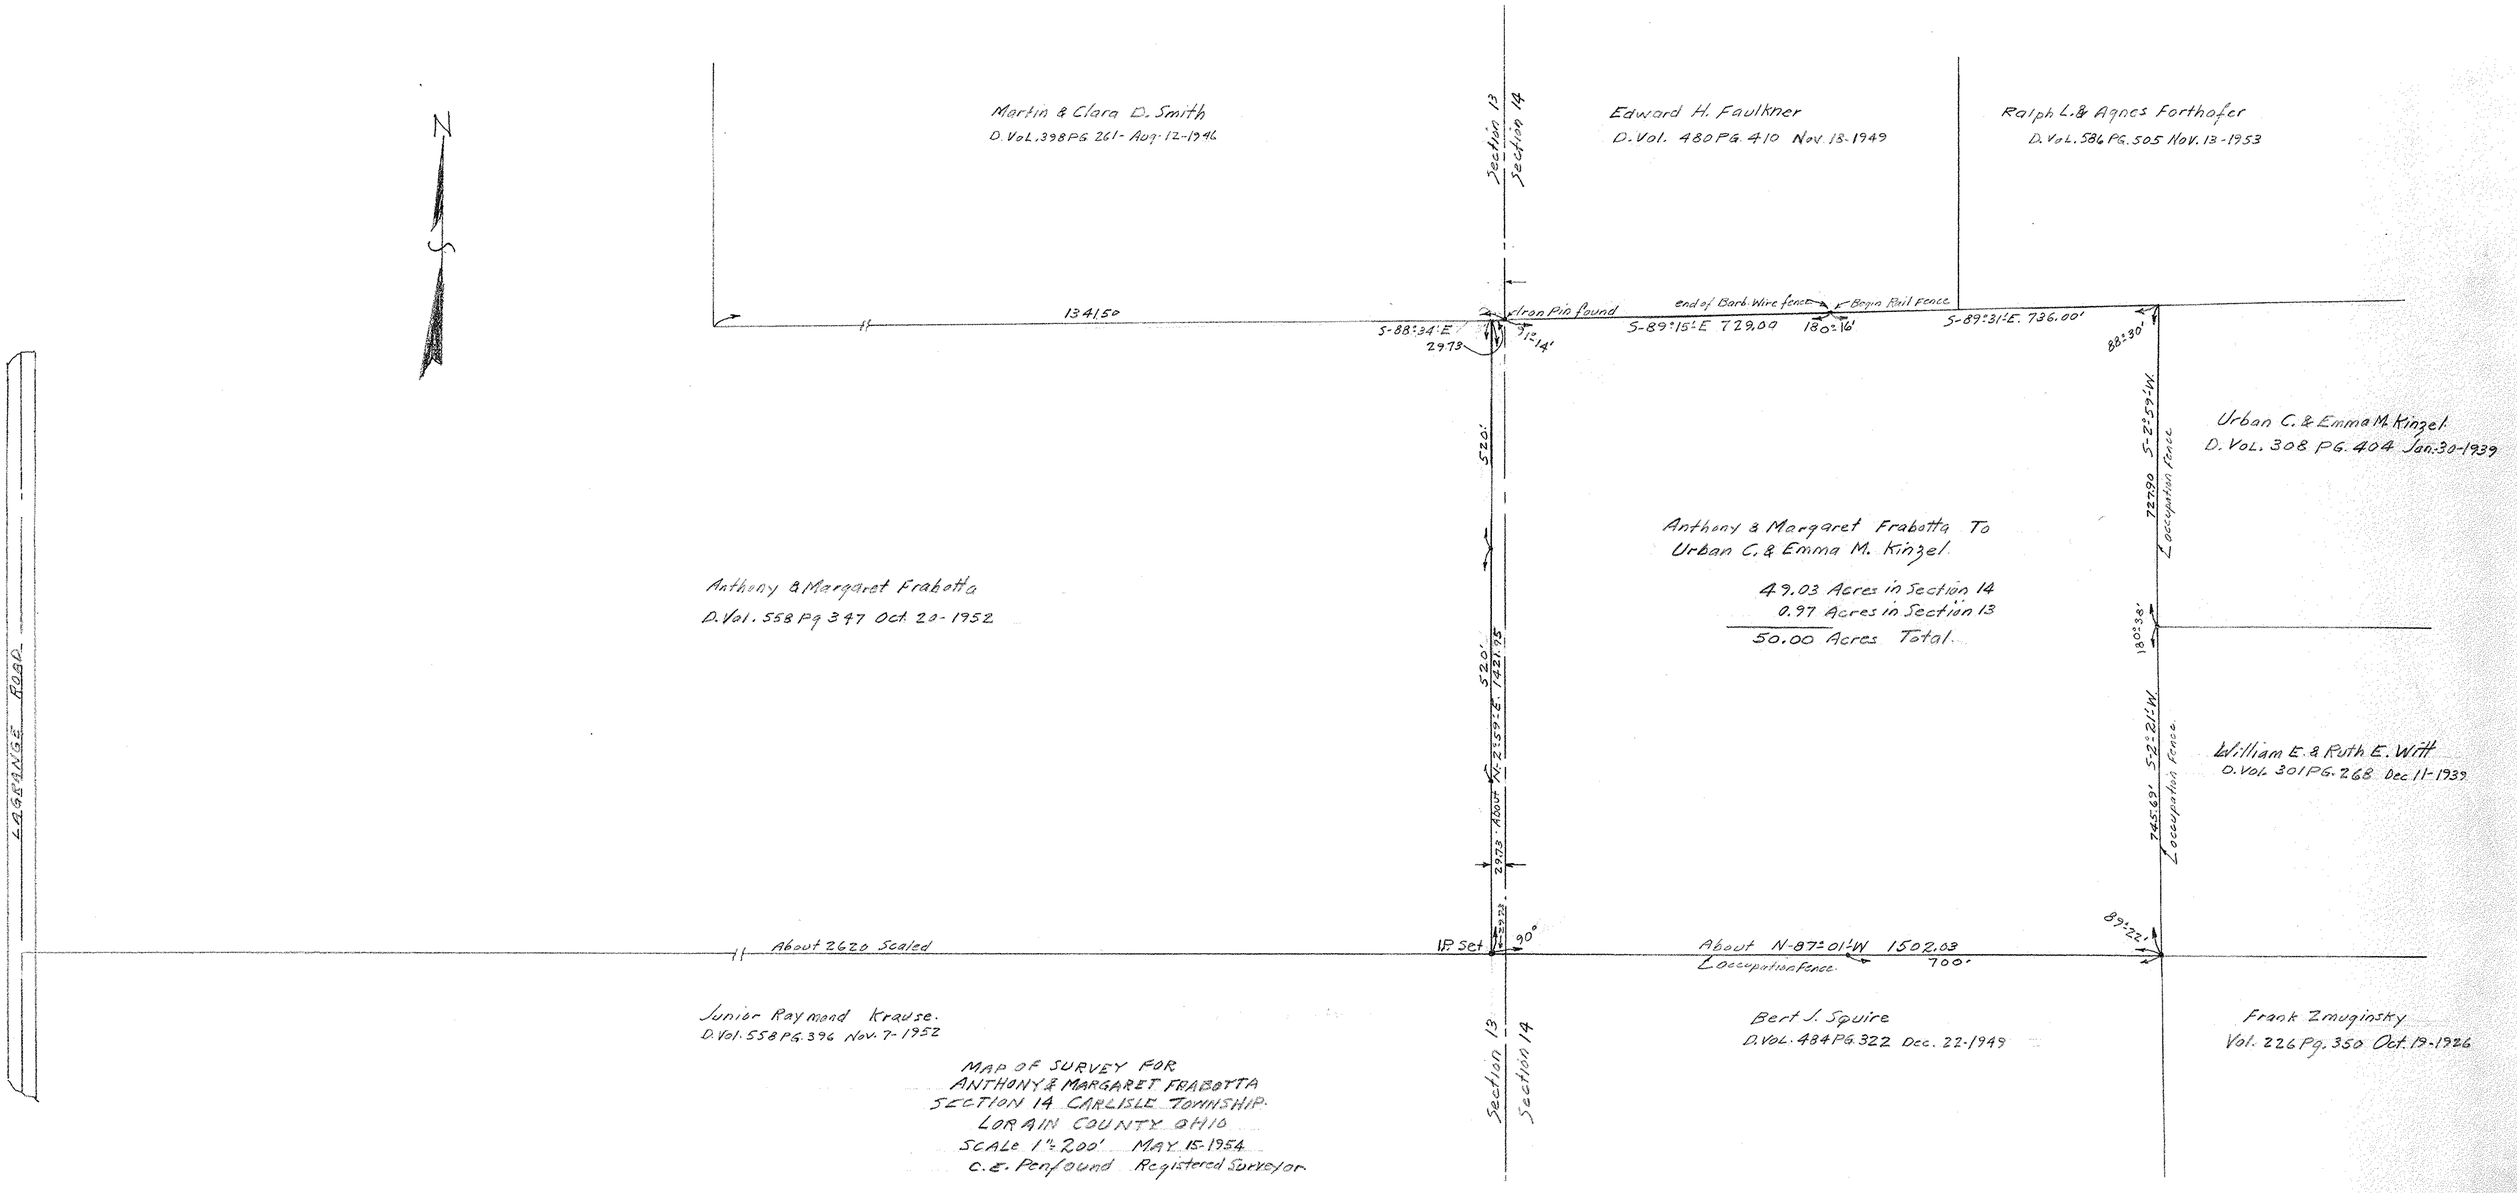
N
LAGRANGE ROAD
Martin & Clara D. Smith
D. Vol. 398 PG. 261 - Aug. 12-1946
Section 13
Section 14
Edward H. Faulkner
D. Vol. 480 PG. 410 Nov. 18-1949
Ralph L. & Agnes Forthofer
D. Vol. 586 PG. 505 Nov. 13-1953
1341.50
S-88°34'E
2973
Iron Pin found
9°1'14'
end of Barb Wire fence
Begin Rail Fence
S-89°15'E 729.09
180°16'
S-89°31'E. 736.00'
88°30'
S-2°59'W.
727.90
Occupation Fence
Urban C. & Emma M. Kinzel
D. Vol. 308 PG. 404 Jan. 30-1939
520'
Anthony & Margaret Frabotta To
Urban C. & Emma M. Kinzel
49.03 Acres in Section 14
0.97 Acres in Section 13
50.00 Acres Total
Anthony & Margaret Frabotta
D. Vol. 558 Pg 347 Oct. 20-1952
520'
N-2°59'E. 1421.95
180°38'
S-2°21'W.
745.69'
Occupation Fence
William E. & Ruth E. Witt
D. Vol. 301 PG. 268 Dec. 11-1939
About 2973
2973
I.P. Set
90°
About 2620 Scaled
About N-87°01½'W 1502.03
Occupation Fence
700'
89°22'
Junior Raymond Krause.
D. Vol. 558 PG. 396 Nov. 7-1952
Bert J. Squire
D. Vol. 484 PG. 322 Dec. 22-1949
Frank Zmuginsky
Vol. 226 Pg. 350 Oct. 19-1926
Section 13
Section 14
MAP OF SURVEY FOR
ANTHONY & MARGARET FRABOTTA
SECTION 14 CARLISLE TOWNSHIP
LORAIN COUNTY OHIO
SCALE 1" = 200' MAY 15-1954
C. E. Penfound Registered Surveyor

10-00-014