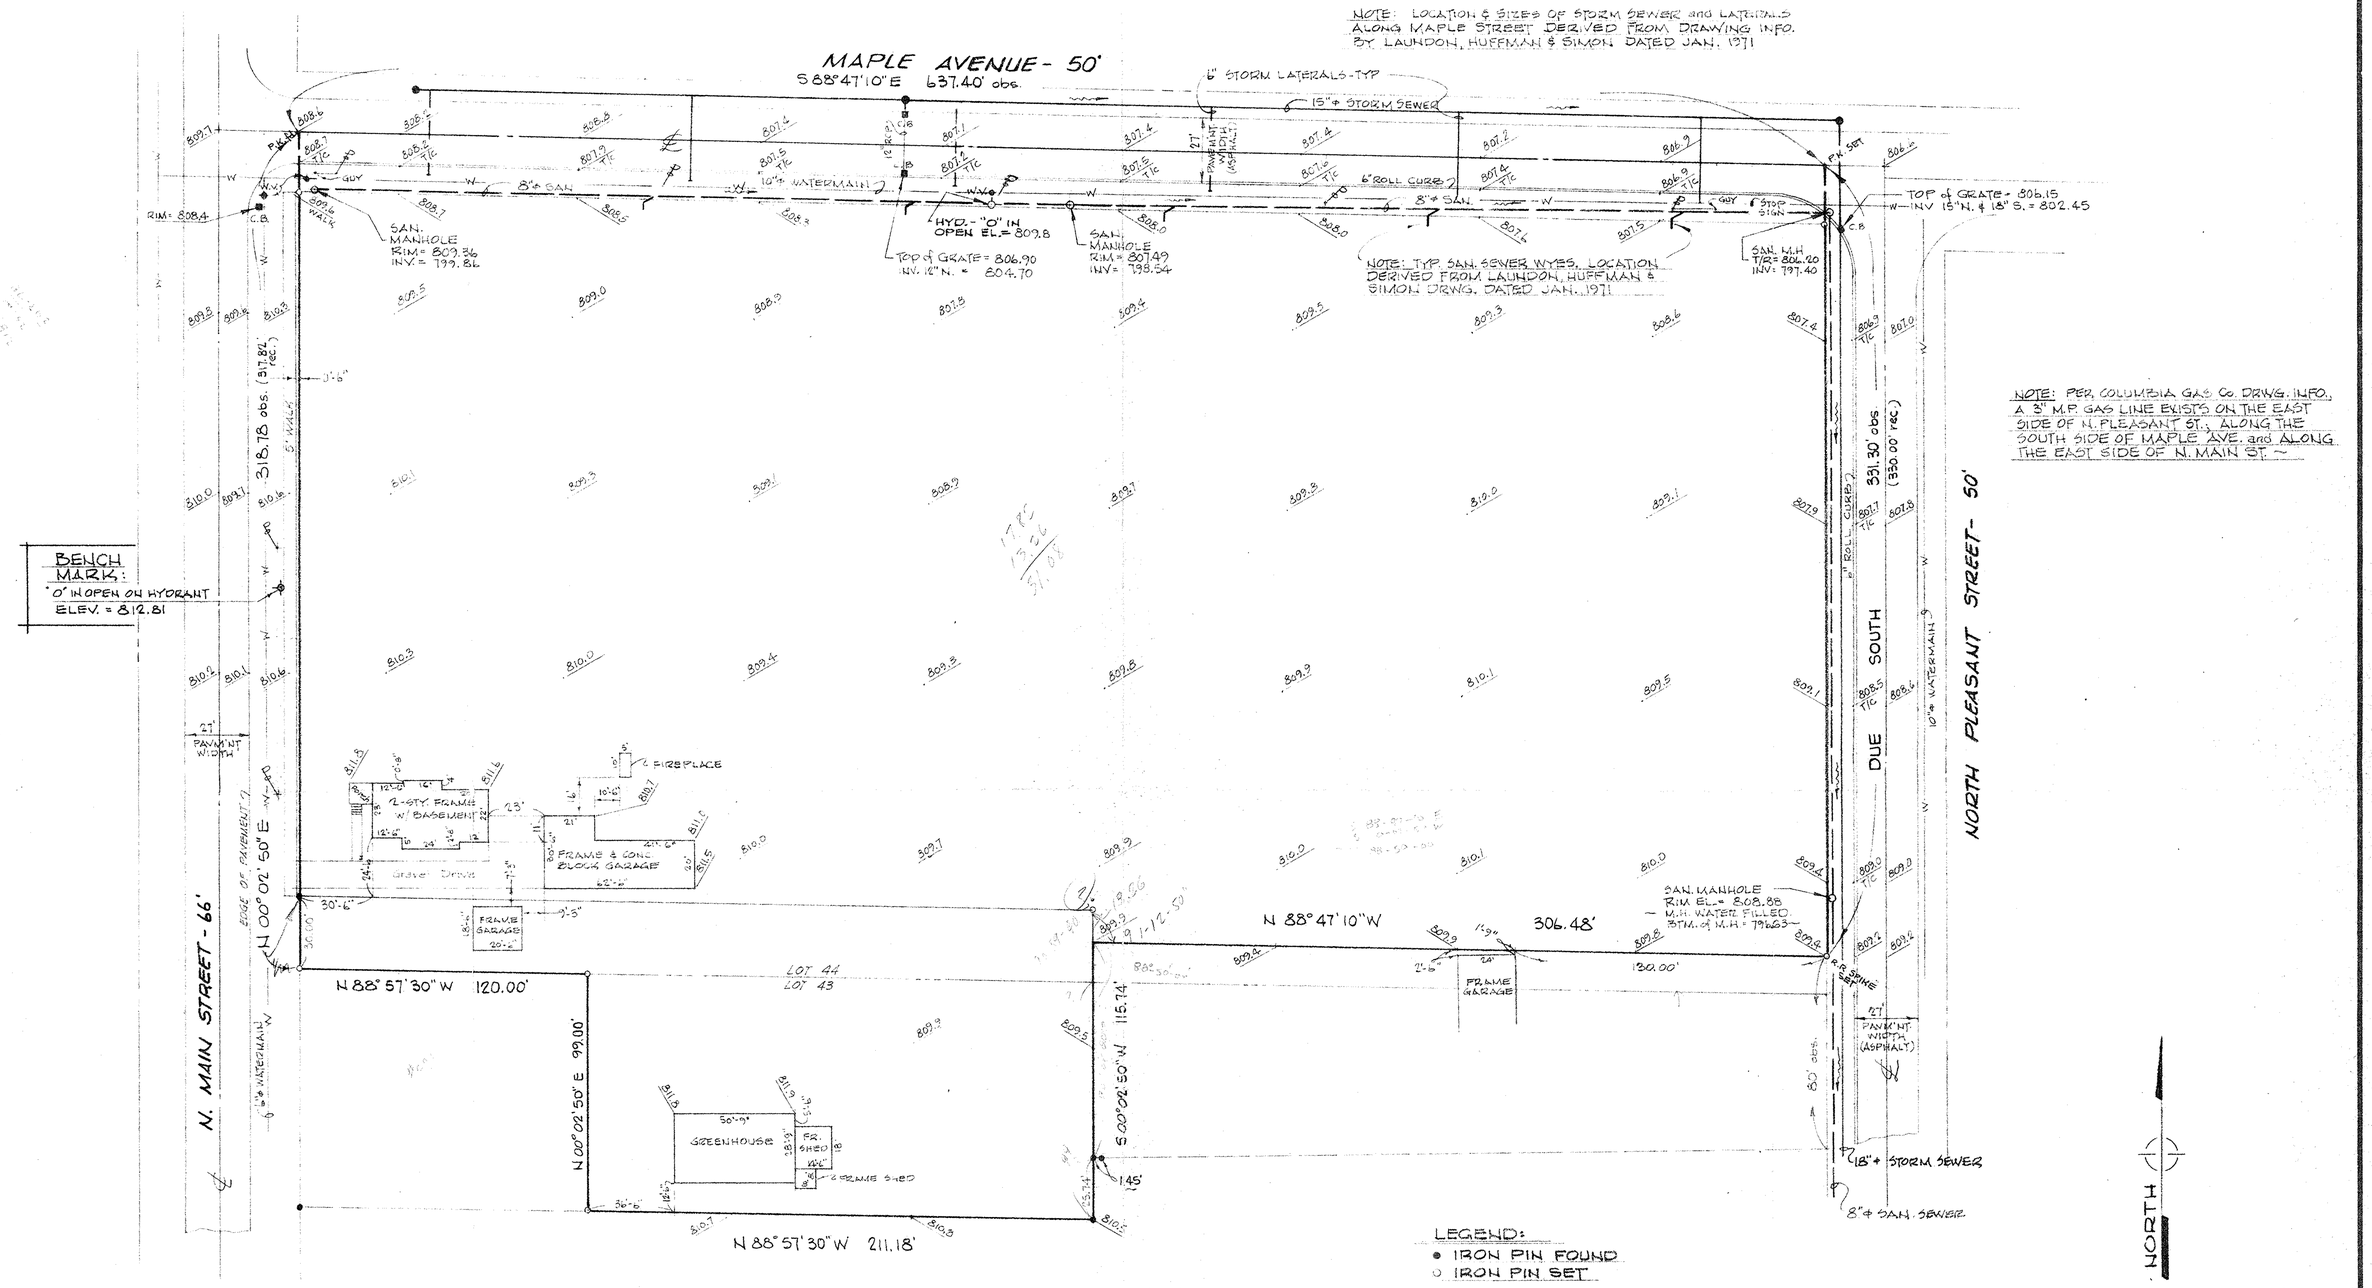

MAP of BOUNDARY and TOPOGRAPHIC SURVEY

PREPARED FOR CLARK and POST ARCHITECTS INC.

PART of LOT 43 and ALL of LOT 44 of ORIG. VILLAGE PLAT - VOL. 1, PG 20
PART of ORIGINAL RUSSIA TOWNSHIP LOT No. 76
NOW in CITY of OBERLIN, LORAIN COUNTY, OHIO

McGLINCHY and ASSOCIATES
PROFESSIONAL ENGINEERS AND SURVEYORS
538 WEST BROAD ST ELYRIA, OHIO

SCALE: 1" = 30' DRAWN BY: BOB
DATE: MAR. 1979 JOB NO: 794898