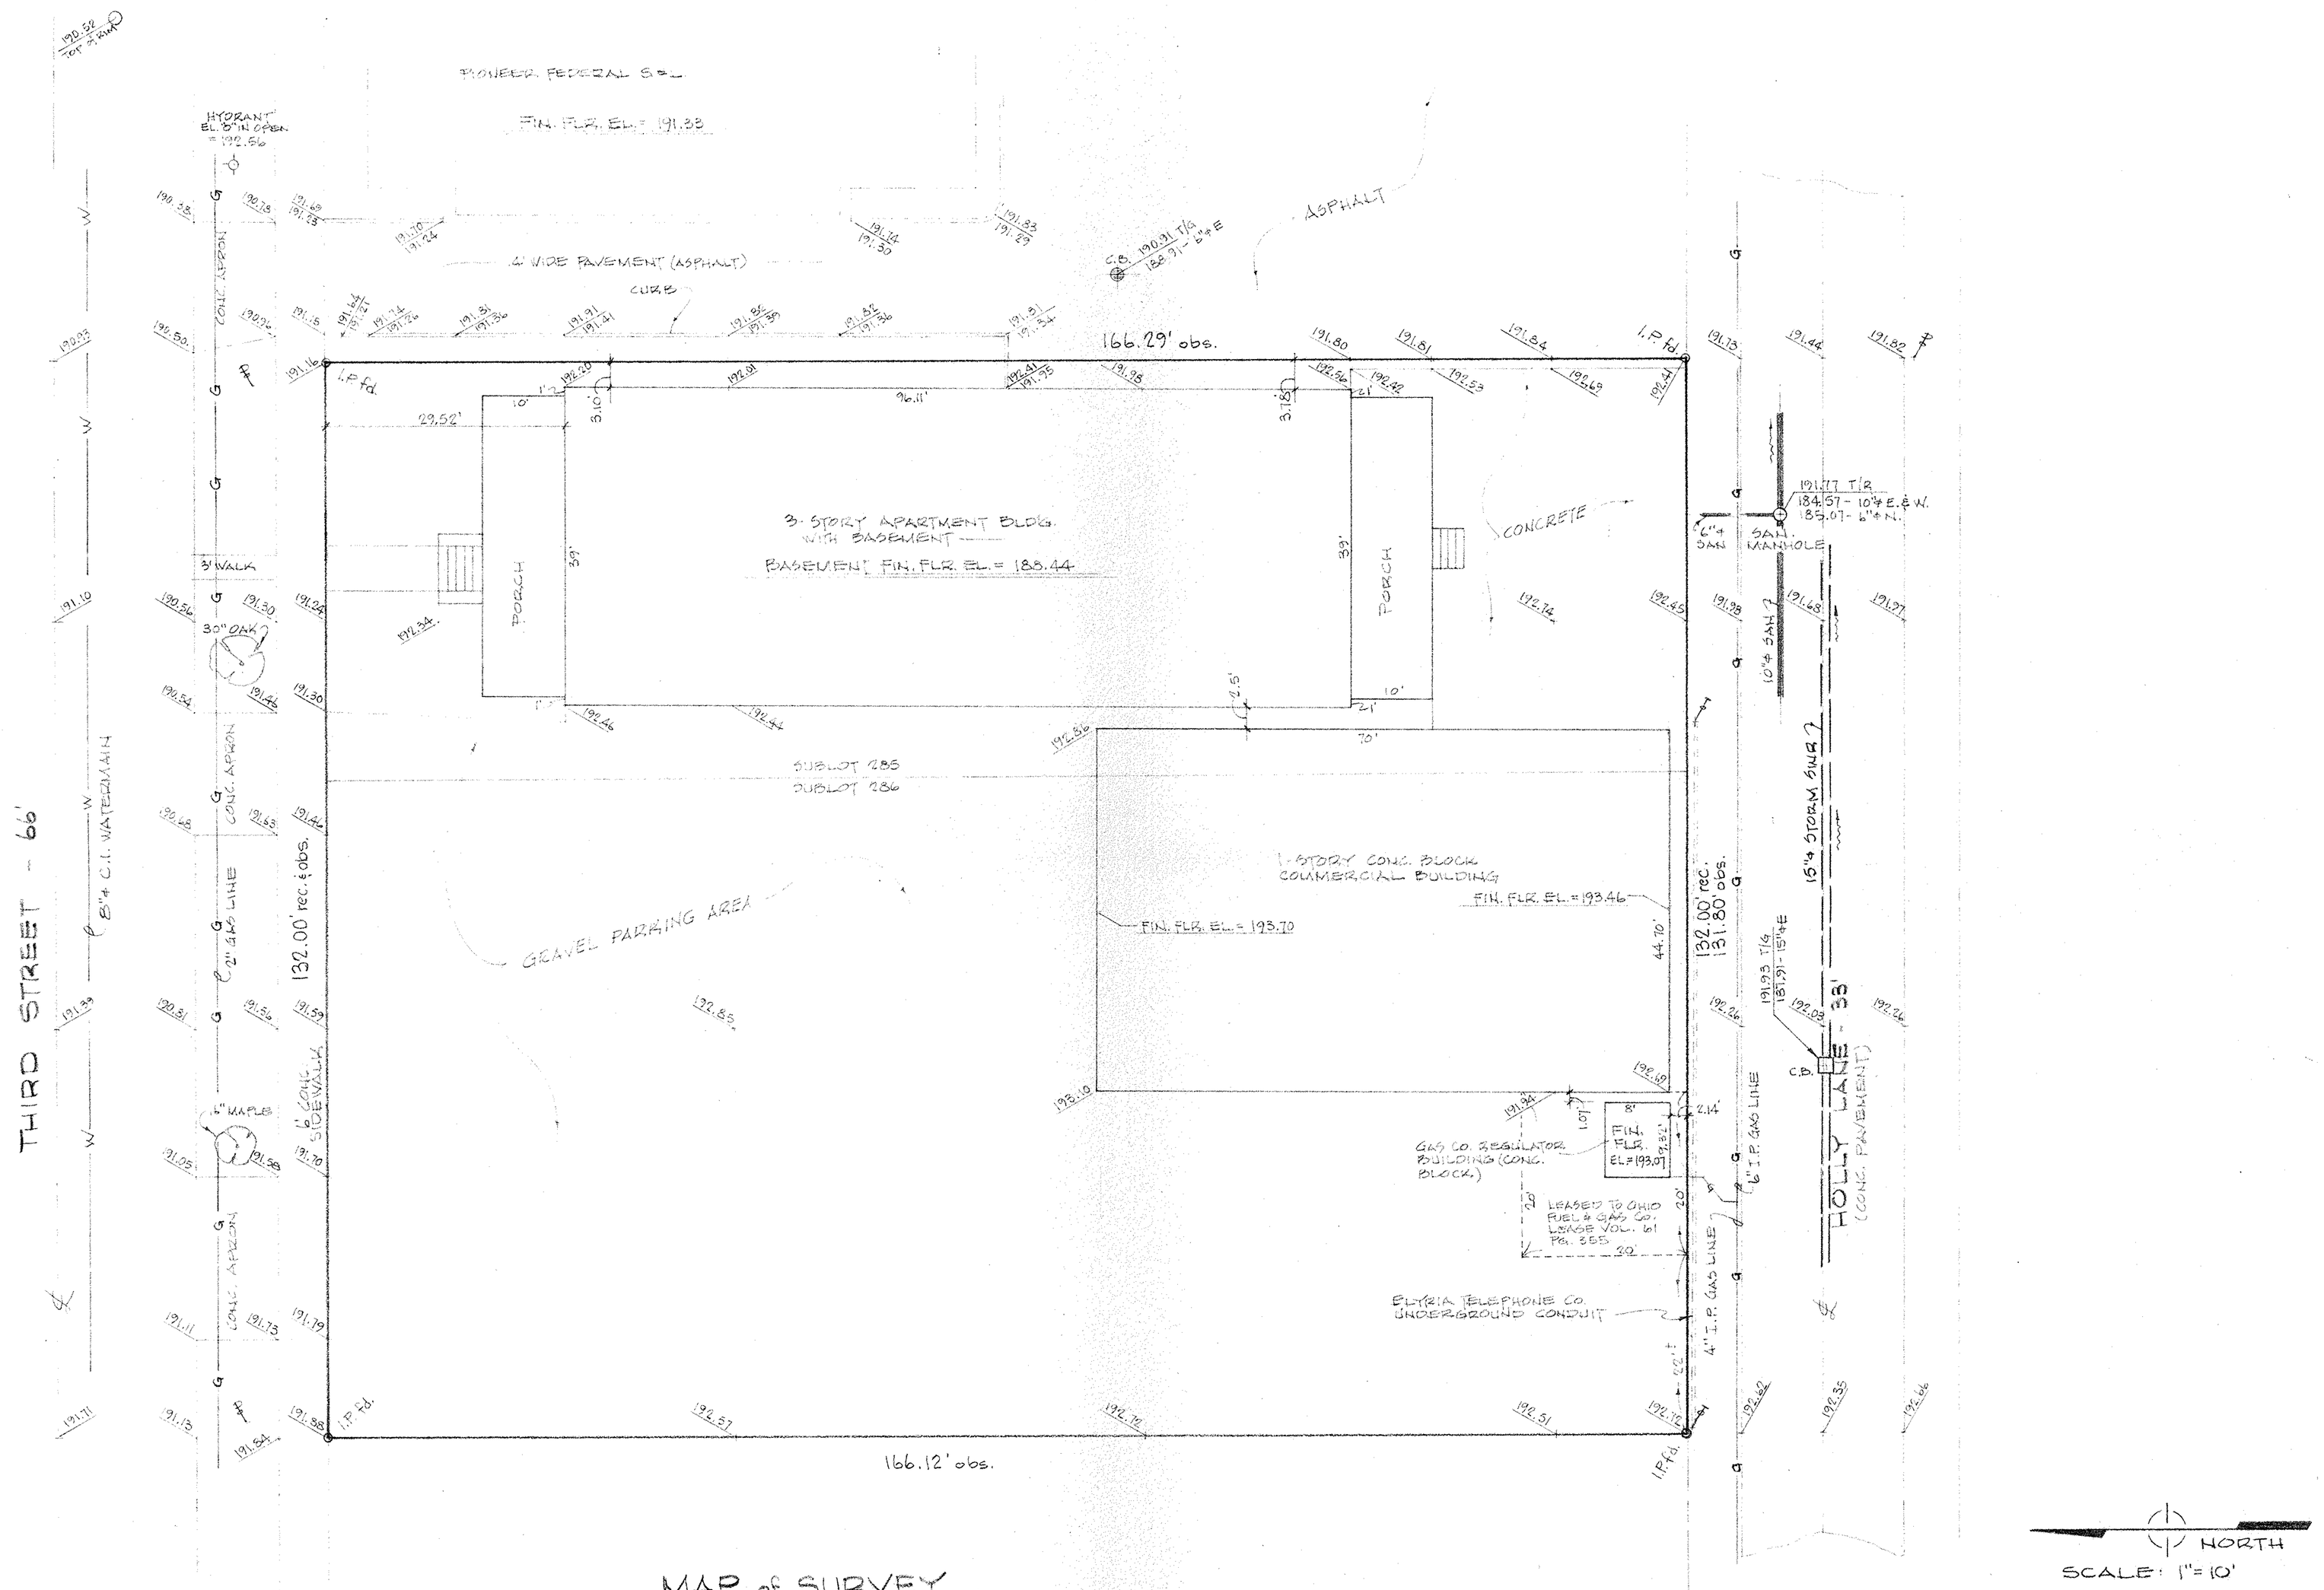

MAP of SURVEY

PREPARED FOR PIONEER FEDERAL SAVINGS & LOAN ASS'N.

PARTS of SUBLOTS 285 & 286 in BLOCK No. 51 of HEMAN ELY'S TOWN PLAT of ELYRIA, BETWEEN the BRANCHES of BLACK RIVER - PLAT VOL. 3, PG. 14

CITY of ELYRIA, LORAIN COUNTY, OHIO

McGLINCHY and ASSOCIATES INC.
PROFESSIONAL ENGINEER and SURVEYORS
538 W. BROAD ST. ELYRIA, OHIO 44035
APRIL, 1979 #795026