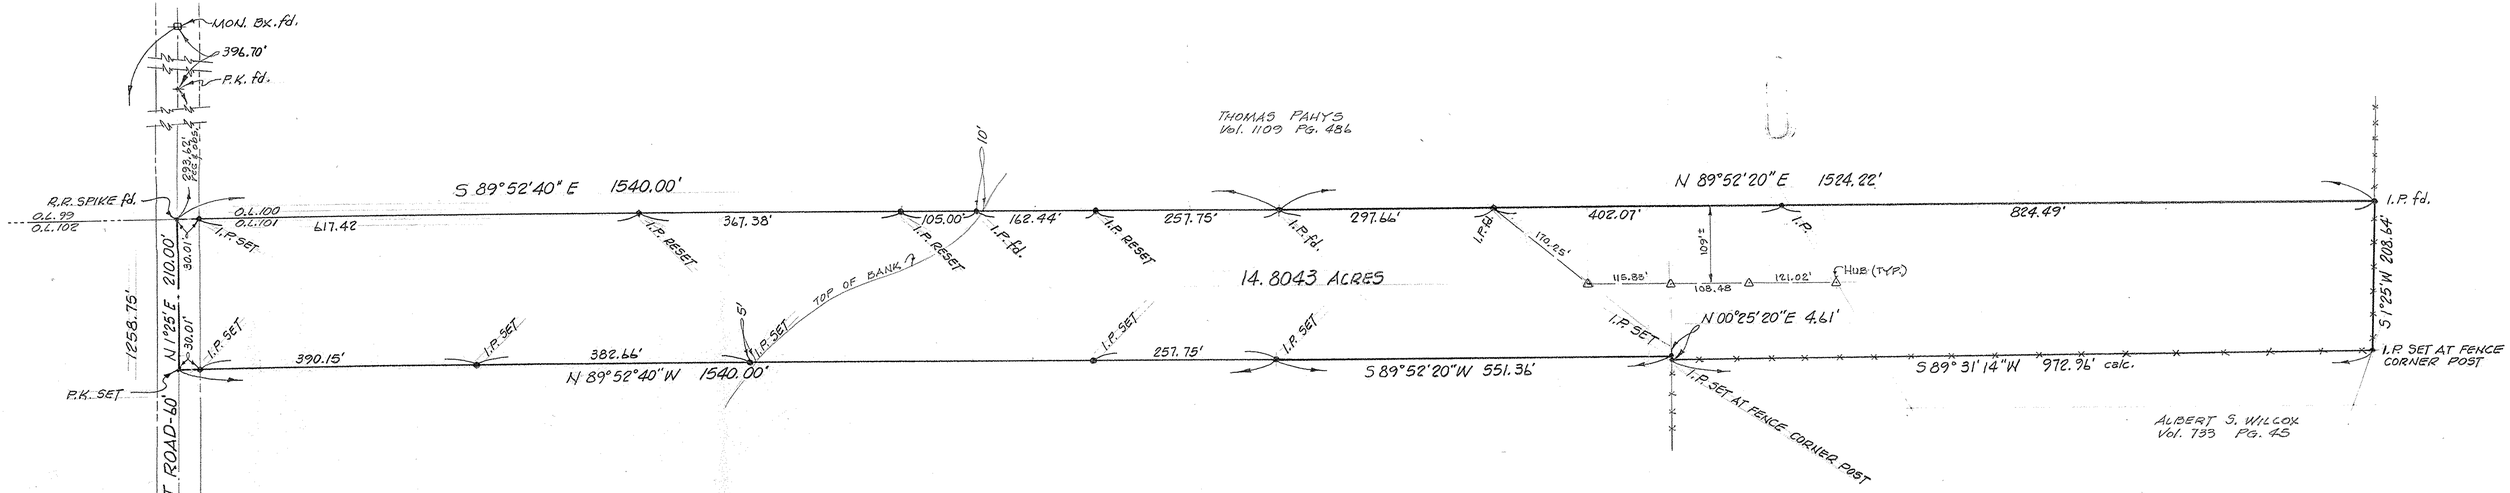

MAP of SURVEY and PROPOSED PARCEL SPLIT

PREPARED FOR LEONARD FORTHOFER & ANDREW BIGDA

PART of ORIGINAL PITTSFIELD TOWNSHIP LOT No. 101

TOWNSHIP of PITTSFIELD, LORAIN COUNTY, OHIO

McGLINCHY and ASSOCIATES

PROFESSIONAL ENGINEER and SURVEYORS

ELYRIA OHIO

NOVEMBER, 1978 #784439