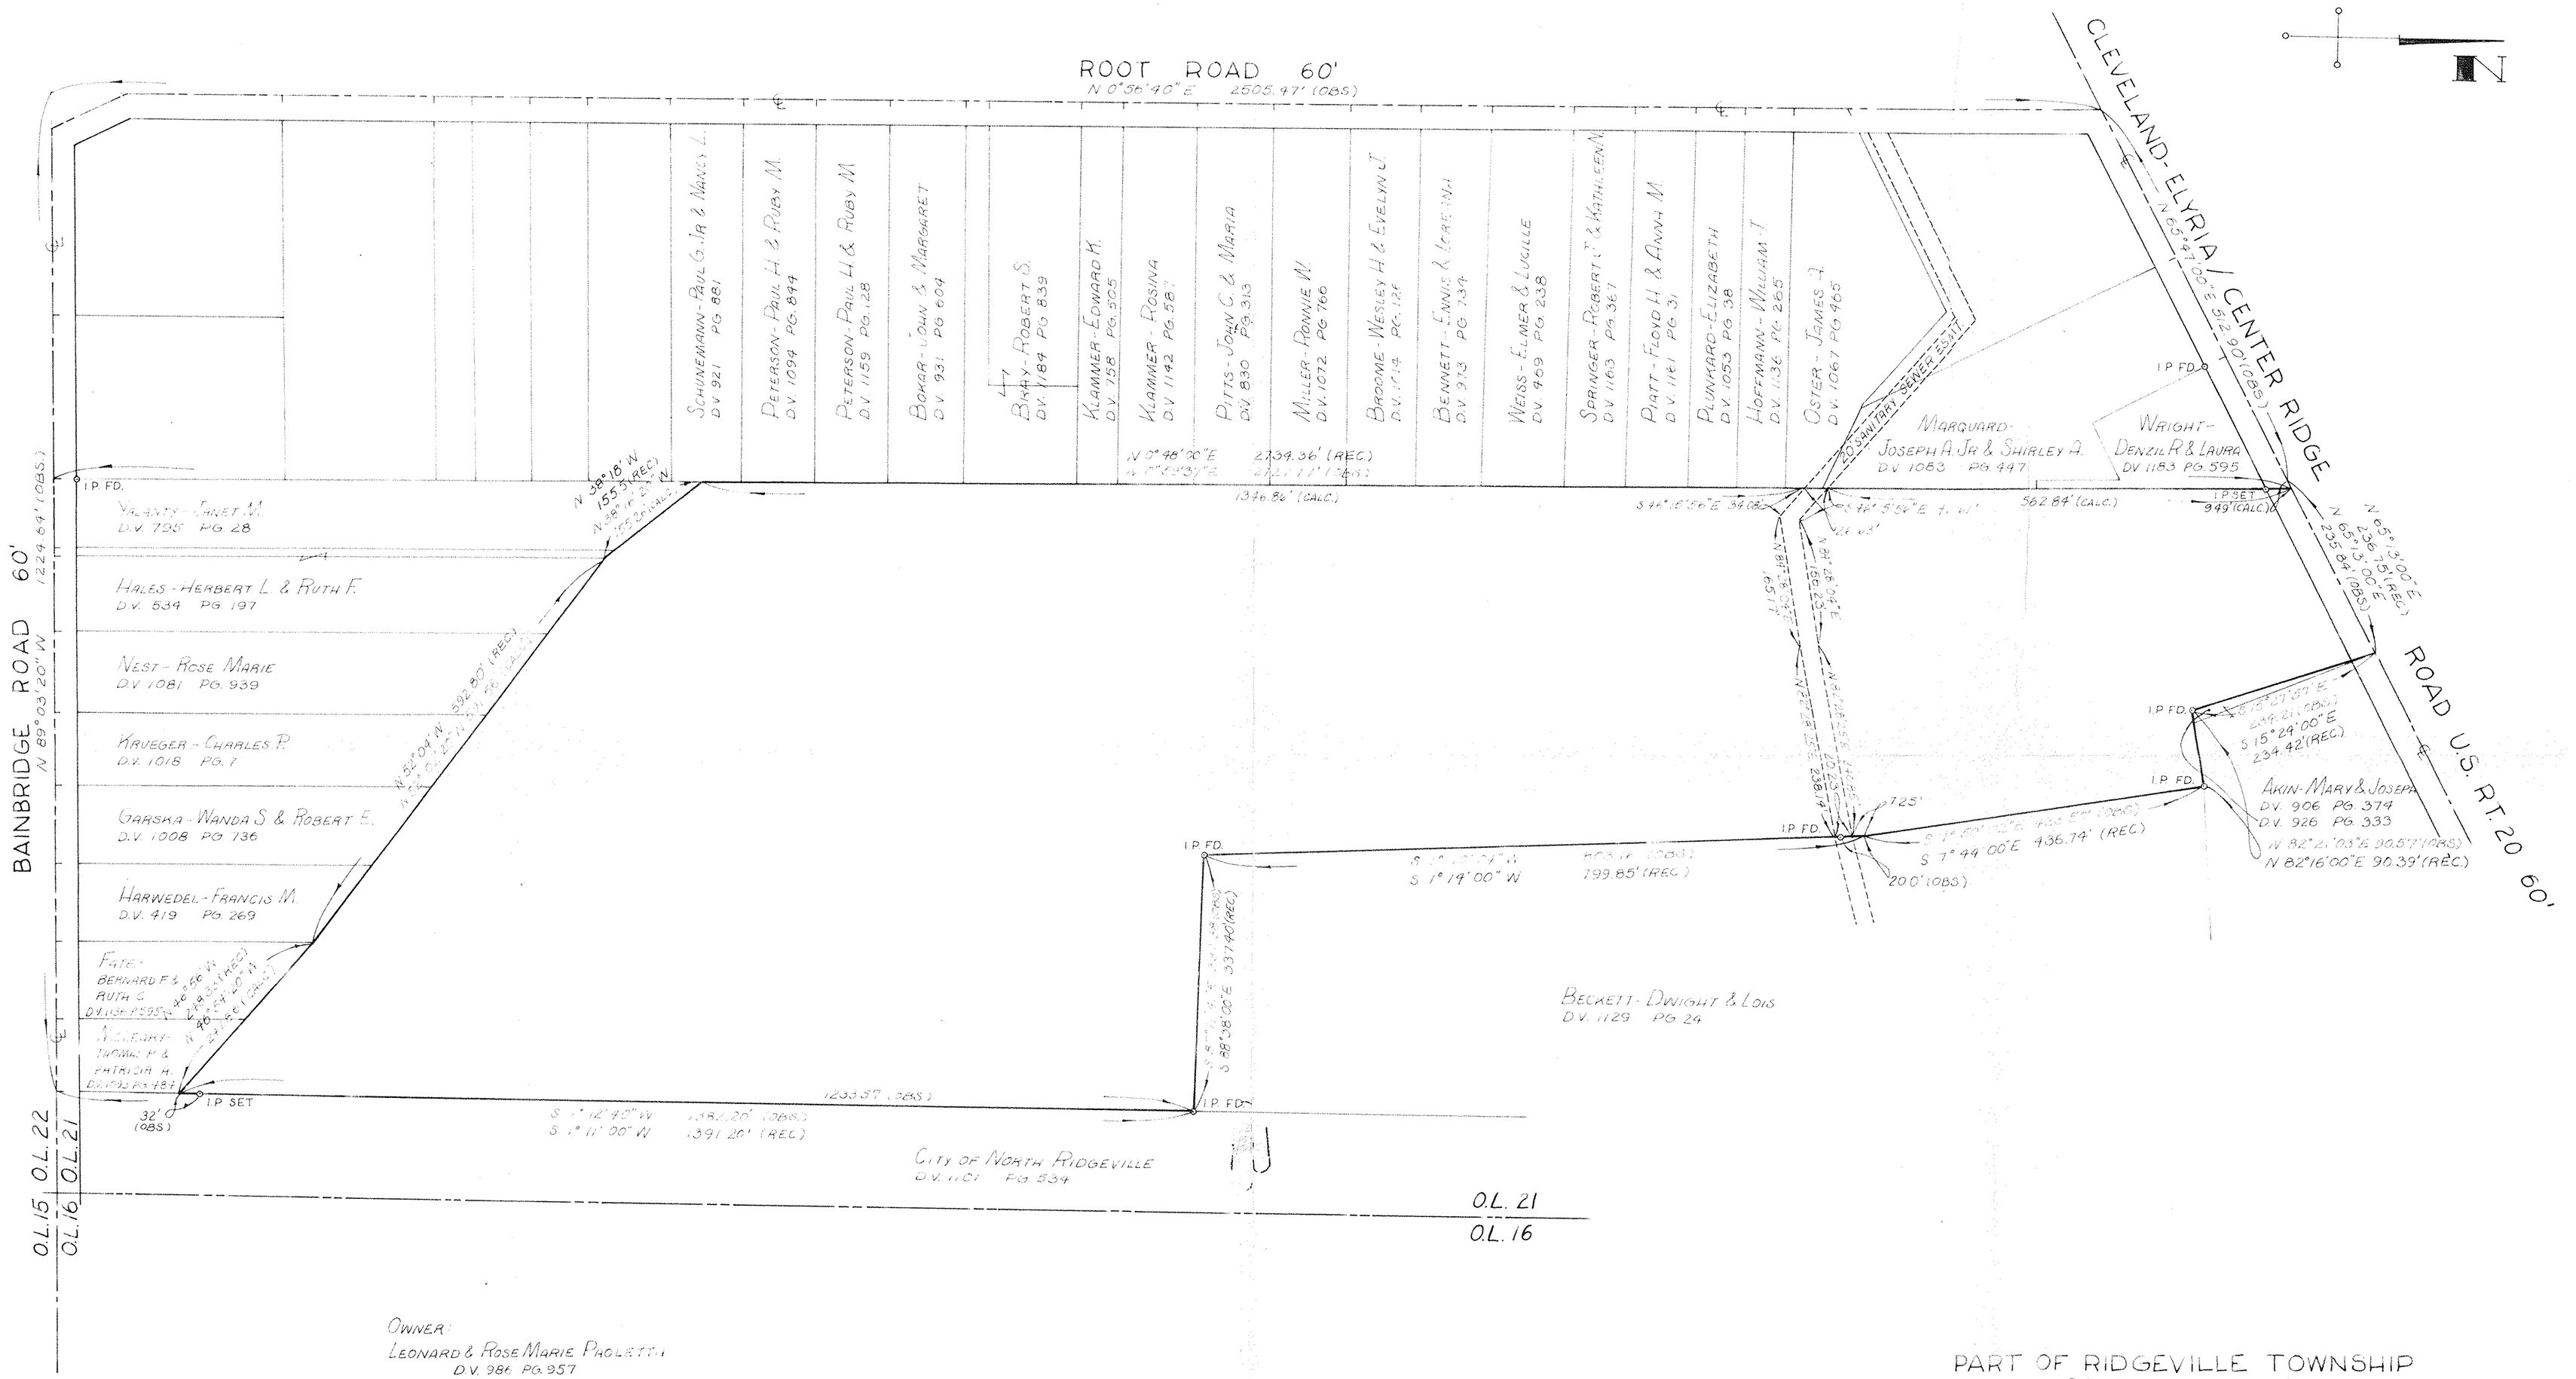

OWNER:
LEONARD & ROSE MARIE PAOLETTI
D.V. 986 PG. 957
28.65 AC.

NOTE:
BOUNDARY DATA DESIGNATED "REC." ARE DEED BEARINGS AND DISTANCES.

PART OF RIDGEVILLE TOWNSHIP
ORIGINAL LOT 21

CITY OF NORTH RIDGEVILLE
COUNTY OF LORAIN
STATE OF OHIO

SCALE: 1" = 100' JULY 1978

REVISIONS
8-7-78

PREPARED BY
KLEINOEDER - SCHMIDT & ASSOC.
CONSULTING ENGINEERS AND SURVEYORS

78-114