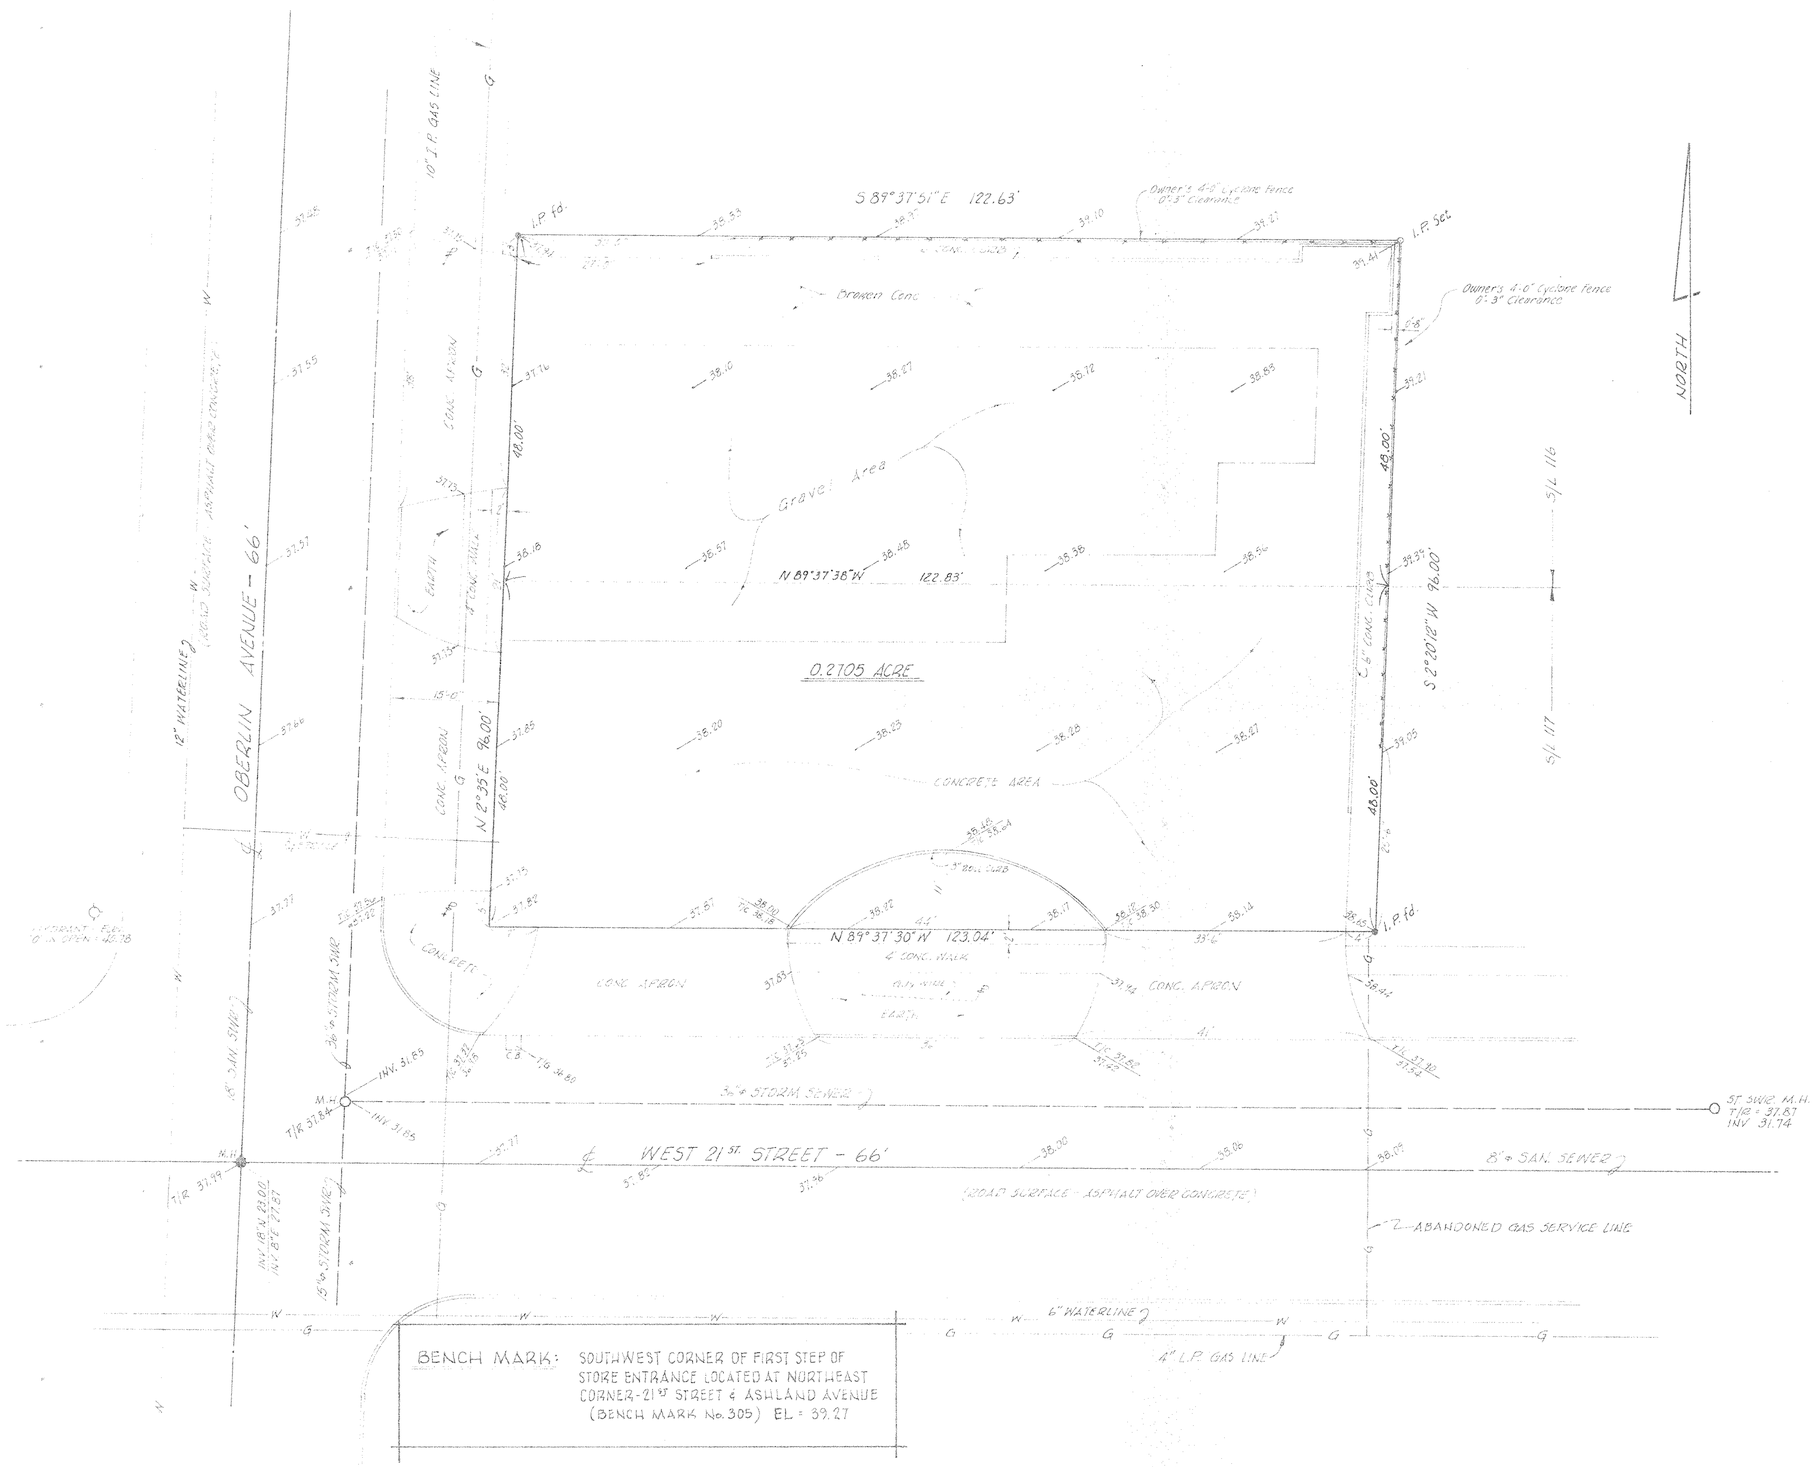

BENCH MARK: SOUTHWEST CORNER OF FIRST STEP OF STORE ENTRANCE LOCATED AT NORTHEAST CORNER-21ST STREET & ASHLAND AVENUE (BENCH MARK No. 305) EL = 39.27

CERTIFICATION

THIS IS TO CERTIFY, THAT ON MARCH 17, 1977, I MADE AN ACCURATE SURVEY OF THE PREMISES SHOWN HEREON AND THAT THERE ARE NO EASEMENTS OR ENCROACHMENTS VISIBLE ON THE GROUND

Lawrence J. McGlinchy

SOUTHLAND LOCATION No. 1941-20676
" GFN No. 20648
CITY of LORAIN
COUNTY of LORAIN
STATE of OHIO

PLAN of SURVEY for:
THE SOUTHLAND CORPORATION
PARTS of SUBLOTS Nos. 116 & 117 of STANG'S SECOND SUBDIVISION - PLAT VOLUME 4, PAGE 18. PART of ORIGINAL BLACK RIVER TOWNSHIP LOT 6, TRACT 1. NOW IN CITY of LORAIN, OHIO

McGLINCHY AND ASSOCIATES
PROFESSIONAL ENGINEERS AND SURVEYORS
538 WEST BROAD ST ELYRIA, OHIO

SCALE: 1" = 10' DRAWN BY: BOB
DATE: 3-21-78 JOB NO. 78295b
REV. 4-7-78