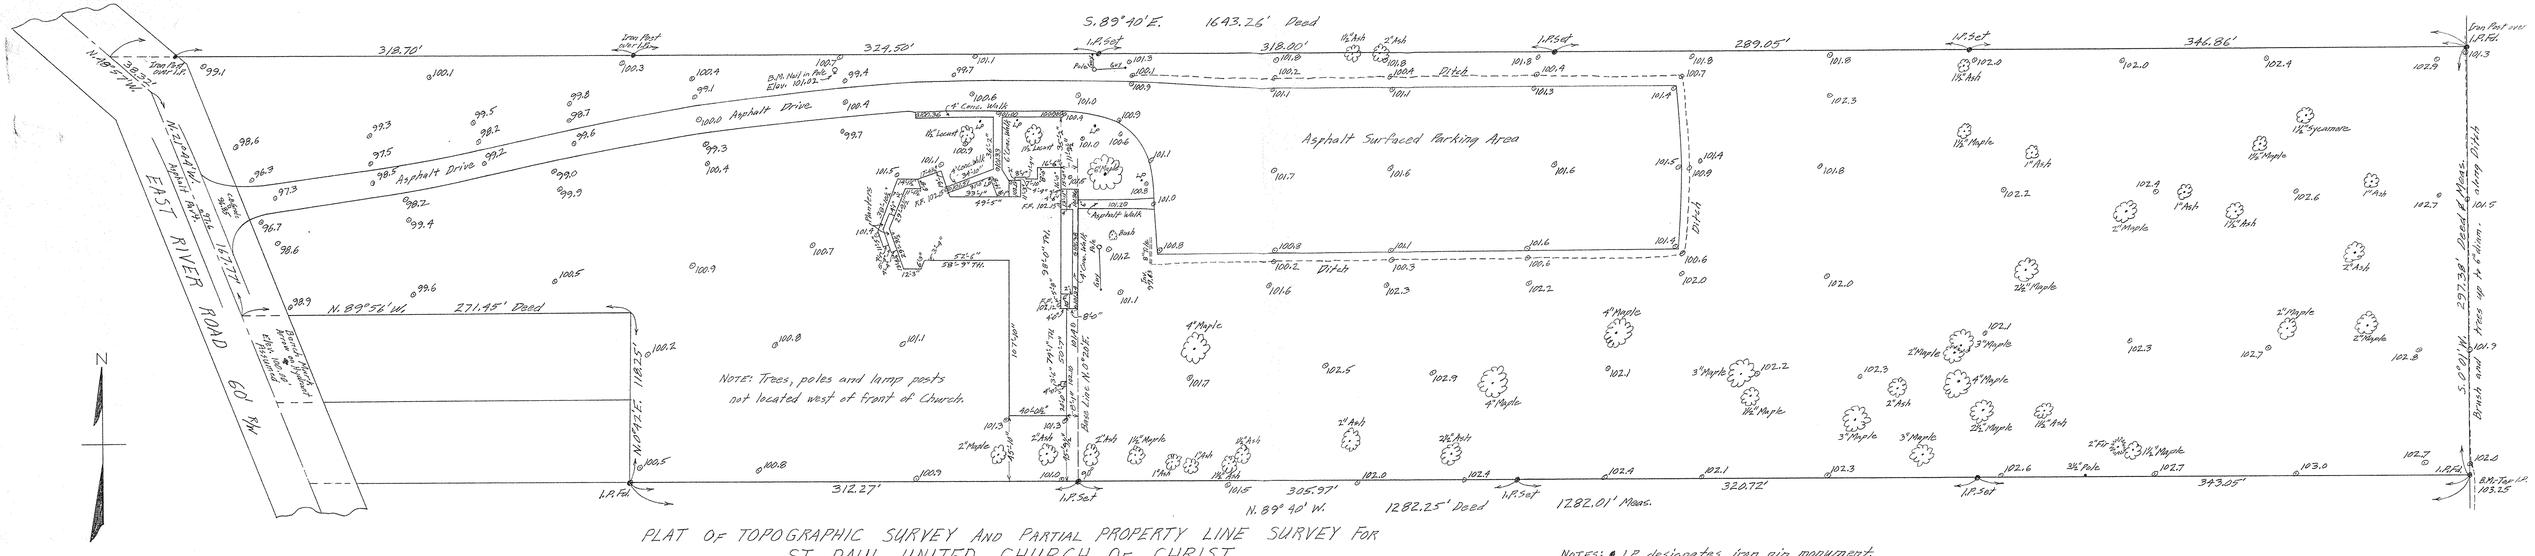

PLAT OF TOPOGRAPHIC SURVEY AND PARTIAL PROPERTY LINE SURVEY FOR
ST. PAUL UNITED CHURCH OF CHRIST
SECTION NO. 4 CARLISLE TOWNSHIP
LORAIN COUNTY OHIO
SCALE: 1" = 40' AUGUST 1963
GARY E. PENFOUND REG. SURVEYOR NO. 4457

NOTES: • I.P. designates iron pin monument.
⊙ designates point of observed elevation.
• LP designates location of decorative lamp post.
F.F. designates Actual Finish Floor elevation.
(Finish Floor Elev. shown as 102.67 on Plot Plan of Church plans.)