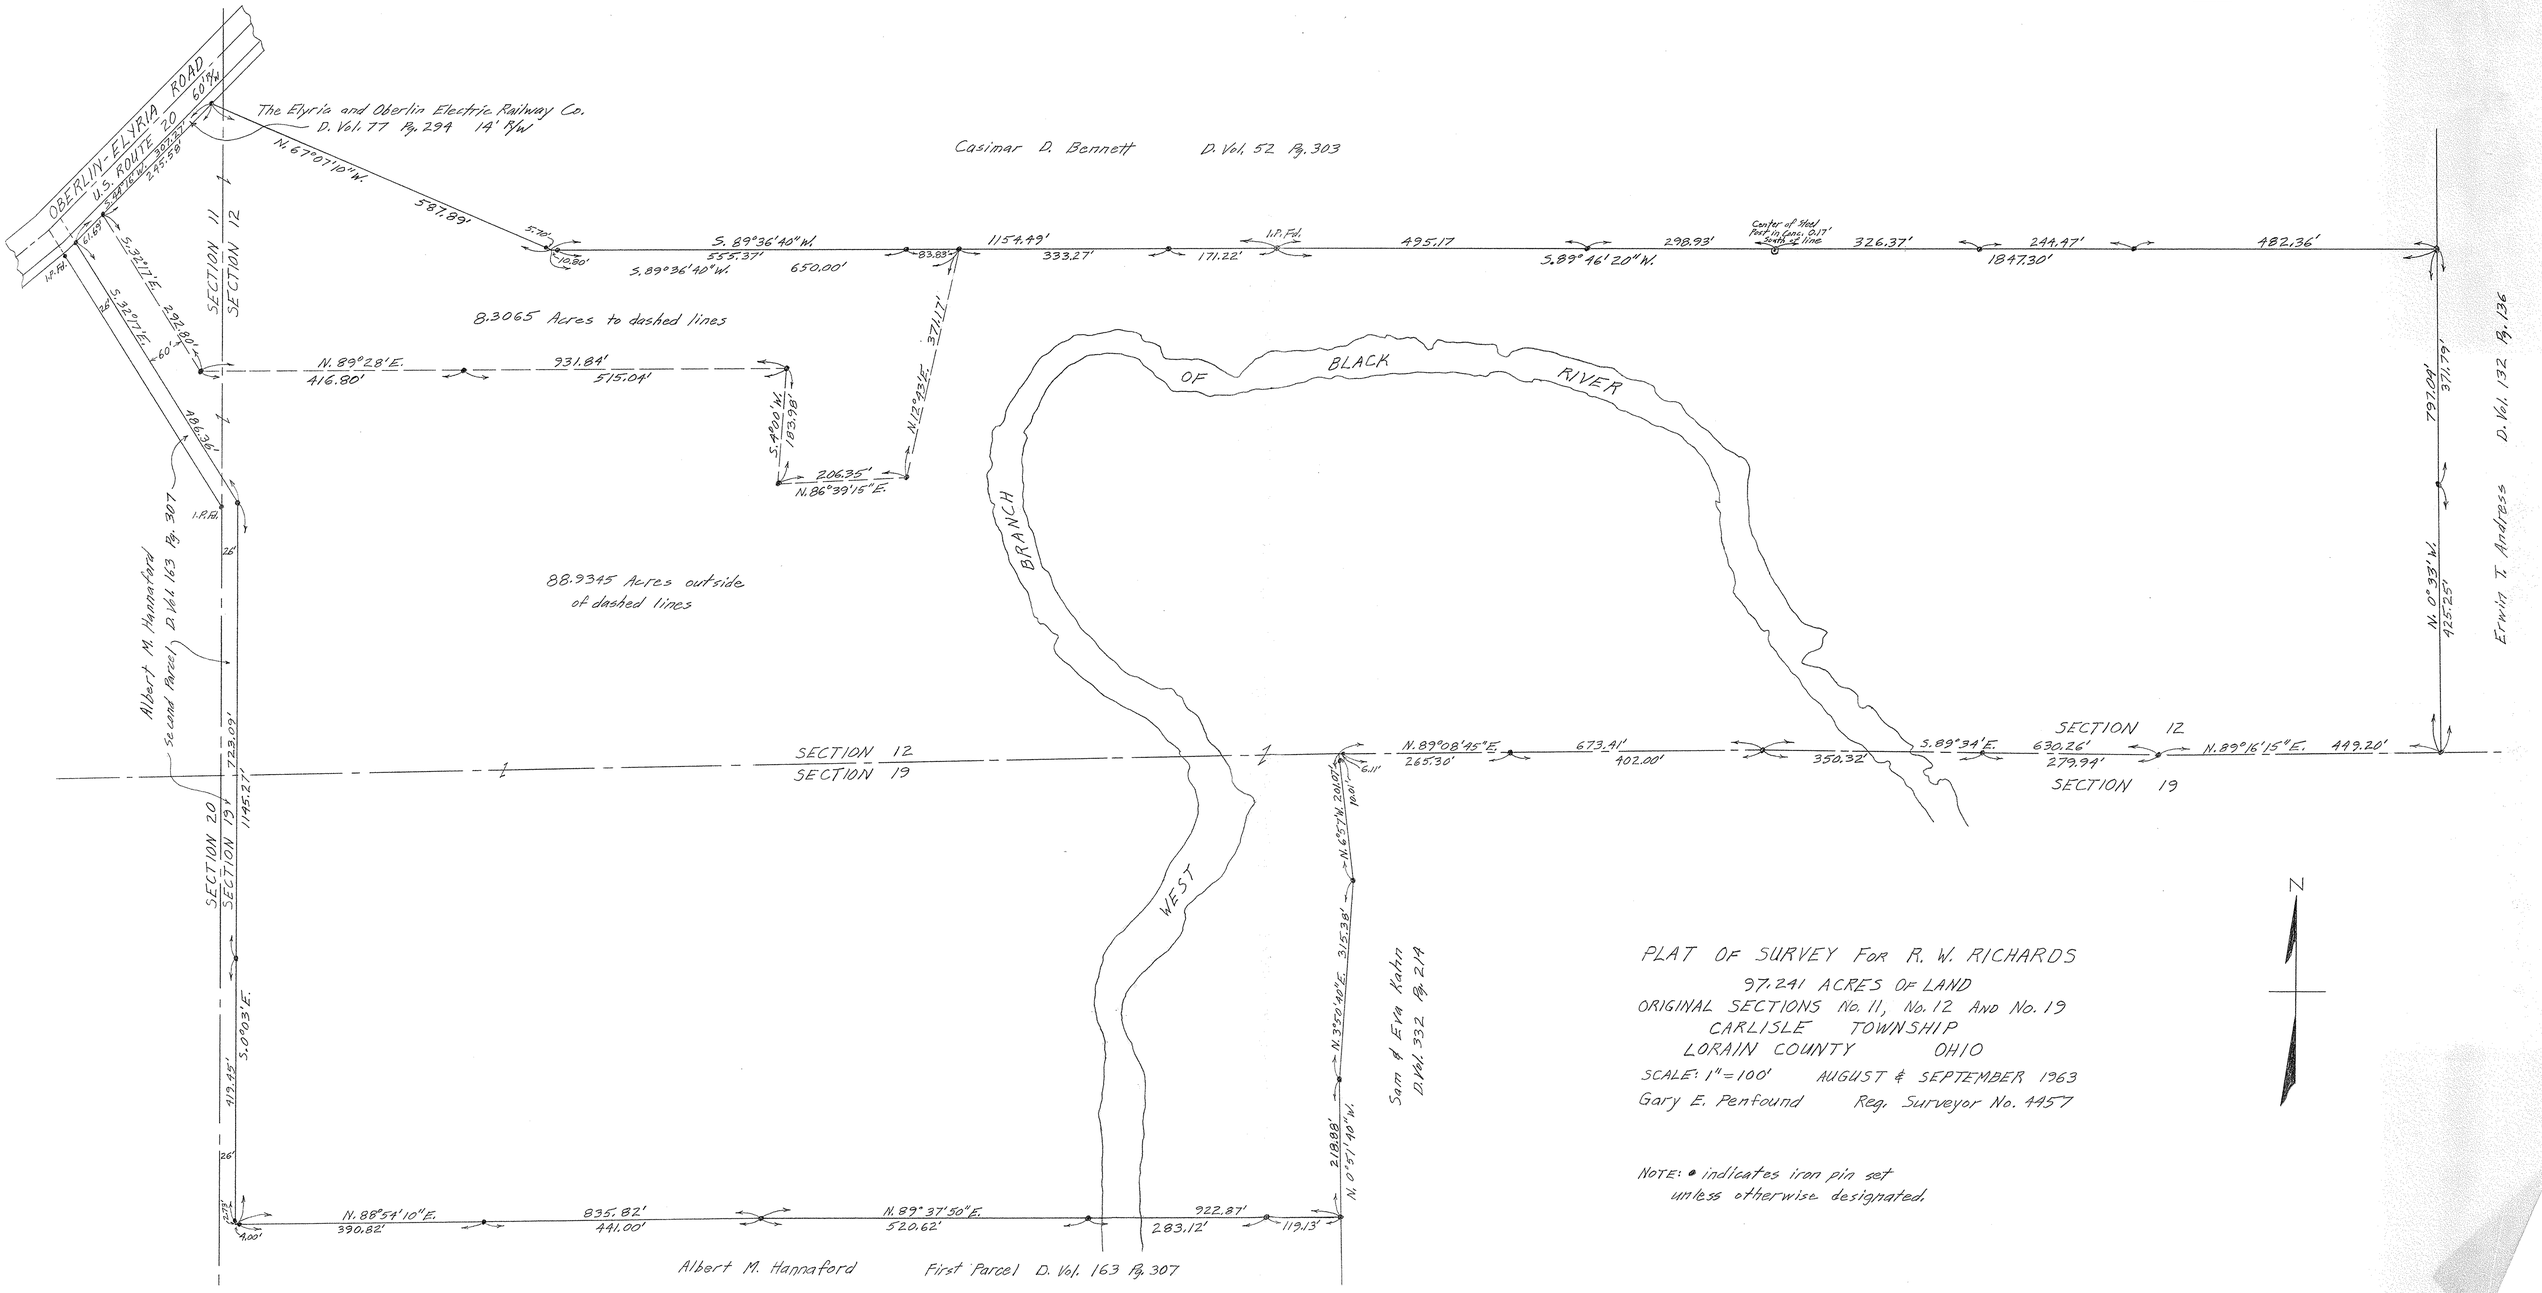
OBERLIN-ELYRIA ROAD
U.S. ROUTE 20
60' R/W
The Elyria and Oberlin Electric Railway Co.
D. Vol. 77 Pg. 294 14' R/W
Casimar D. Bennett D. Vol. 52 Pg. 303
N. 67°07'10"W.
587.89'
S. 89°36'40"W.
555.37'
650.00'
S. 89°36'40"W.
1154.49'
333.27'
171.22'
495.17
298.93'
S. 89°46'20"W.
Center of Mod. Roof in Canal 0.17' South of line
326.37'
244.47'
1847.30'
482.36'
SECTION 11
SECTION 12
8.3065 Acres to dashed lines
N. 89°28'E.
416.80'
931.84'
515.04'
S. 4°00'W.
183.98'
N. 12°23'E.
371.17'
206.35'
N. 86°39'15"E.
OF BLACK RIVER
BRANCH
88.9345 Acres outside of dashed lines
797.04'
371.79'
N. 0°33'W.
425.25'
Erwin T. Andress D. Vol. 132 Pg. 136
Albert M. Hannaford Second Parcel D. Vol. 163 Pg. 307
SECTION 12
SECTION 19
N. 89°08'45"E.
265.30'
673.41'
402.00'
S. 89°34'E.
350.32'
630.26'
279.94'
N. 89°16'15"E.
449.20'
SECTION 20
SECTION 19
1145.27'
S. 0°03'E.
419.45'
WEST
N. 6°57'W. 201.07'
N. 3°50'40"E. 315.38'
N. 0°51'40"W.
218.88'
Sam & Eva Kahn D. Vol. 332 Pg. 214
N. 88°54'10"E.
390.82'
835.82'
441.00'
N. 89°37'50"E.
520.62'
922.87'
283.12'
119.13'
Albert M. Hannaford First Parcel D. Vol. 163 Pg. 307
N
PLAT OF SURVEY FOR R. W. RICHARDS
97.241 ACRES OF LAND
ORIGINAL SECTIONS No. 11, No. 12 AND No. 19
CARLISLE TOWNSHIP
LORAIN COUNTY OHIO
SCALE: 1" = 100' AUGUST & SEPTEMBER 1963
Gary E. Penfound Reg. Surveyor No. 4457
NOTE: • indicates iron pin set unless otherwise designated.