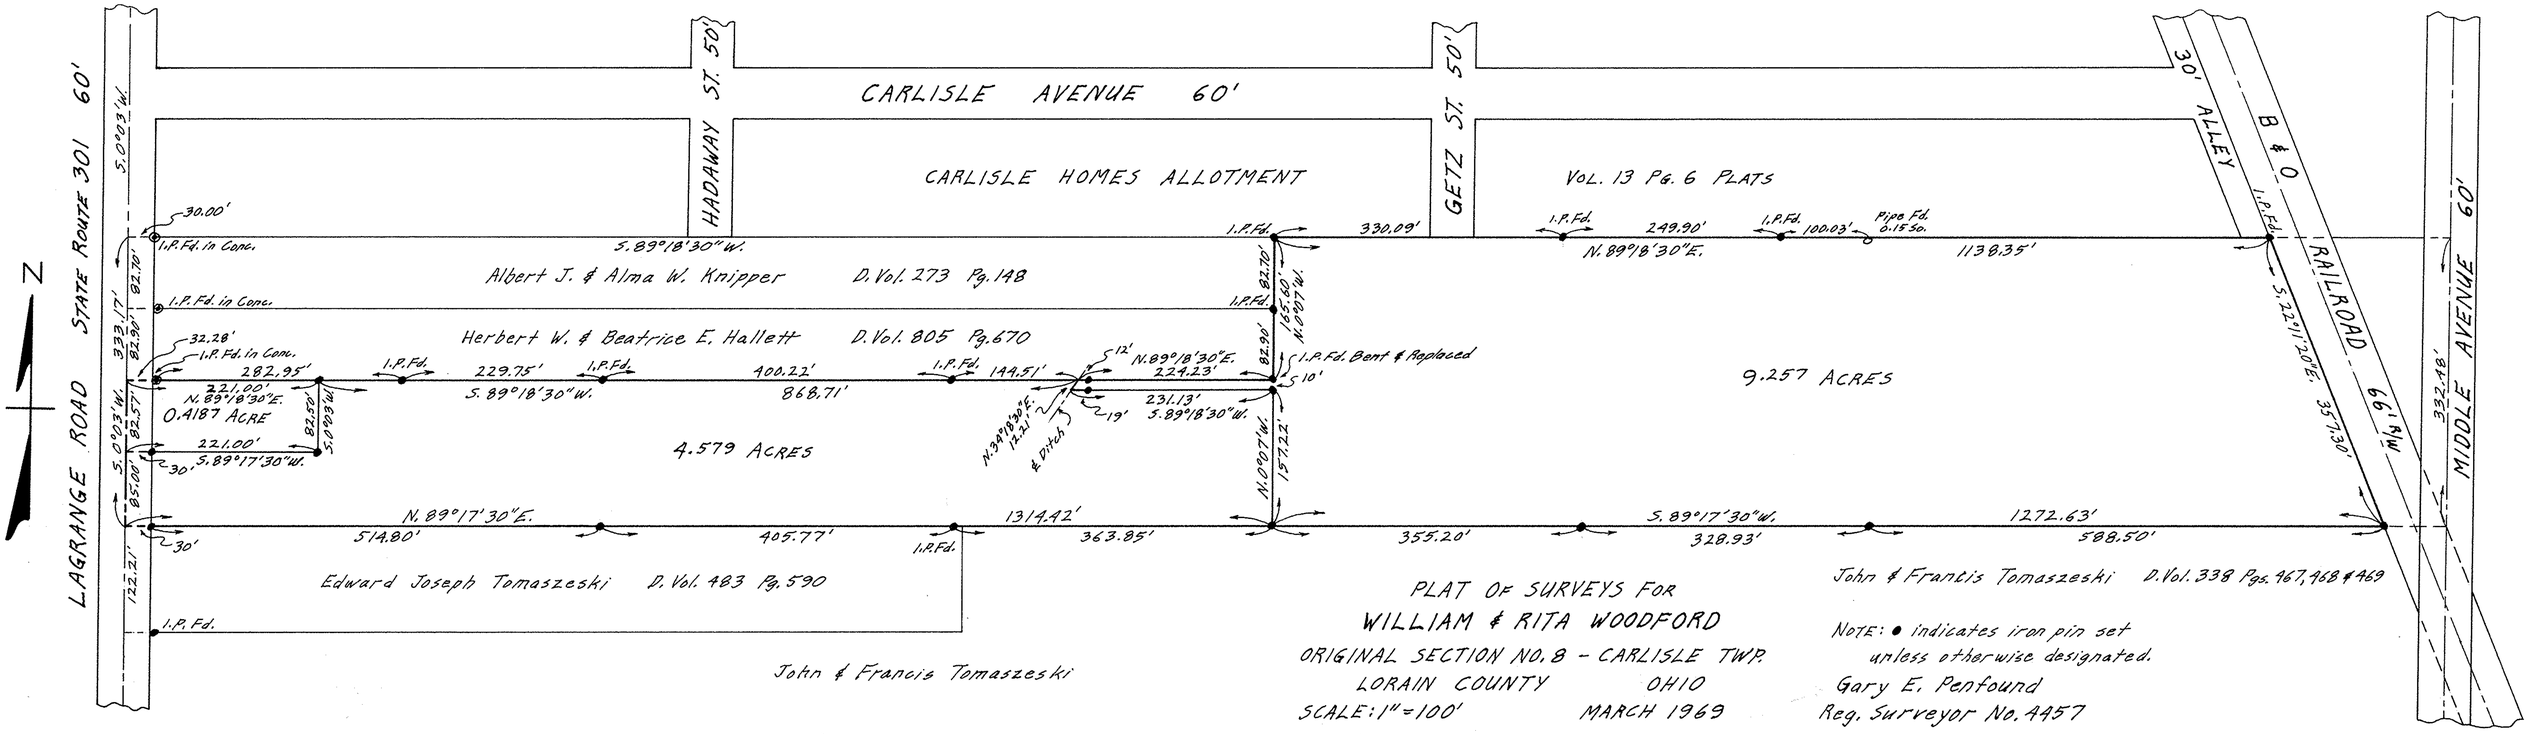
N
LAGRANGE ROAD STATE ROUTE 301 60'
CARLISLE AVENUE 60'
HADAWAY ST. 50'
GETZ ST. 50'
30' ALLEY
B & O RAILROAD 66' R/W
MIDDLE AVENUE 60'
CARLISLE HOMES ALLOTMENT
VOL. 13 PG. 6 PLATS
Albert J. & Alma W. Knipper D. Vol. 273 Pg. 148
Herbert W. & Beatrice E. Hallett D. Vol. 805 Pg. 670
Edward Joseph Tomaszeski D. Vol. 483 Pg. 590
John & Francis Tomaszeski
John & Francis Tomaszeski D. Vol. 338 Pgs. 467, 468 & 469
9.257 ACRES
4.579 ACRES
0.4187 ACRE
S. 0°03' W.
30.00'
I.P. Fd. in Conc.
S. 89°18'30" W.
333.17'
82.70'
82.90'
32.28'
282.95'
221.00'
N. 89°18'30" E.
229.75'
400.22'
144.51'
868.71'
I.P. Fd.
I.P. Fd. Bent & Replaced
N. 89°18'30" E. 224.23'
231.13' S. 89°18'30" W.
N. 34°18'30" E. 12.21'
& Ditch
N. 0°07' W. 157.22'
185.60' N. 0°07' W.
330.09'
249.90'
100.03'
Pipe Fd. 0.15 So.
N. 89°18'30" E.
1138.35'
S. 22°11'20" E. 357.30'
332.48'
82.50'
S. 0°03' W.
221.00'
S. 89°17'30" W.
85.00'
122.21'
N. 89°17'30" E.
514.80'
405.77'
1314.42'
363.85'
355.20'
S. 89°17'30" W.
328.93'
1272.63'
588.50'
PLAT OF SURVEYS FOR
WILLIAM & RITA WOODFORD
ORIGINAL SECTION NO. 8 - CARLISLE TWP.
LORAIN COUNTY OHIO
SCALE: 1" = 100'
MARCH 1969
NOTE: ● indicates iron pin set unless otherwise designated.
Gary E. Penfound
Reg. Surveyor No. 4457