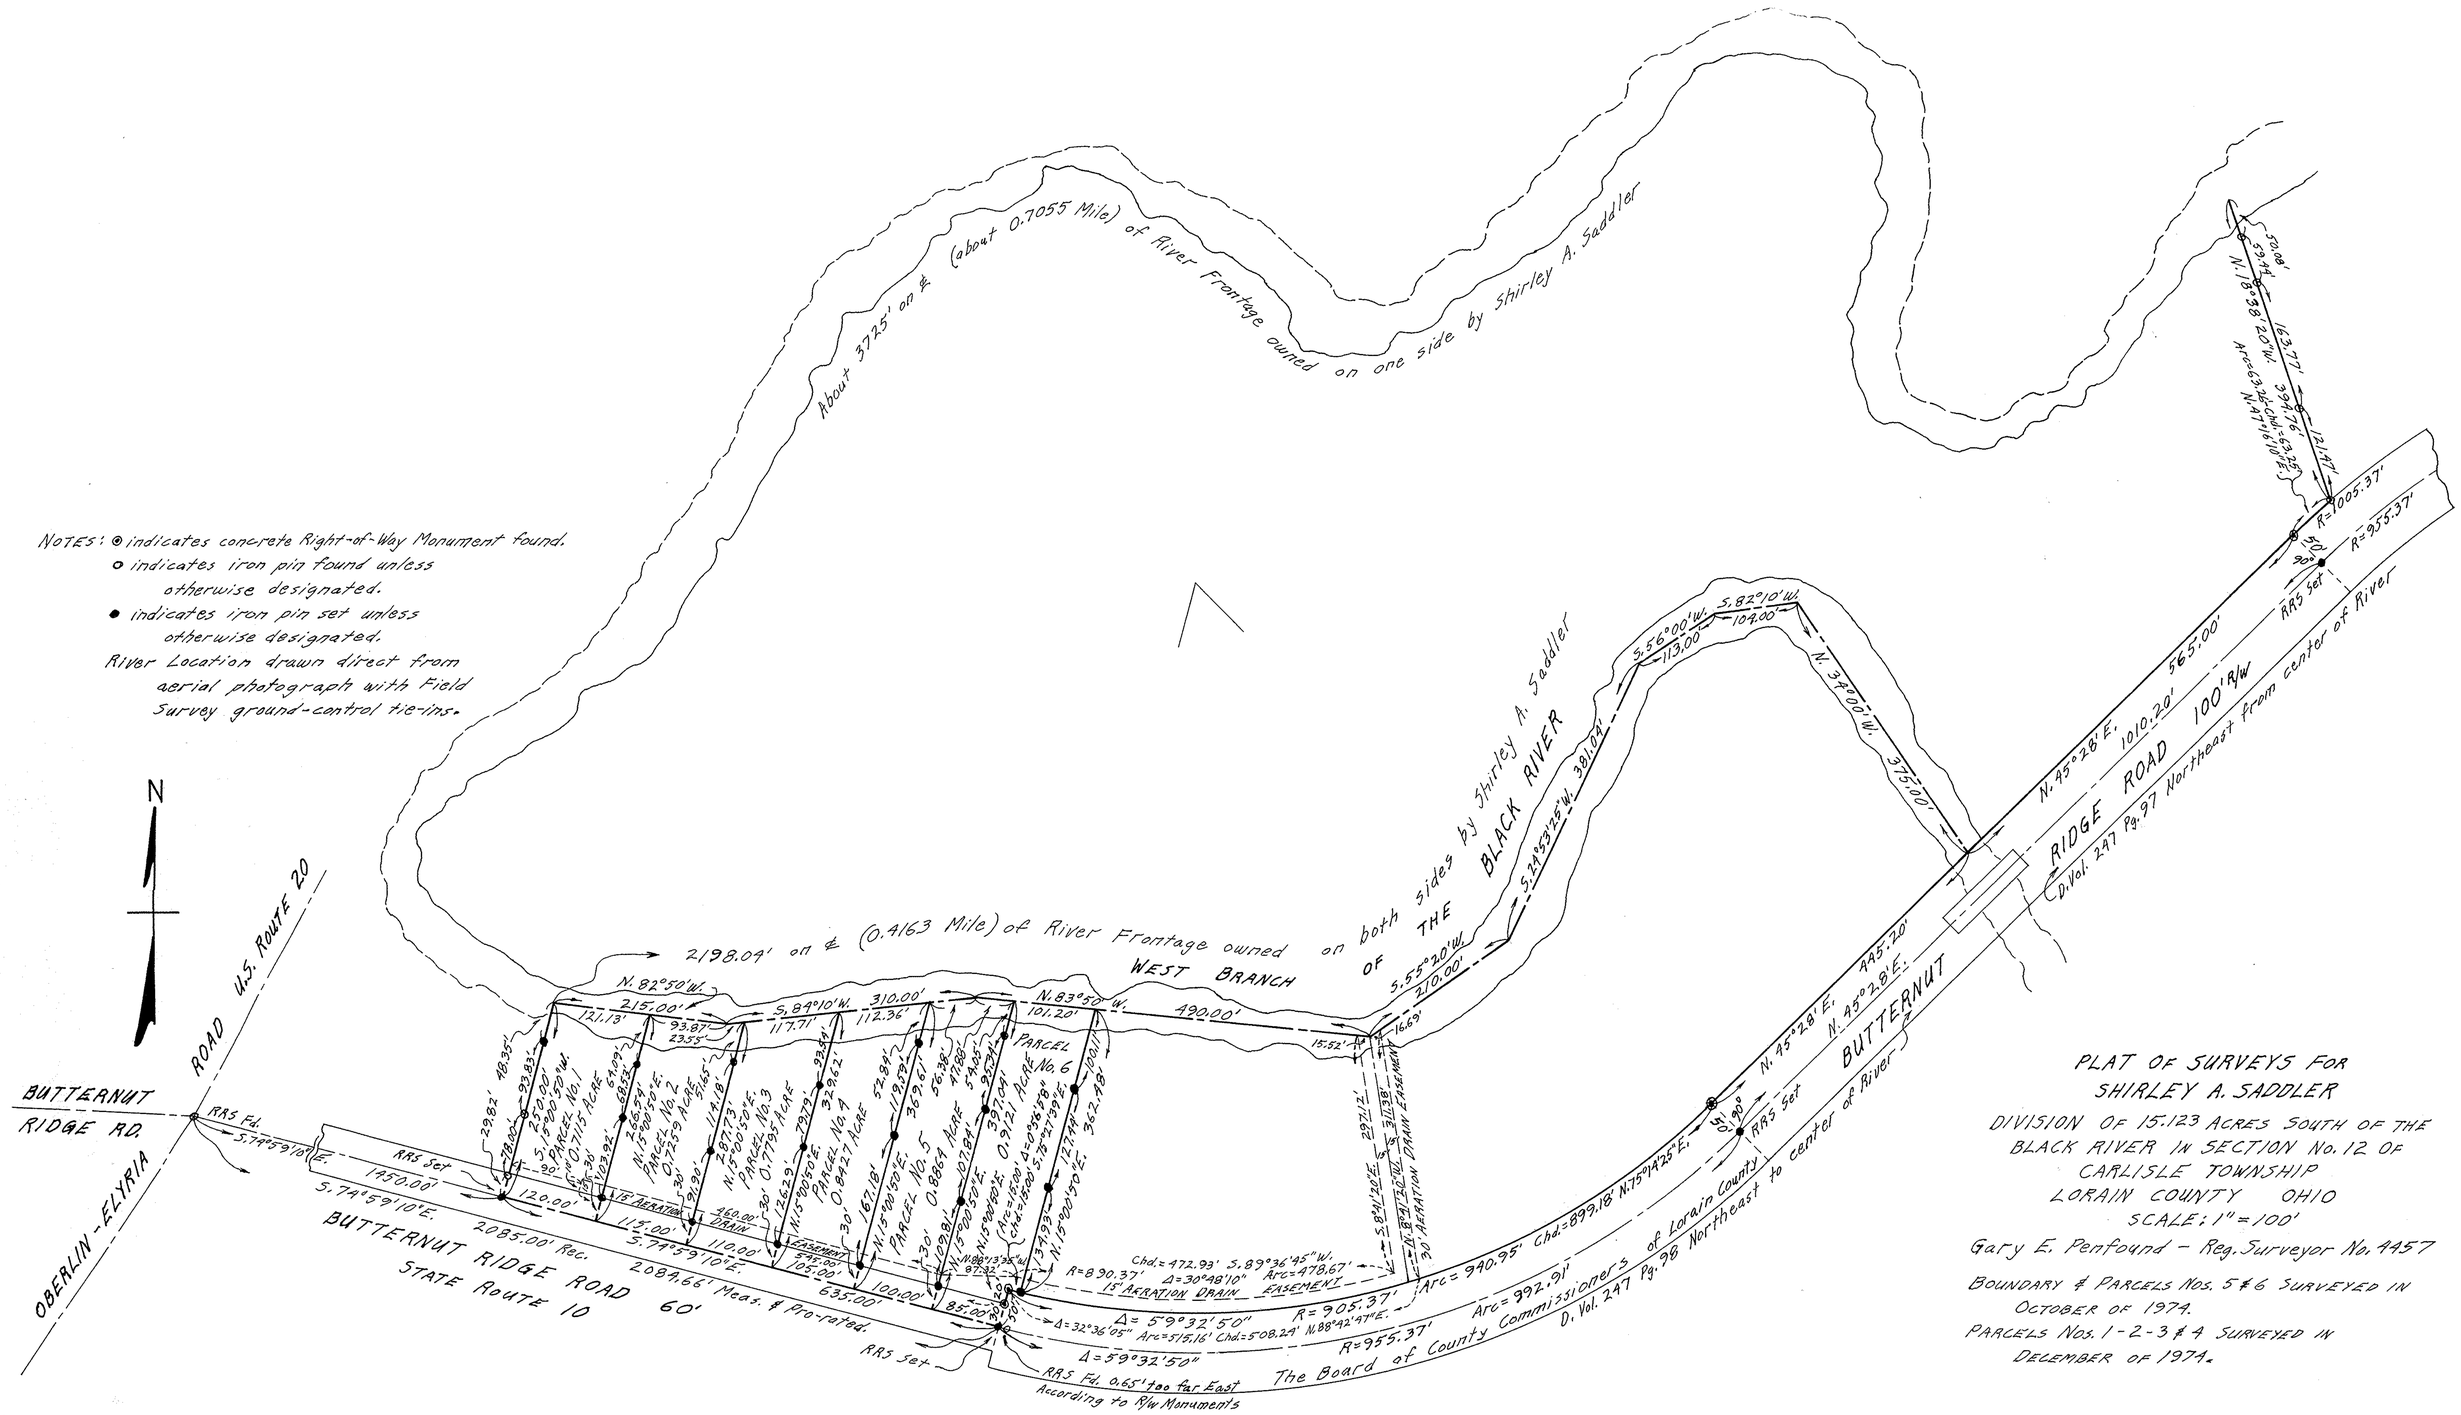

PLAT OF SURVEYS FOR
SHIRLEY A. SADDLER

DIVISION OF 15.123 ACRES SOUTH OF THE BLACK RIVER IN SECTION No. 12 OF CARLISLE TOWNSHIP
LORAIN COUNTY OHIO
SCALE: 1" = 100'

Gary E. Penfound - Reg. Surveyor No. 4457

BOUNDARY & PARCELS Nos. 5 & 6 SURVEYED IN OCTOBER OF 1974.
PARCELS Nos. 1-2-3 & 4 SURVEYED IN DECEMBER OF 1974.

10-00-012