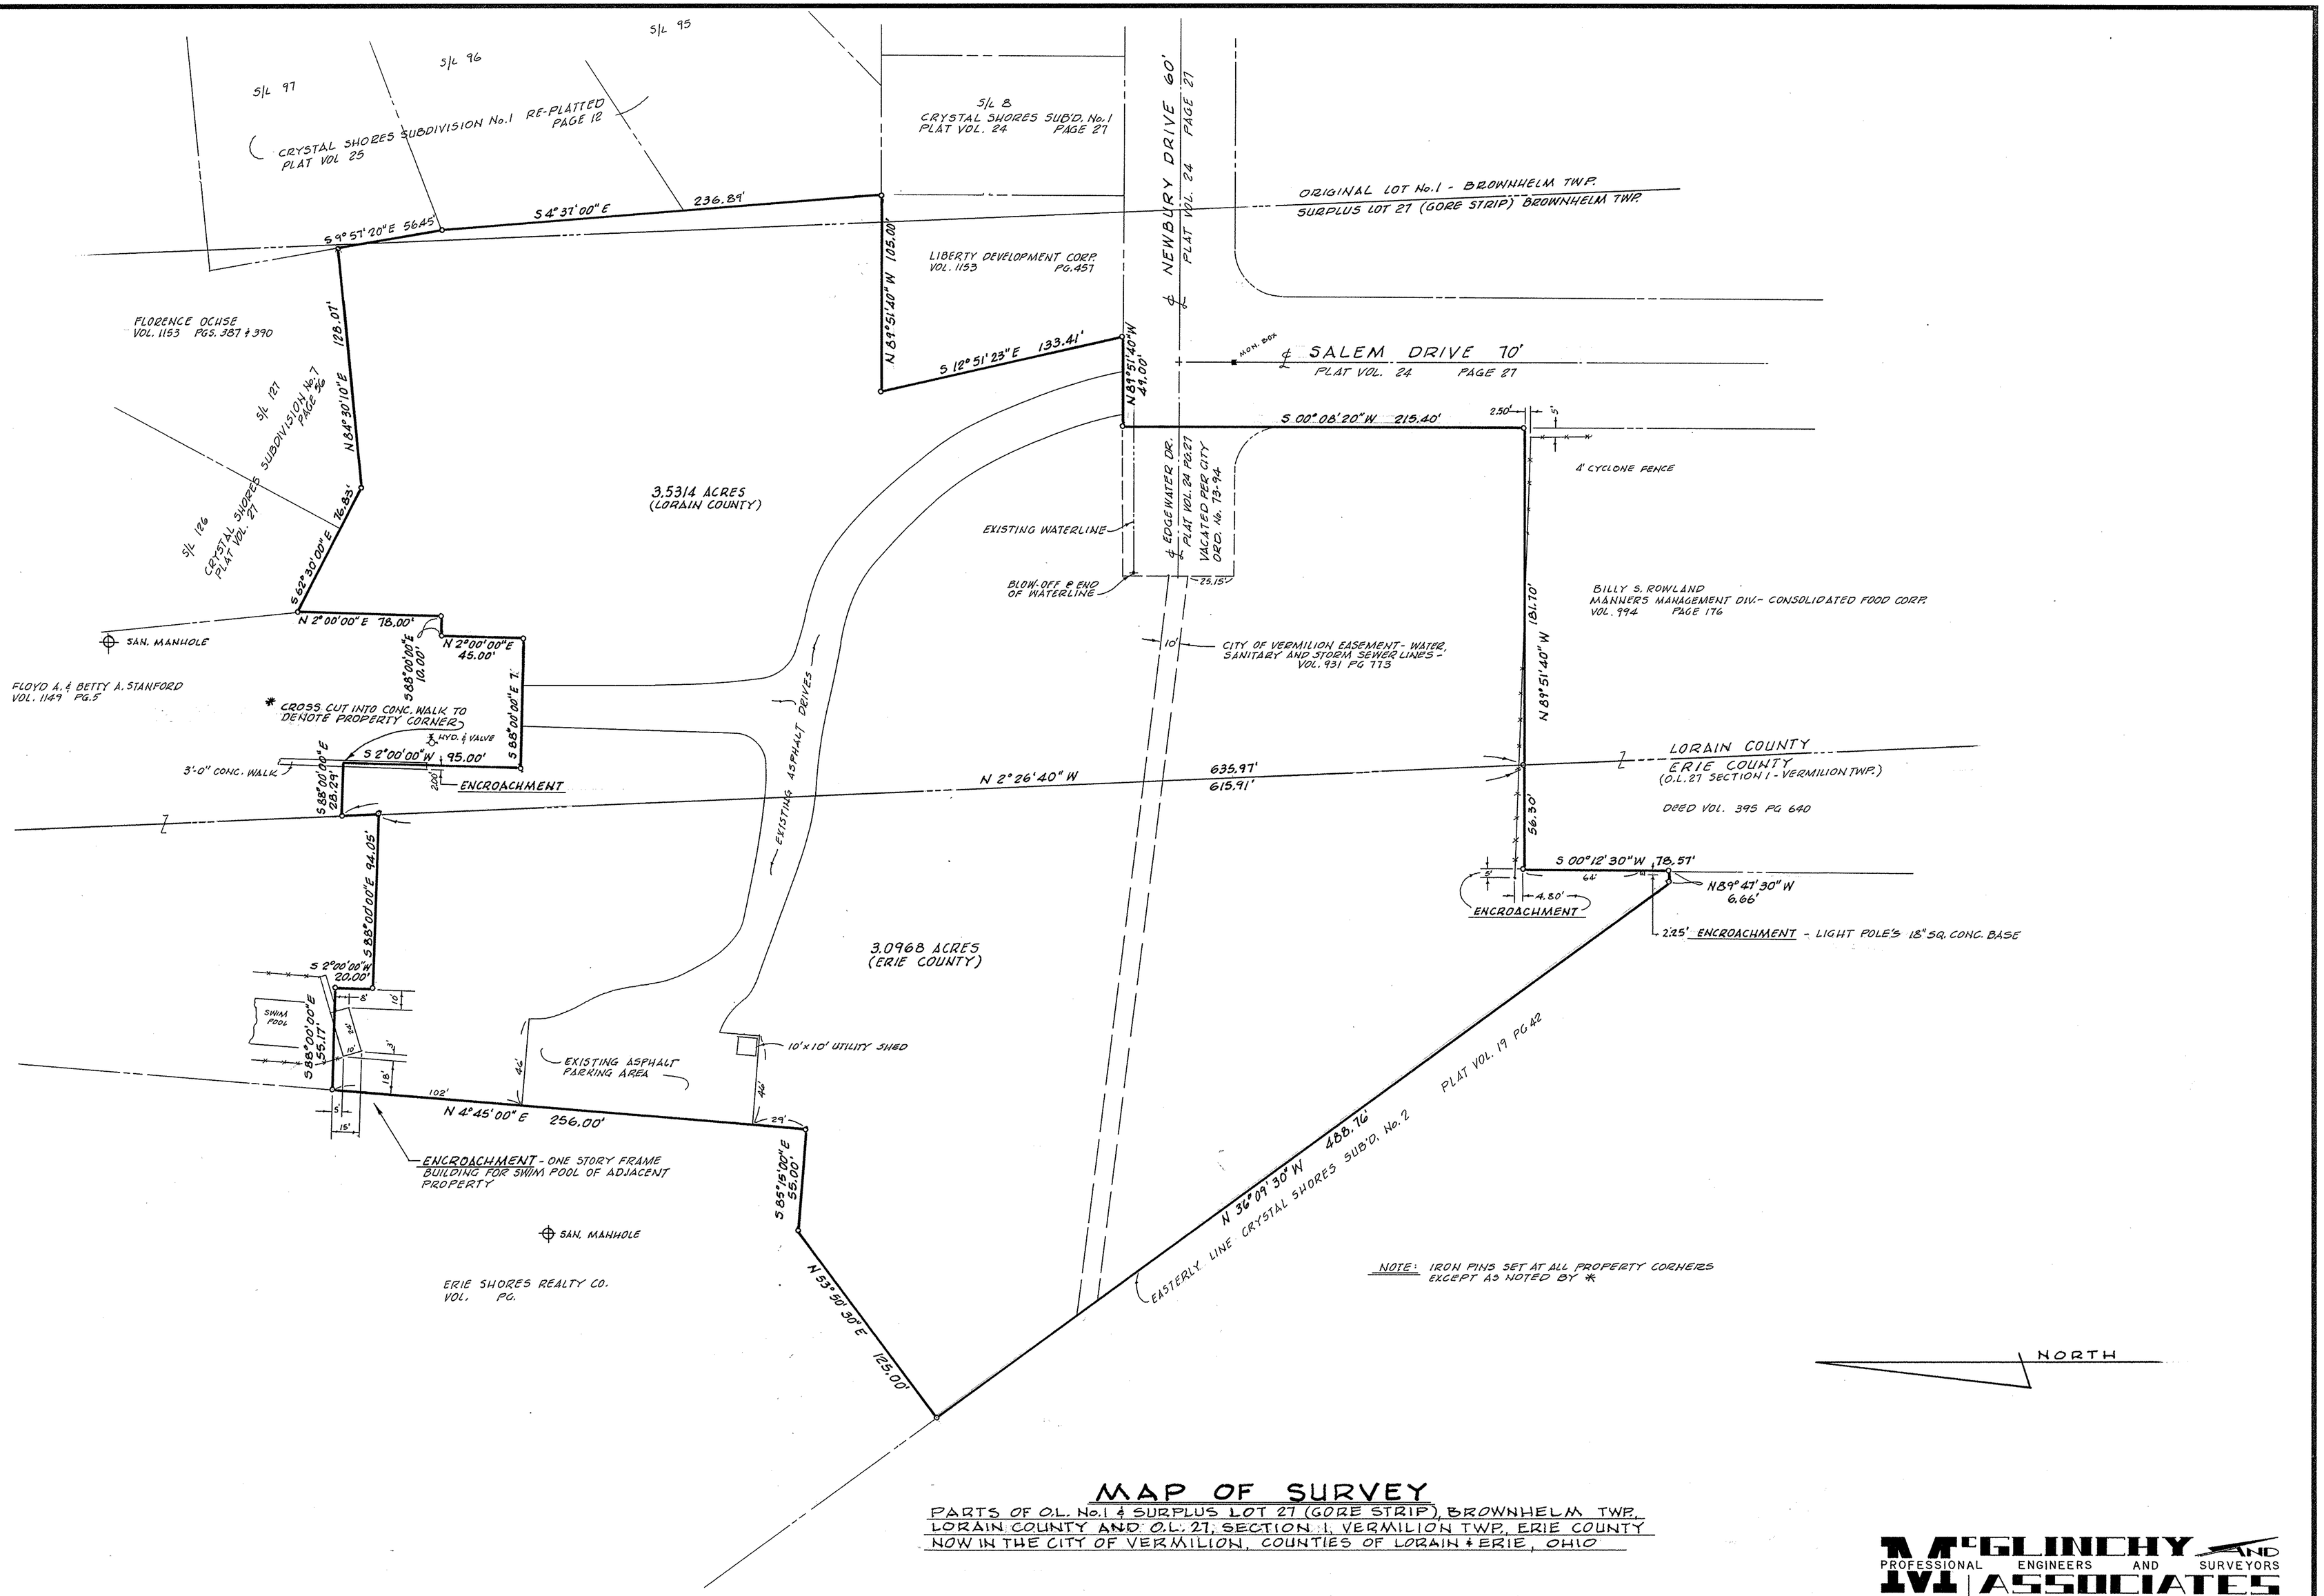

MAP OF SURVEY

PARTS OF O.L. No.1 & SURPLUS LOT 27 (GORE STRIP), BROWNHELM TWP. LORAIN COUNTY AND O.L. 27, SECTION 1, VERMILION TWP., ERIE COUNTY NOW IN THE CITY OF VERMILION, COUNTIES OF LORAIN & ERIE, OHIO

McGLINCHY AND ASSOCIATES
PROFESSIONAL ENGINEERS AND SURVEYORS
538 WEST BROAD ST. ELYRIA, OHIO

SCALE: 1" = 40' DRAWN BY: R. THOMAS
DATE: 1-25-77 JOB NO: 761500