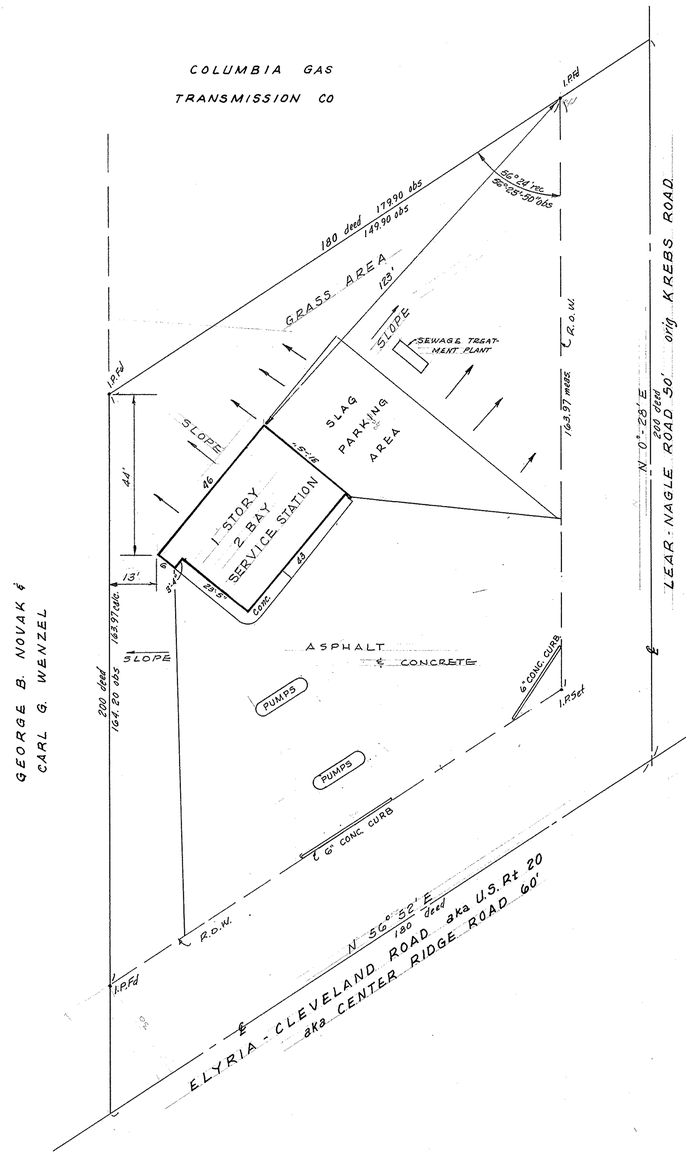


N

1" = 20'

THIS IS TO CERTIFY THAT ON MARCH 24, 1977 I MADE AN ACCURATE SURVEY OF THE PREMISES SHOWN HEREON AND THAT THERE ARE NO EASEMENTS OR ENCROACHMENTS VISIBLE ON THE GROUND OTHER THAN THOSE SHOWN HEREON.

Lawrence V. McGlinchy

STORE № 19746
SITE № 5333
GFN № 17841
CITY of NORTH RIDGEVILLE
COUNTY of LORAIN
STATE of OHIO

PLAN of SURVEY for: THE SOUTHLAND CORPORATION
P.P. # 07-00-008-117-032 0.688 acres
PART of ORIG. RIDGEVILLE TWP. LOT 8
NOW IN CITY of NORTH RIDGEVILLE, OH.

McGLINCHY AND ASSOCIATES
PROFESSIONAL ENGINEERS AND SURVEYORS
538 WEST BROAD ST. ELYRIA, OHIO

SCALE: 1" = 20' DRAWN BY: Dav
DATE: MAR. 31, 77 JOB NO: 771703