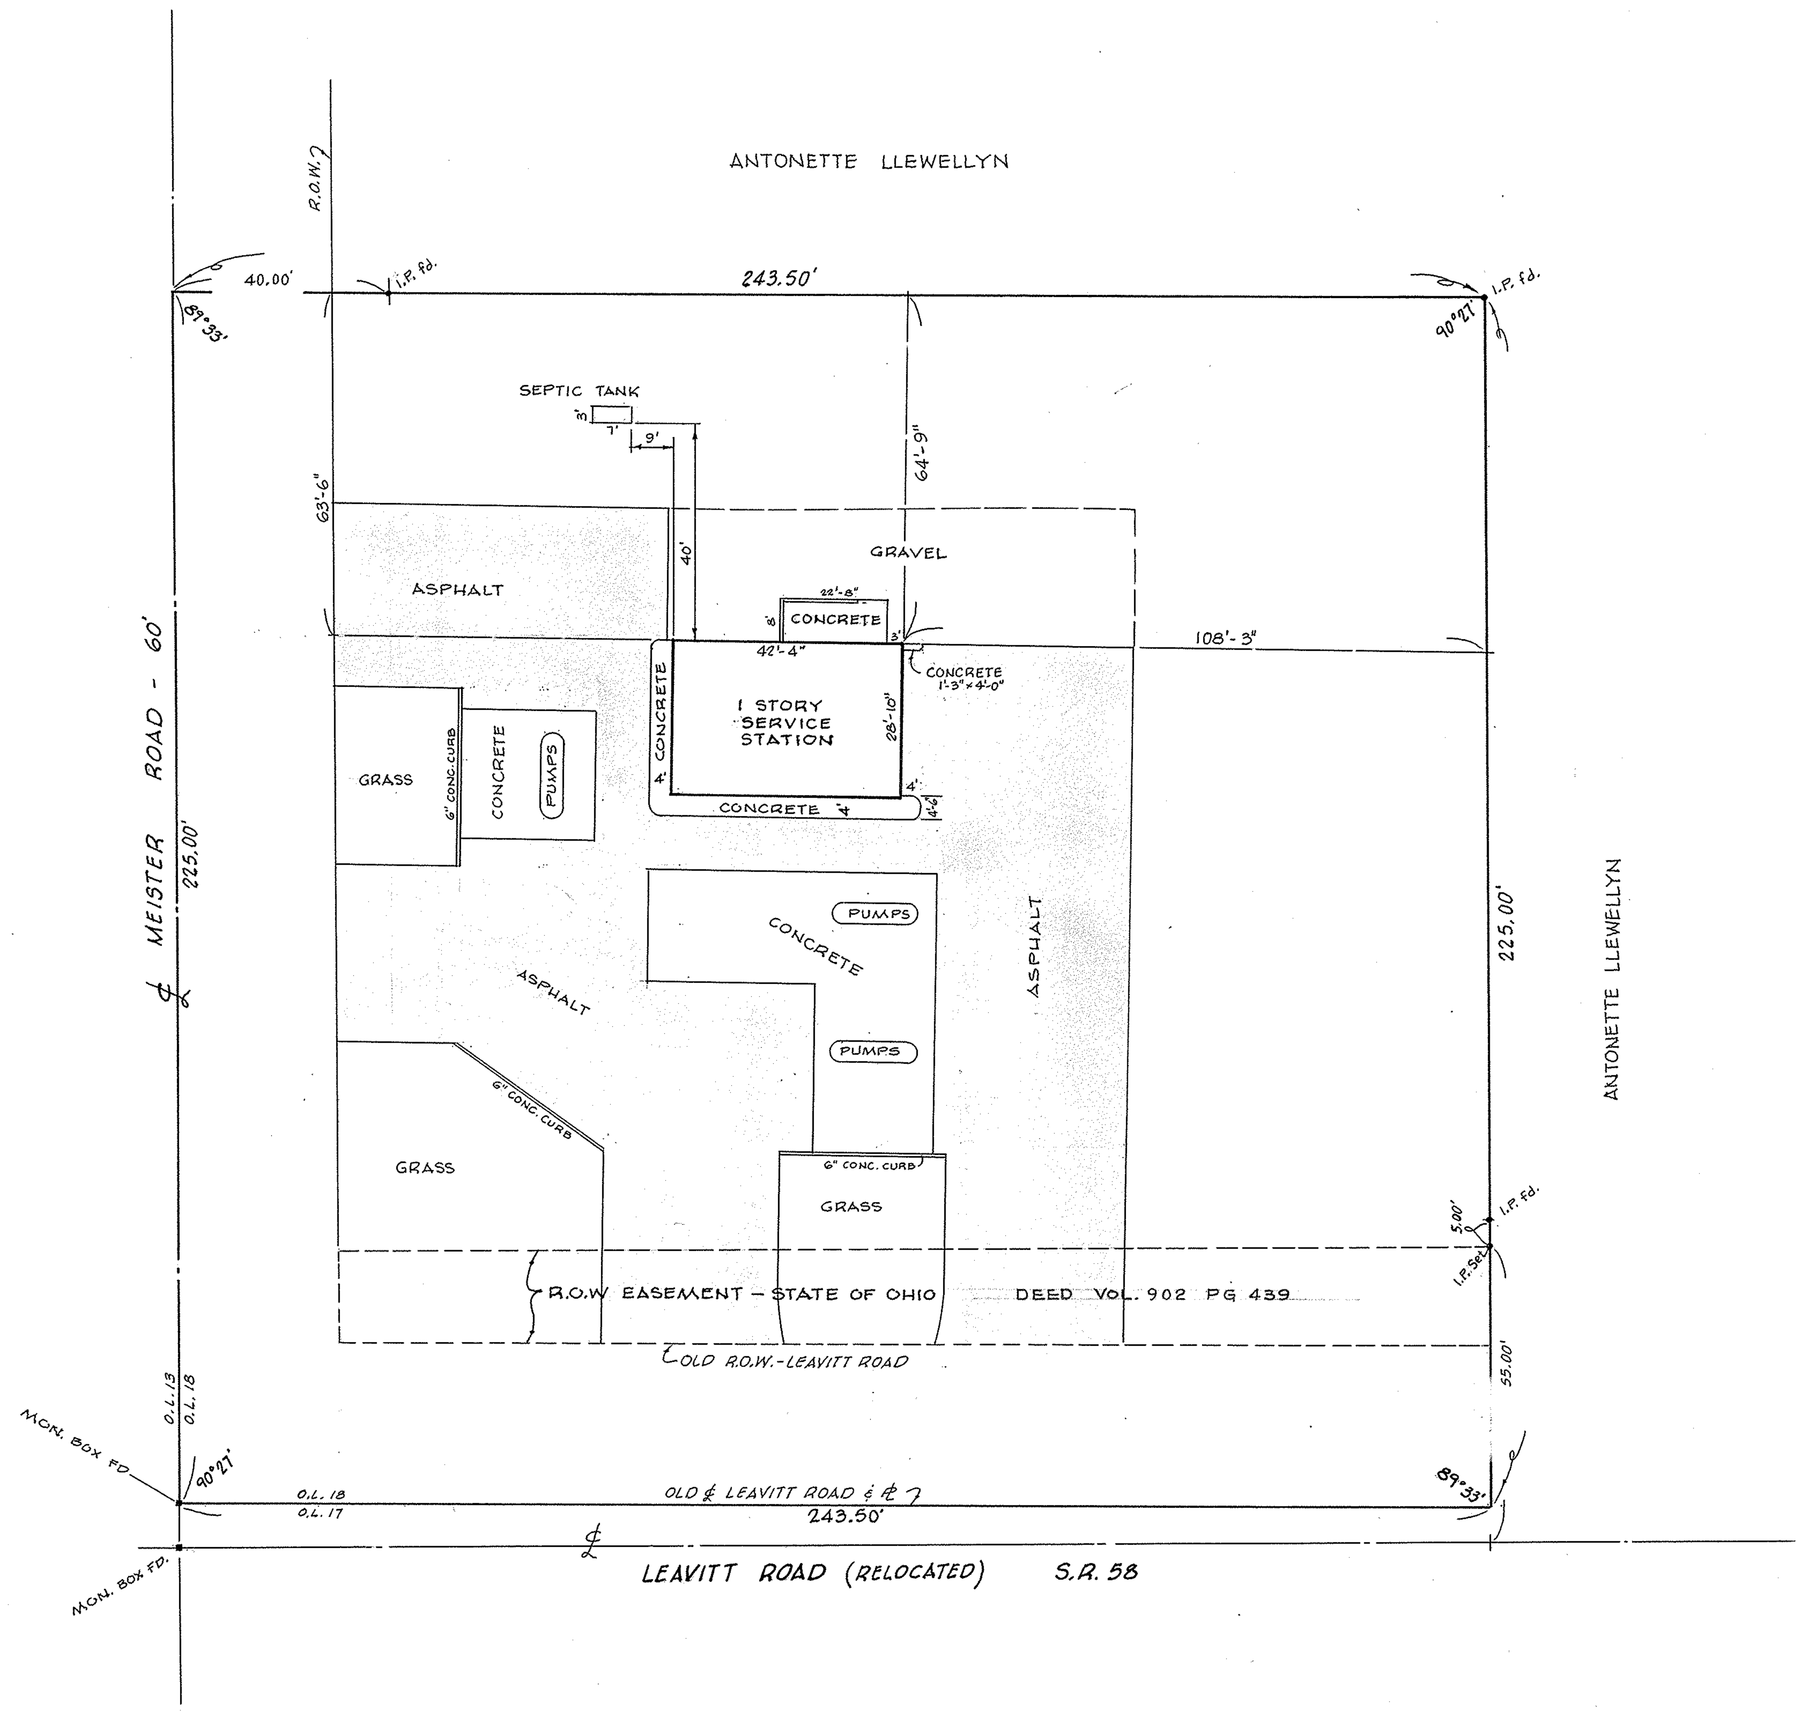

1" = 20'

THIS IS TO CERTIFY THAT ON MARCH 23, 1977 I MADE AN ACCURATE SURVEY OF THE PREMISES SHOWN HEREON AND THAT THERE ARE NO EASEMENTS OR ENCROACHMENTS VISIBLE ON THE GROUND OTHER THAN THOSE SHOWN HEREON.

Lawrence V. McGlinchy

STORE № 19743
SITE № 5215
GFN № 17771
CITY of LORAIN
COUNTY of LORAIN
STATE of OHIO

PLAN of SURVEY for: THE SOUTHLAND CORPORATION
P.P. # 02-02-018-000-015 1.257 ACRES
PART of ORIG. BLACK RIVER TWP.
LOT 18, TRACT 2
NOW IN CITY of LORAIN, OHIO

McGLINCHY AND ASSOCIATES
PROFESSIONAL ENGINEERS AND SURVEYORS
538 WEST BROAD ST. ELYRIA, OHIO

SCALE: 1" = 20' DRAWN BY: R.T.
DATE: MAR. 31, 77 JOB NO: 771705