MAP OF SURVEY
REMAINDER PARCEL

PREPARED FOR

THE ALBERT E. CAMPBELL JR. ESTATE

SITUATED IN THE TOWNSHIP OF ROCHESTER, COUNTY OF LORAIN, STATE OF OHIO AND BEING KNOWN AS PART OF ORIGINAL ROCHESTER LOT 4, TRACT 3. ALSO BEING KNOWN AS PART OF LANDS DEEDED TO ALBERT E.JR. AND FRANCES CAMPBELL IN DEED INSTRUMENT #20010762150 OF LORAIN COUNTY DEED RECORDS.

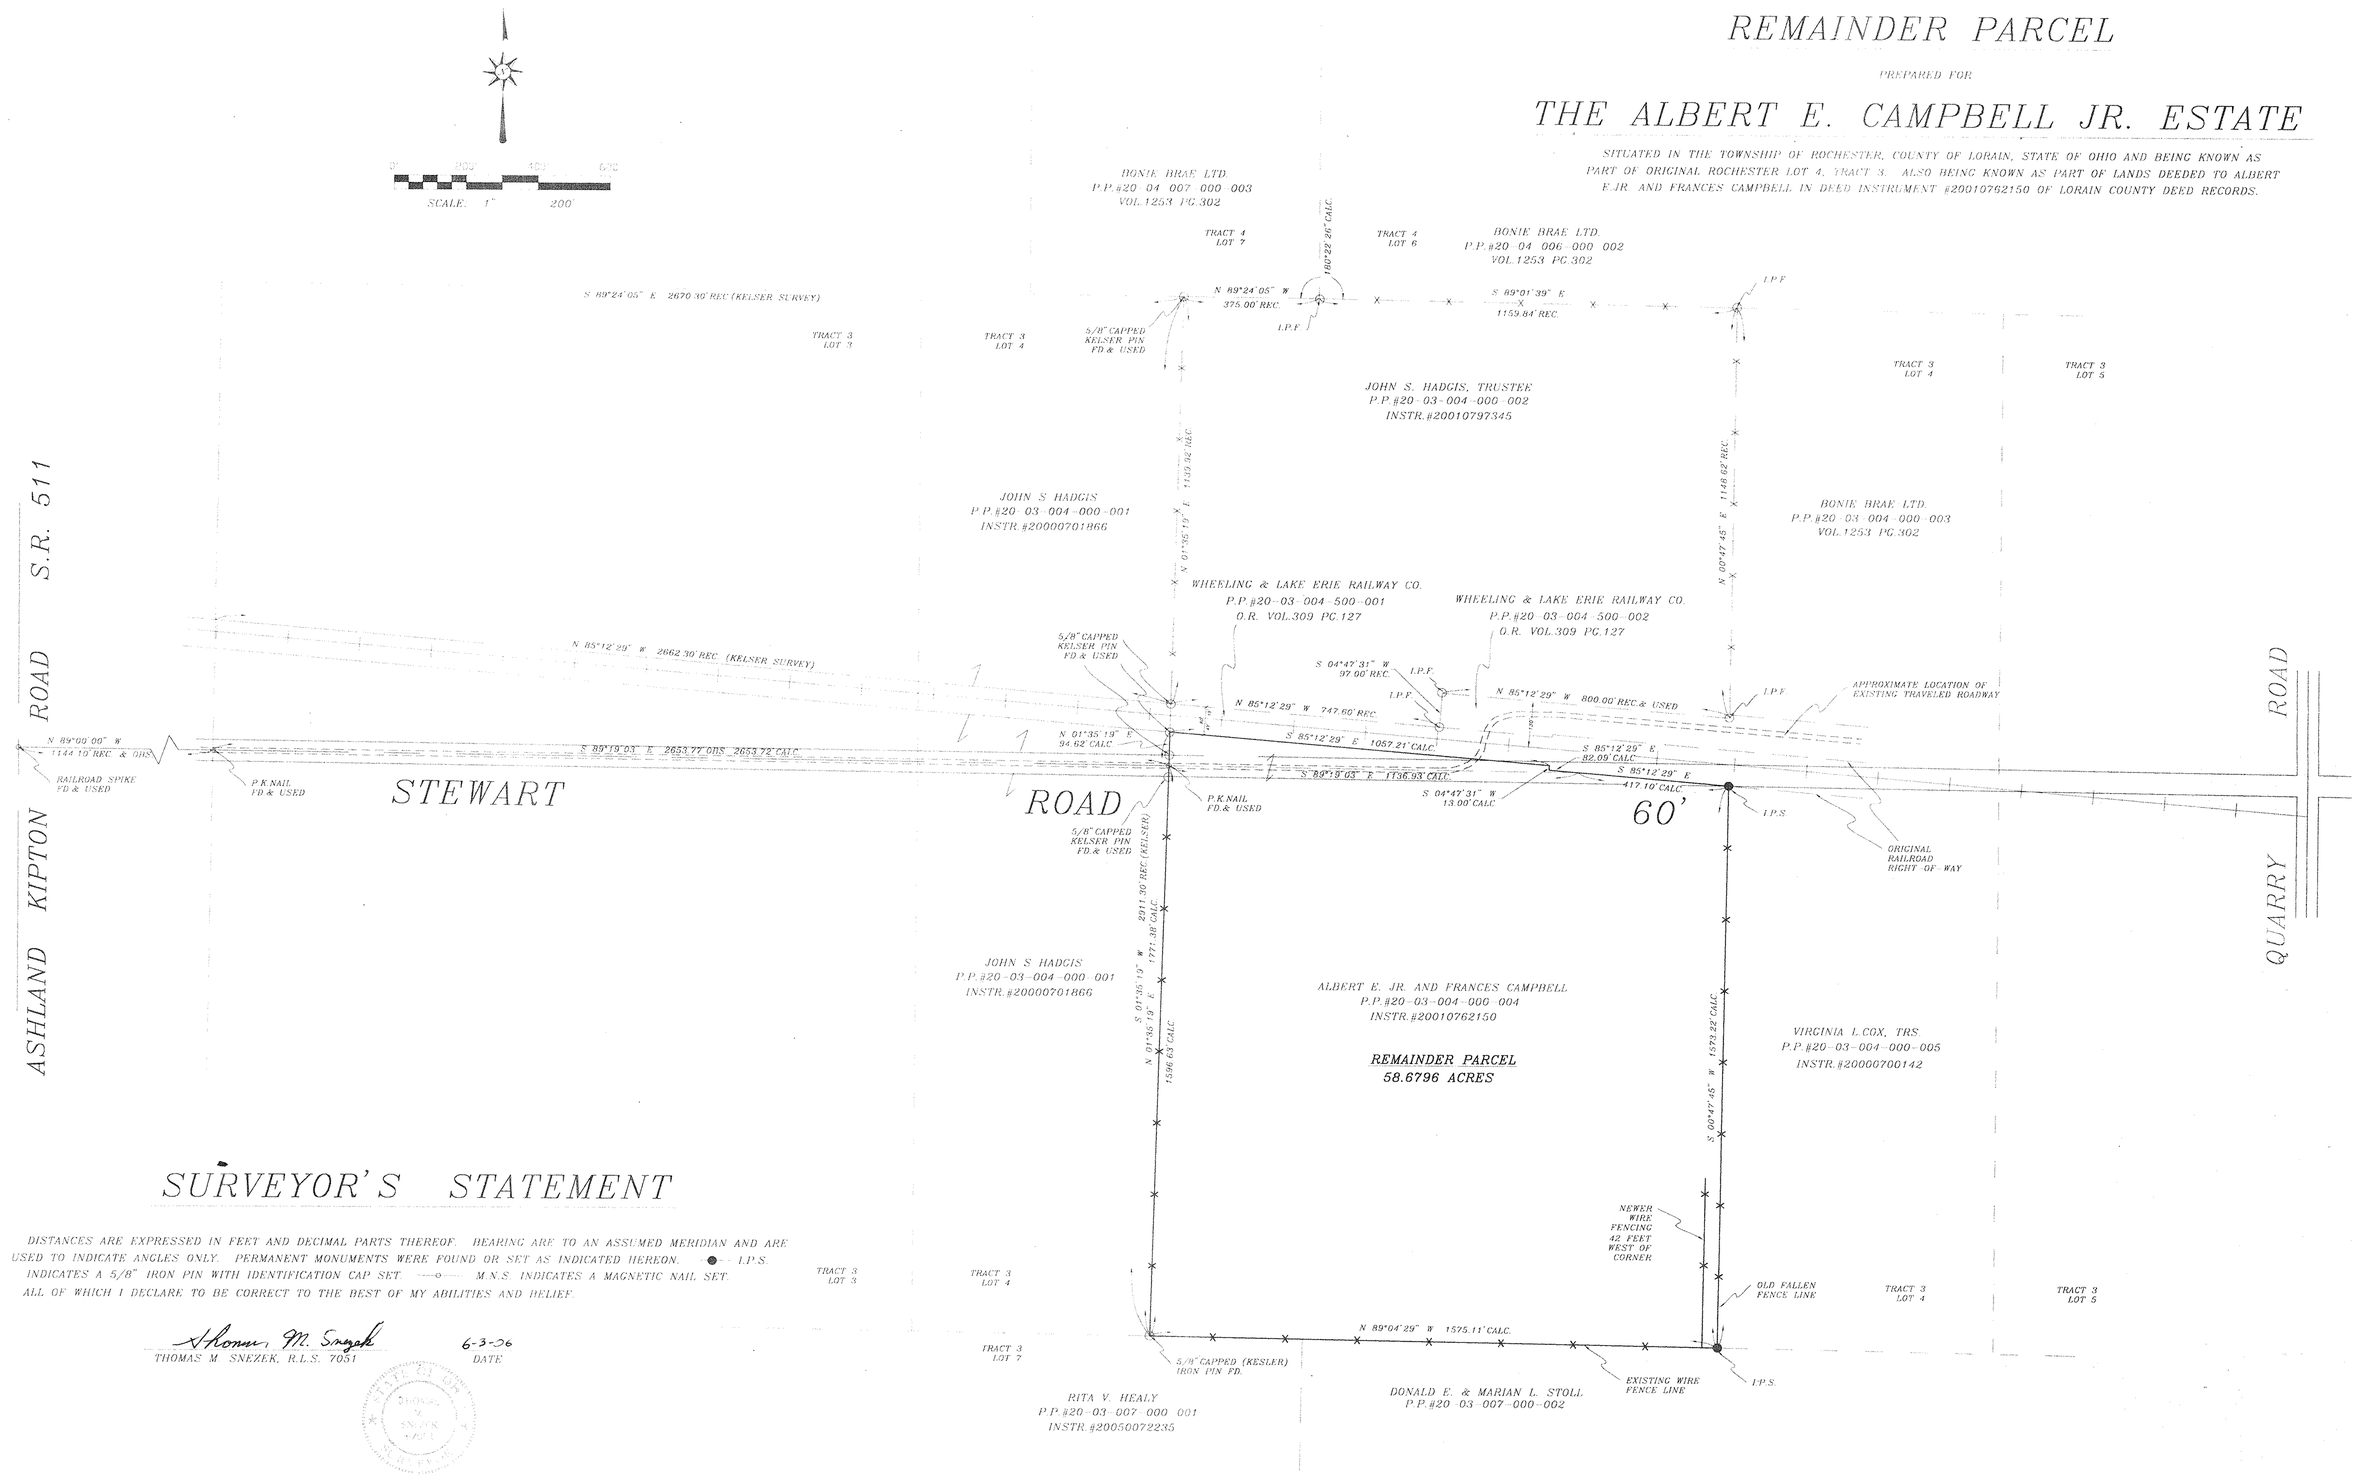

SURVEYOR'S STATEMENT

DISTANCES ARE EXPRESSED IN FEET AND DECIMAL PARTS THEREOF. BEARING ARE TO AN ASSUMED MERIDIAN AND ARE USED TO INDICATE ANGLES ONLY. PERMANENT MONUMENTS WERE FOUND OR SET AS INDICATED HEREON. ● I.P.S. INDICATES A 5/8" IRON PIN WITH IDENTIFICATION CAP SET. —o— M.N.S. INDICATES A MAGNETIC NAIL SET. ALL OF WHICH I DECLARE TO BE CORRECT TO THE BEST OF MY ABILITIES AND BELIEF.

Thomas M. Snezek 6-3-06

THOMAS M. SNEZEK, R.L.S. 7051 DATE

REGISTERED THOMAS M. SNEZEK 7051 STATE OF OHIO

PROJECT #0610 6/3/06

T.M. Pg 20-H