


# Sketch To Accompany Legal Description

Rt 254 Detroit Rd.

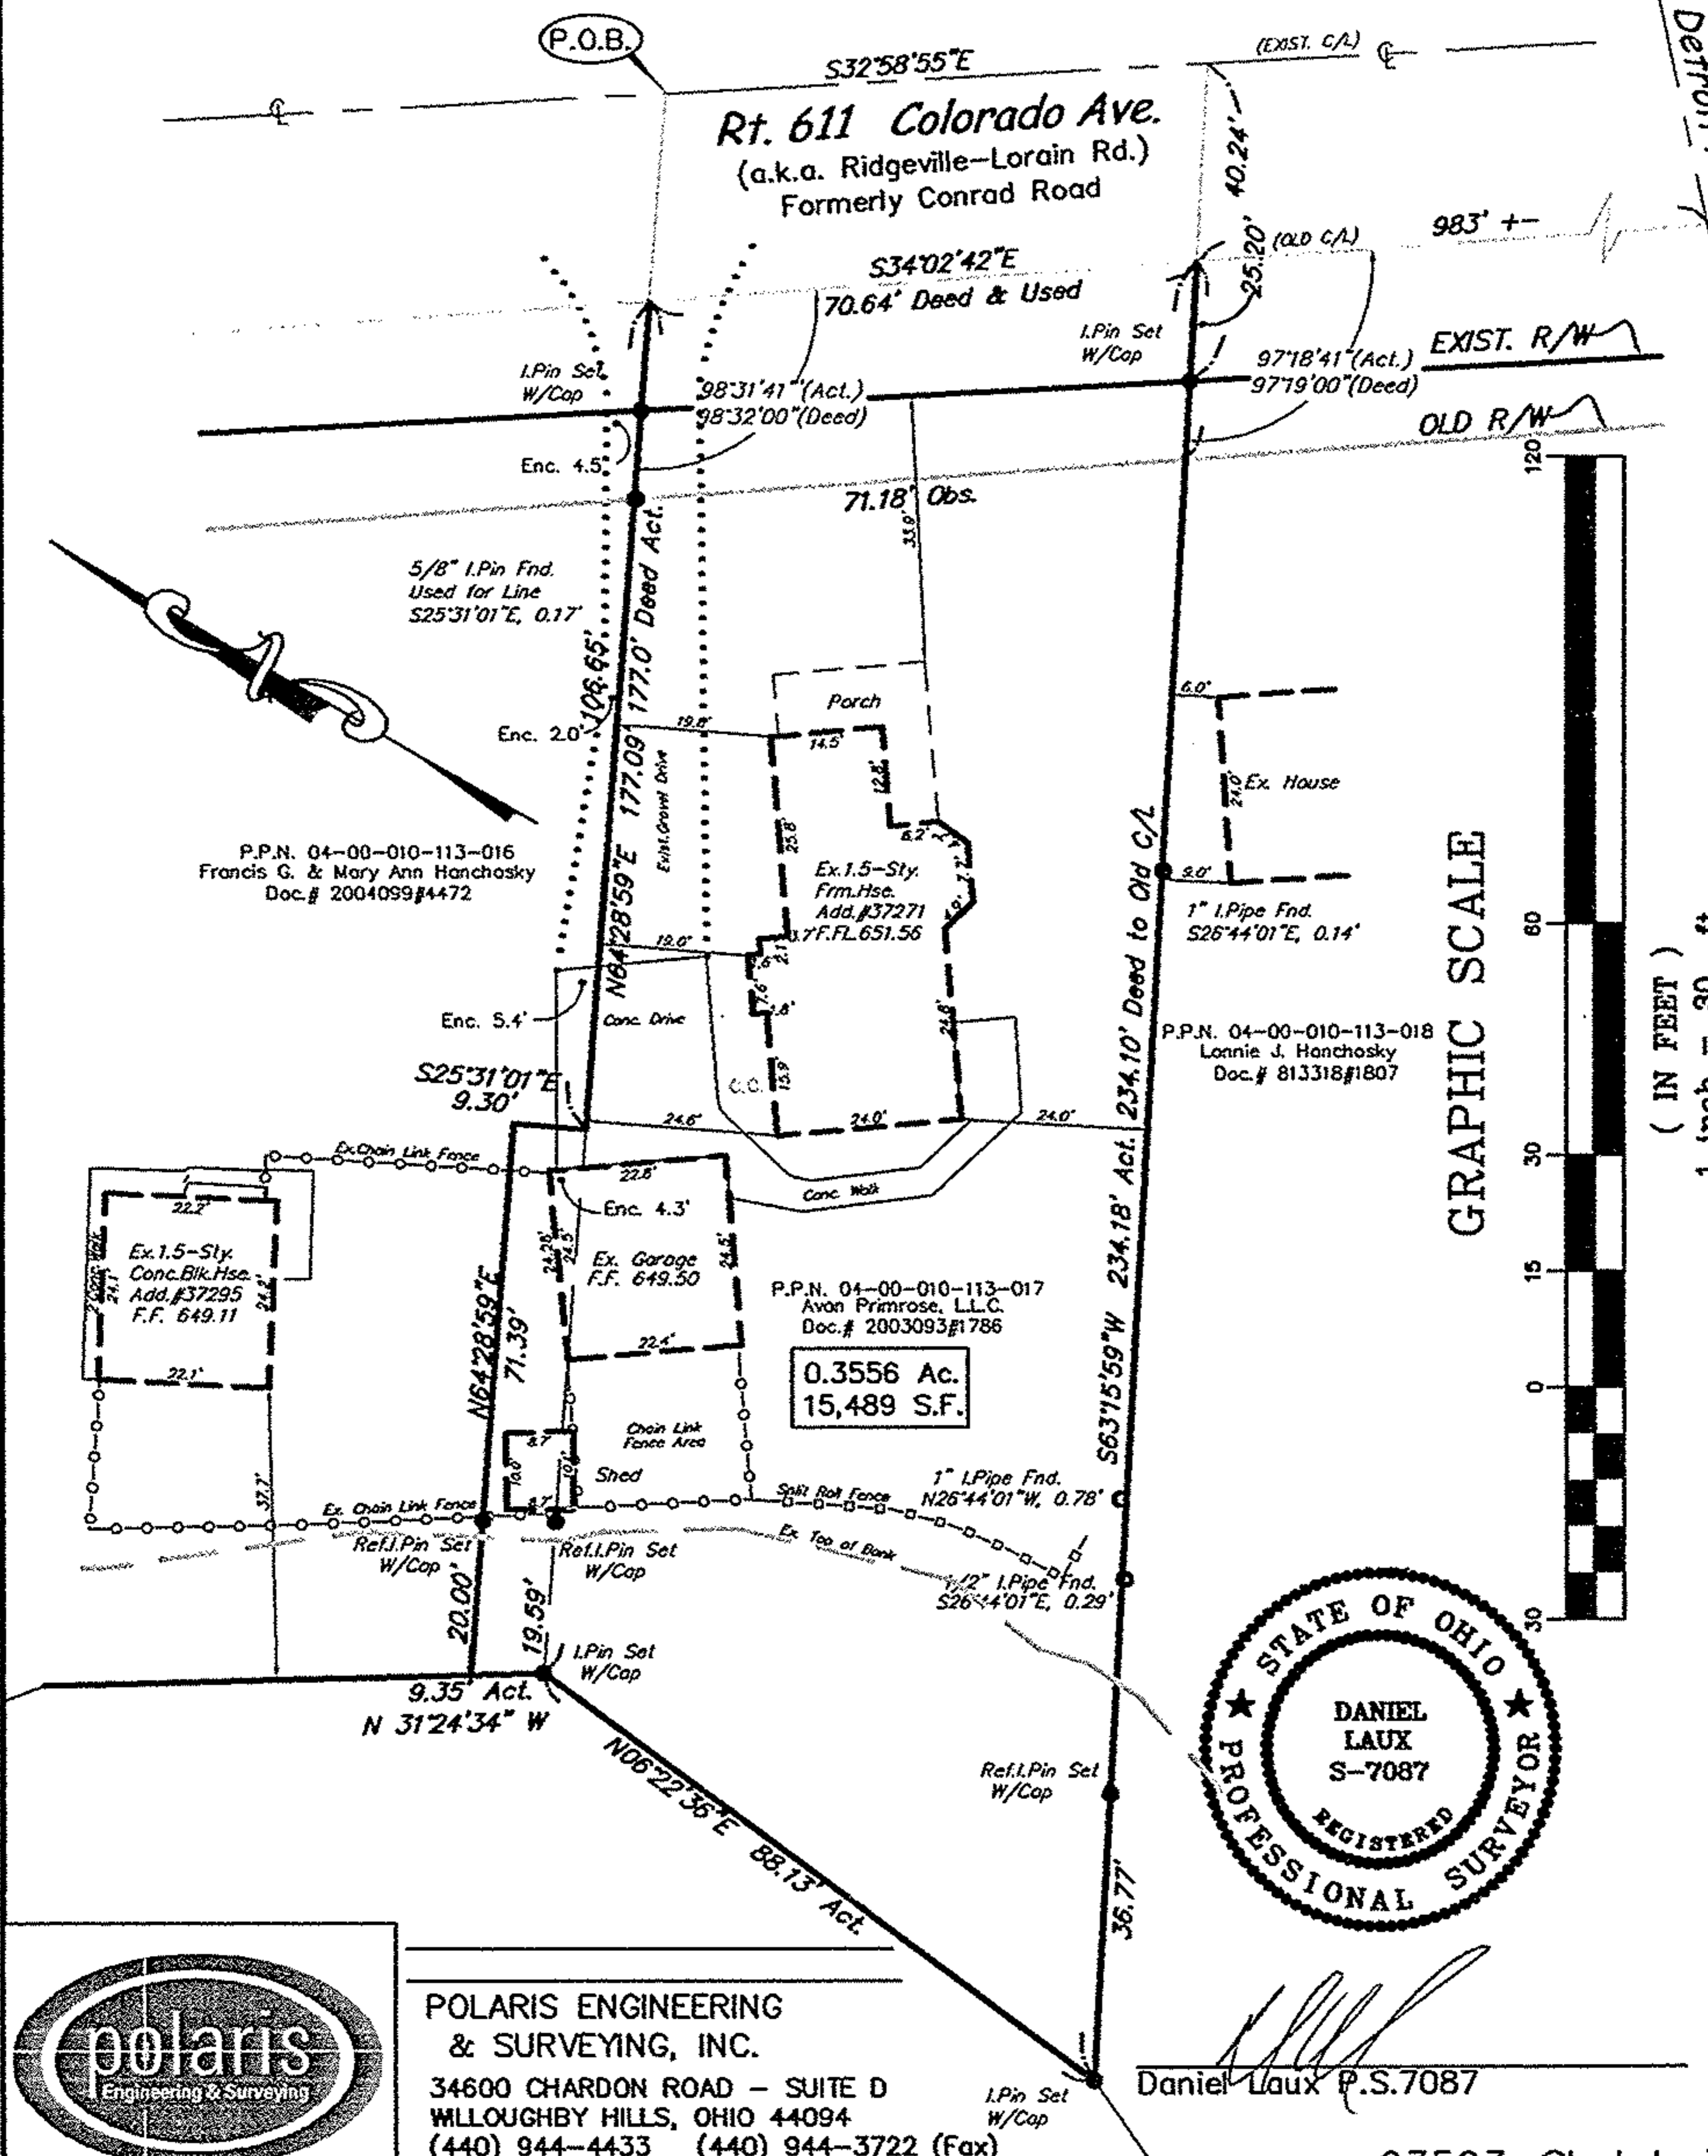

P.P.N. 04-00-010-113-016  
Francis G. & Mary Ann Hanchosky  
Doc. # 2004099#4472

P.P.N. 04-00-010-113-018  
Lonnie J. Hanchosky  
Doc. # 813318#1807

P.P.N. 04-00-010-113-017  
Avon Primrose, L.L.C.  
Doc. # 2003093#1786

0.3556 Ac.  
15,489 S.F.




*[Signature]*  
Daniel Laux P.S.7087

GRAPHIC SCALE



( IN FEET )  
1 inch = 30 ft.

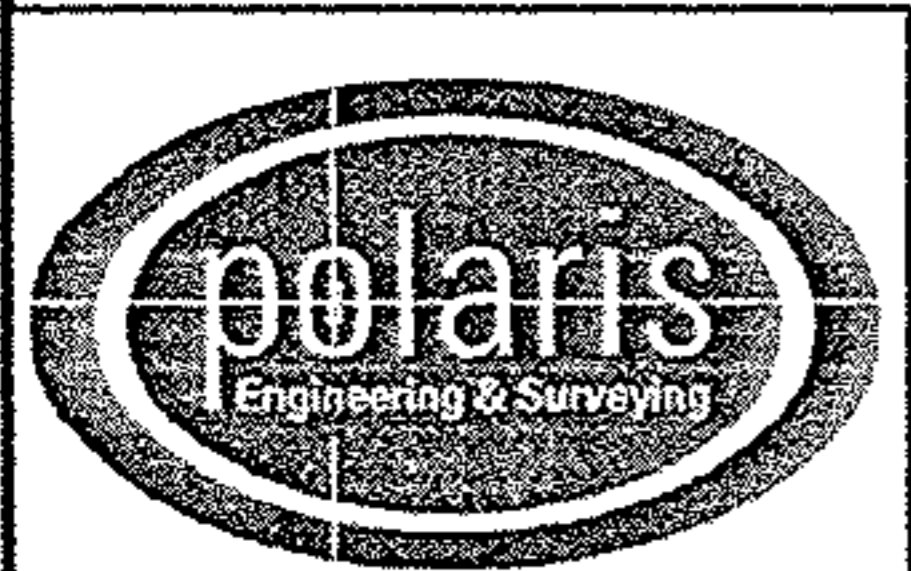

**POLARIS ENGINEERING & SURVEYING, INC.**  
34600 CHARDON ROAD - SUITE D  
WILLOUGHBY HILLS, OHIO 44094  
(440) 944-4433 (440) 944-3722 (Fax)  
www.polaris-es.com

03503-Sketch 3