
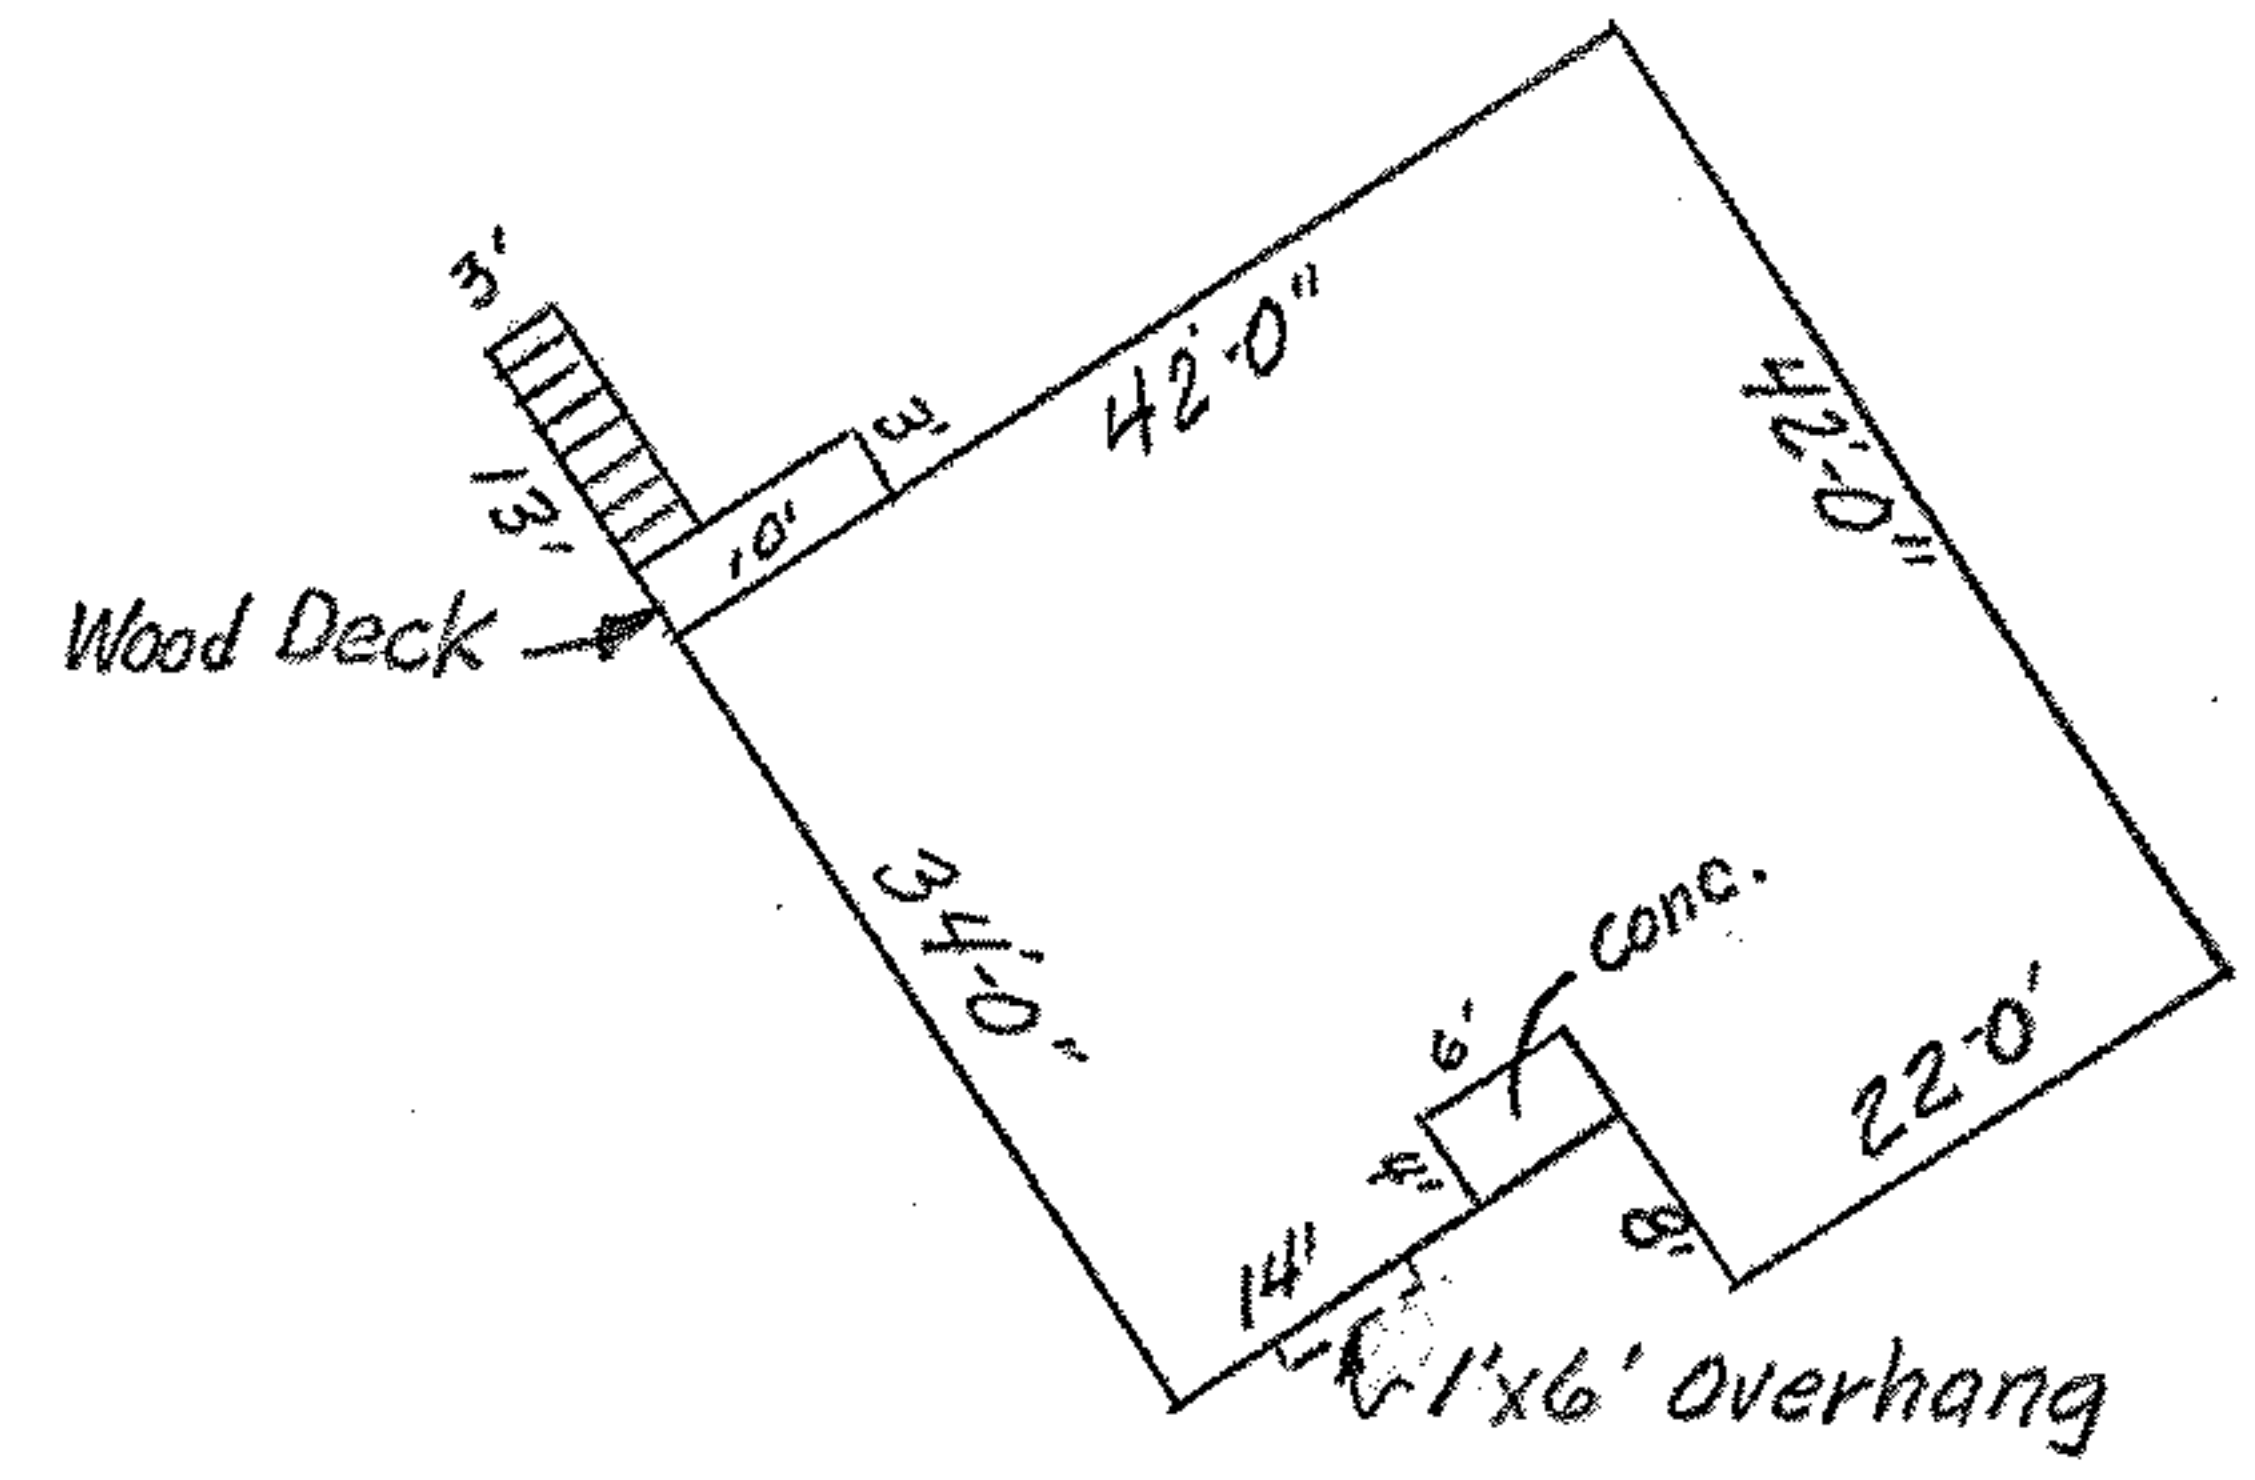


STATE ROUTE 2

 

PART of ORIGINAL AMHERST TOWNSHIP
LOT NO. 99
NOW IN CITY OF AMHERST, OHIO
LORAIN COUNTY, OHIO

This is not a plat of survey
For Mortgage Loan Purposes only

McGLINCHY & ASSOCIATES
July 22, 1990 # 908799

Midland Title No. 10-28171