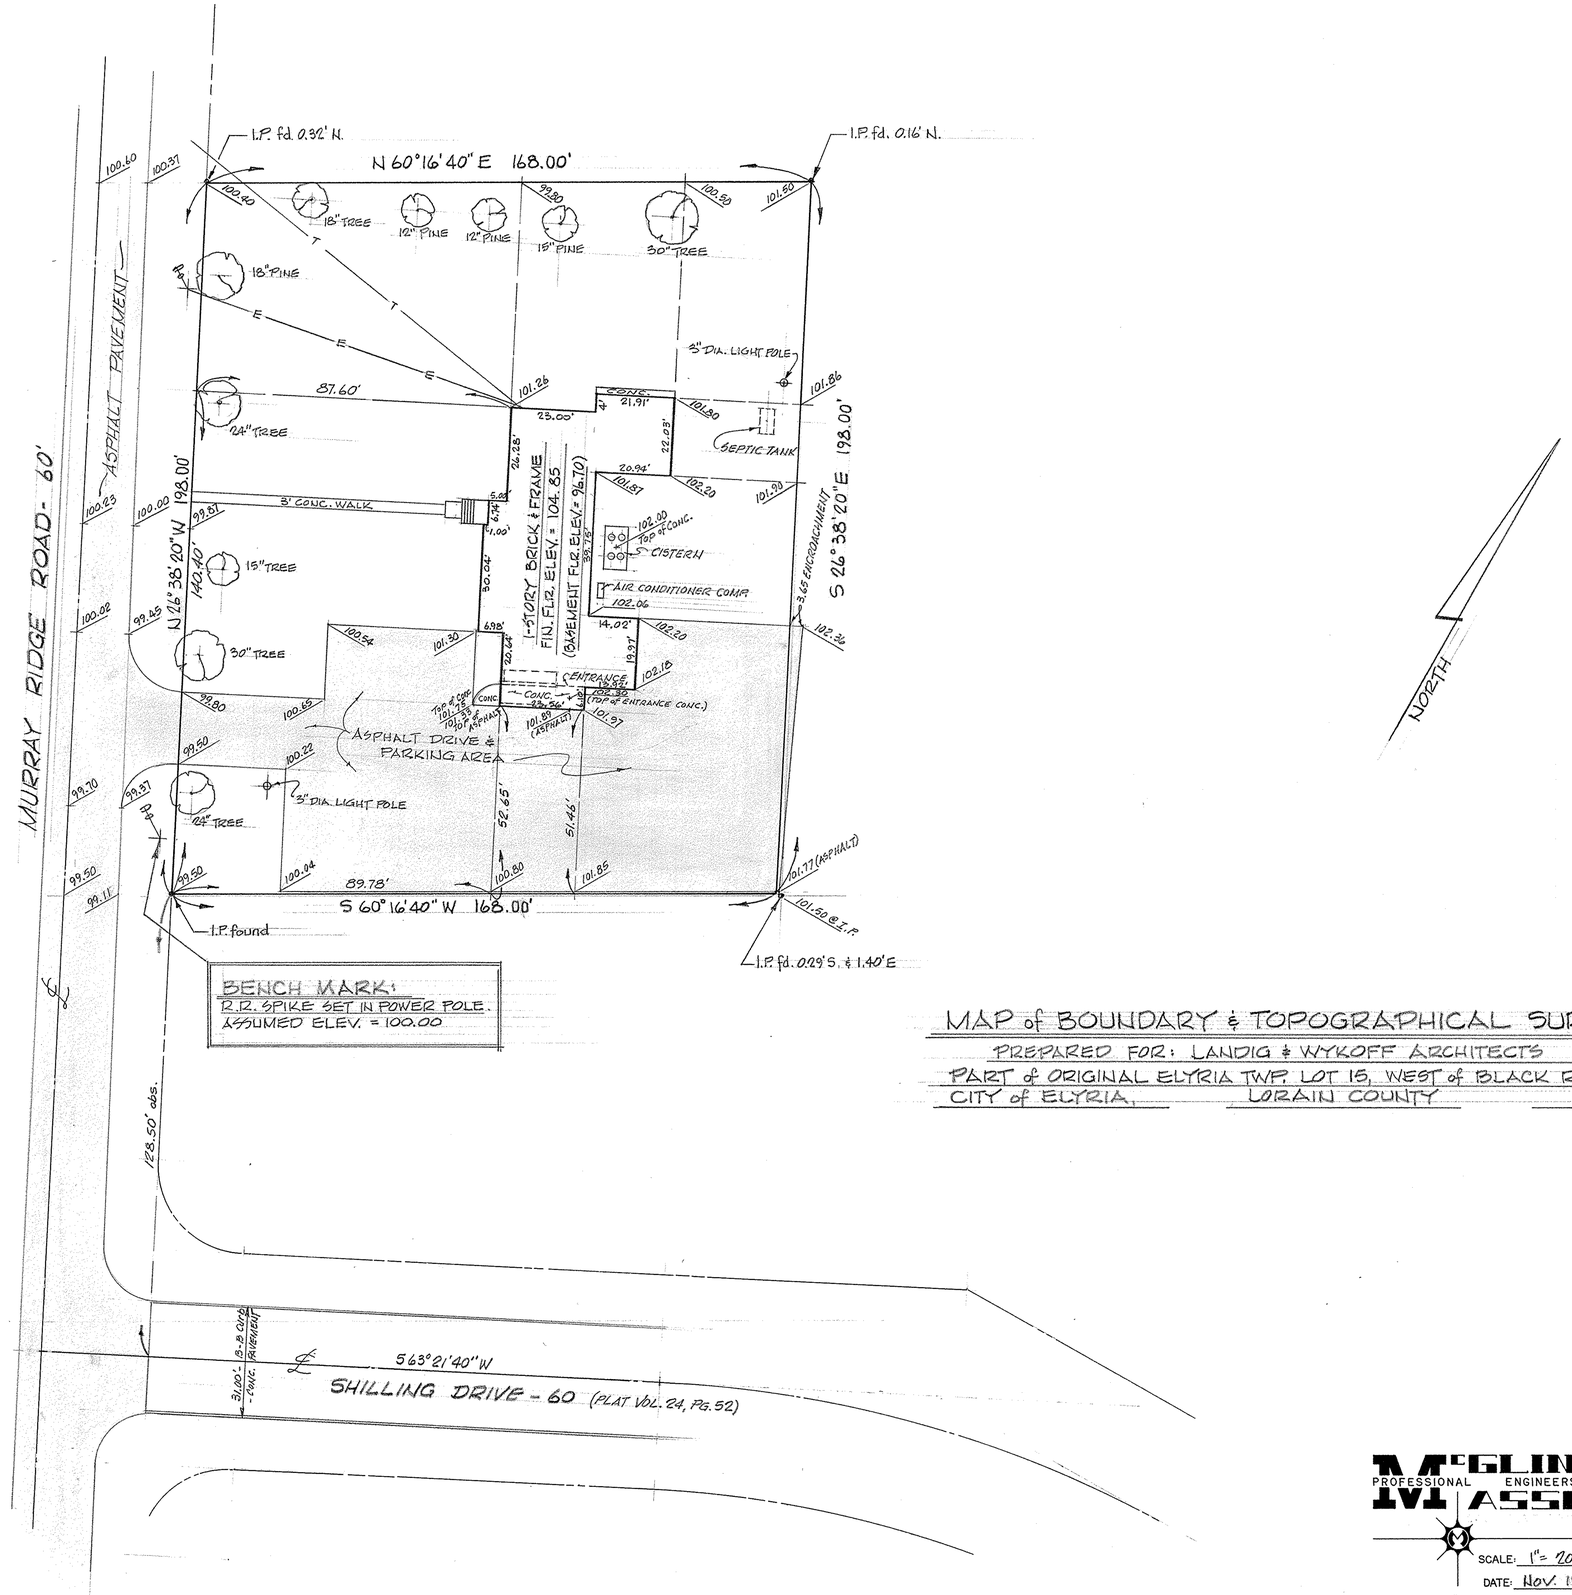

MAP of BOUNDARY & TOPOGRAPHICAL SURVEY

PREPARED FOR: LANDIG & WYKOFF ARCHITECTS

PART of ORIGINAL ELYRIA TWP. LOT 15, WEST of BLACK RIVER

CITY of ELYRIA, LORAIN COUNTY OHIO

NO GAS SERVICE PER COLUMBIA GAS CO.

McGLINCHY AND ASSOCIATES
PROFESSIONAL ENGINEERS AND SURVEYORS
ELYRIA, OHIO

SCALE: 1" = 20' DRAWN BY: B. THOMAS

DATE: NOV. 1981 JOB NO: 817058