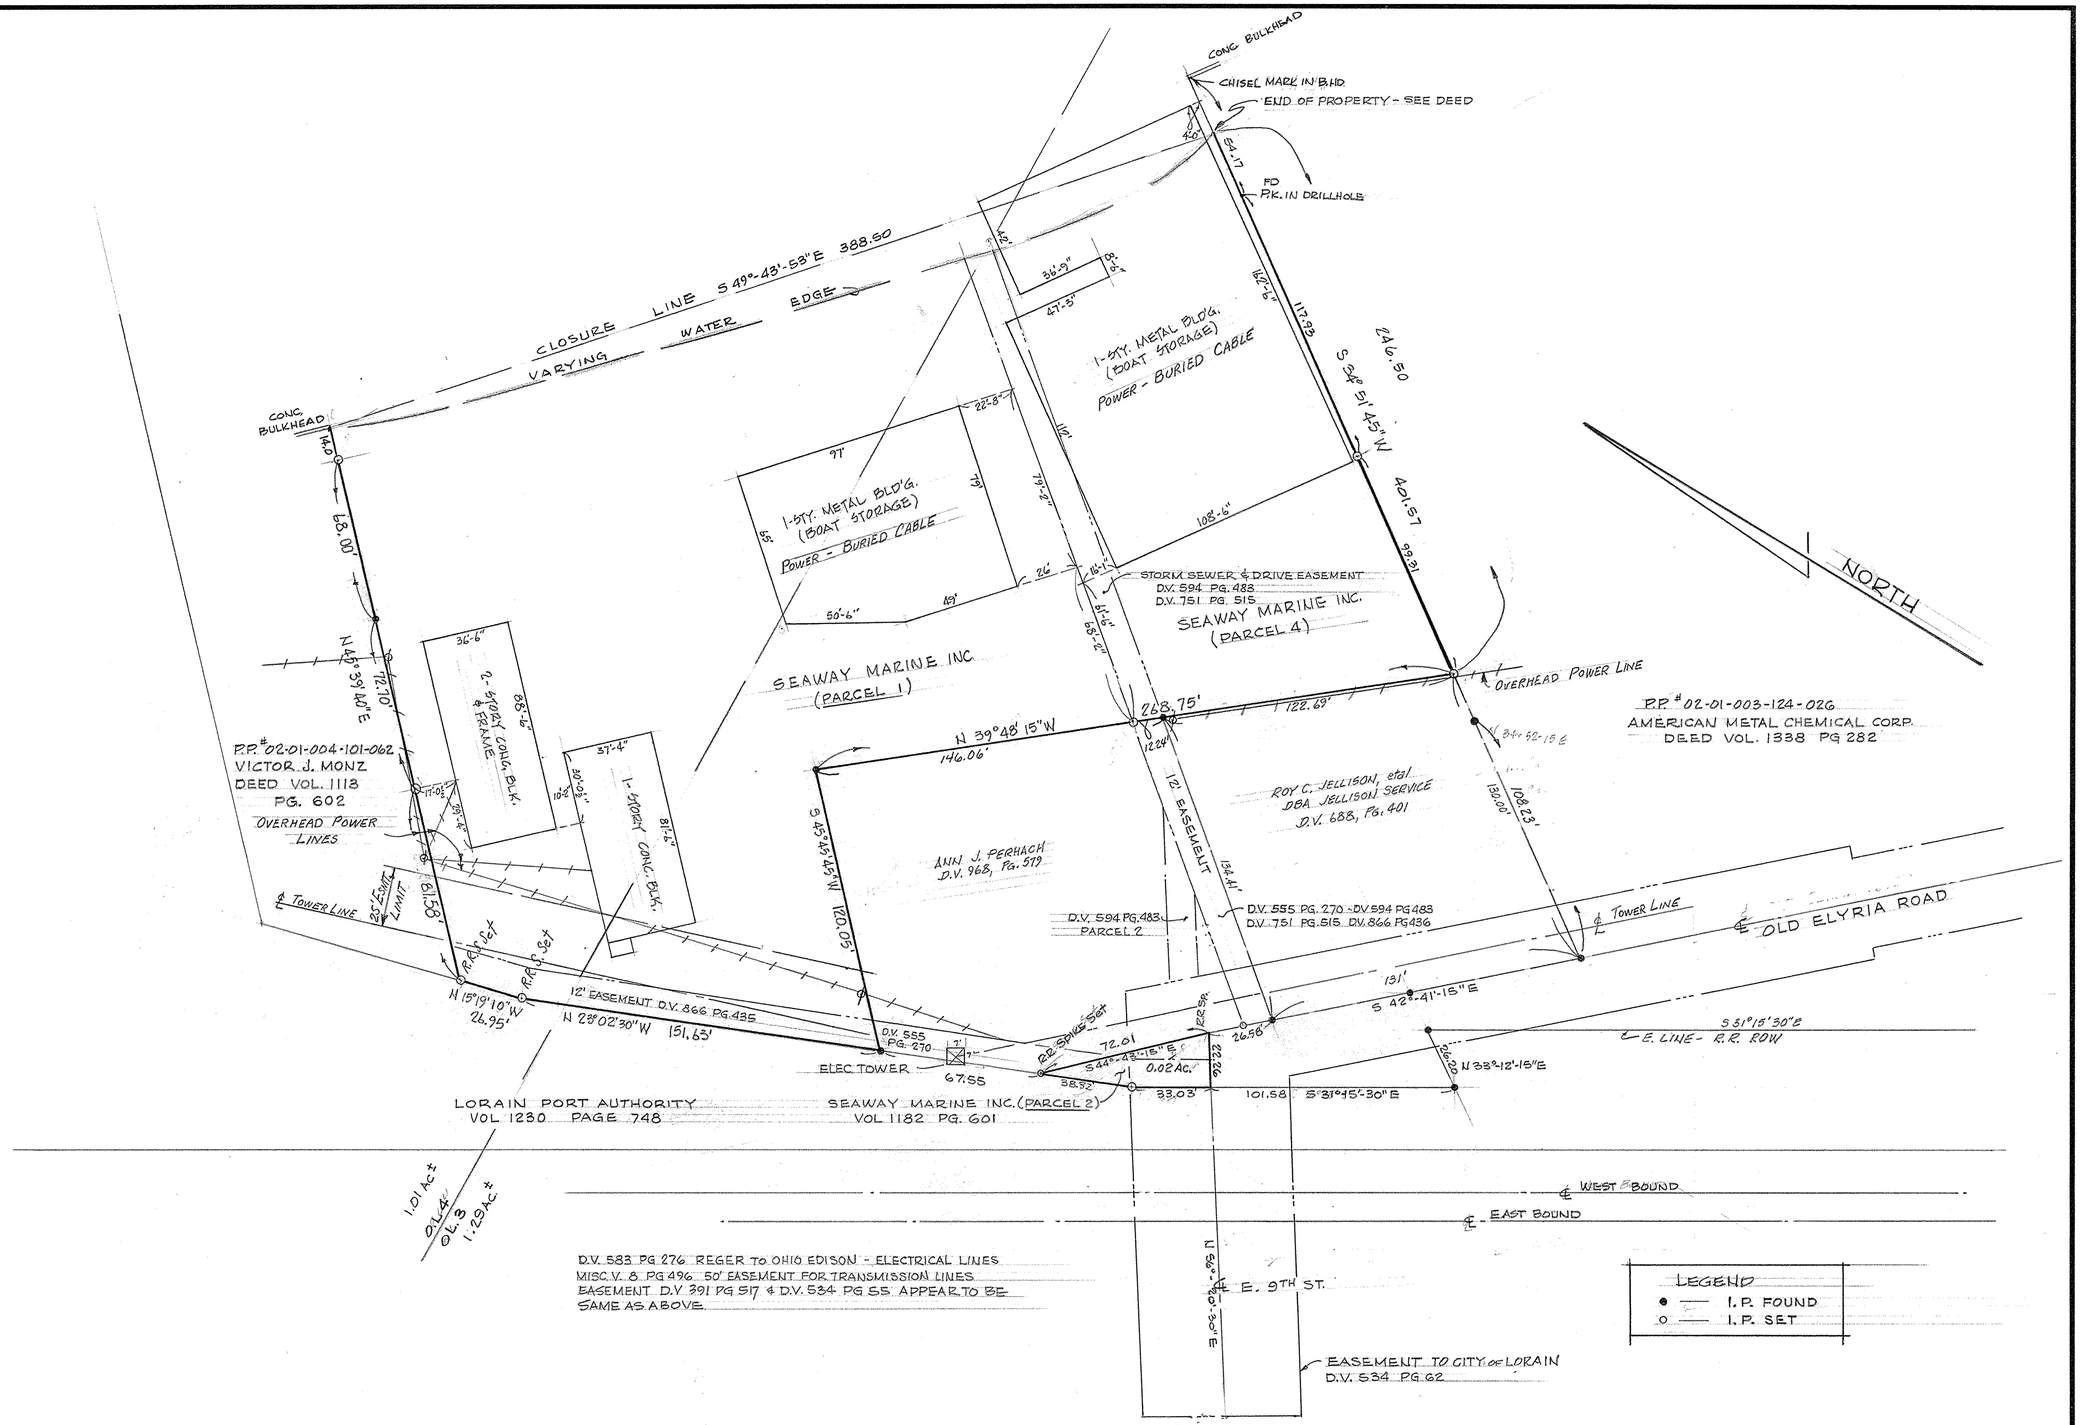

D.V. 583 PG 276 REGER TO OHIO EDISON - ELECTRICAL LINES
MISC V. 8 PG 496 50' EASEMENT FOR TRANSMISSION LINES
EASEMENT D.V 391 PG 517 & D.V. 534 PG 55 APPEAR TO BE SAME AS ABOVE.

MAP of BOUNDARY SURVEY & BUILDING LOCATIONS

PREPARED FOR: AMERICAN METAL CHEMICAL CORPORATION

PART OF ORIGINAL BLACK RIVER TOWNSHIP LOTS 3 & 4 - TRACT 1
NOW IN CITY OF LORAIN, OHIO

P.P. # 02-01-003-124-017
02-01-004-101-063, -064 & -065

McGLINCHY AND ASSOCIATES
PROFESSIONAL ENGINEERS AND SURVEYORS
110½ MIDDLE AVENUE ELYRIA, OHIO

SCALE: 1" = 30' DRAWN BY: B. THOMAS
DATE: MAY 1984 JOB NO: 848335
ADD'N: 6/21/84