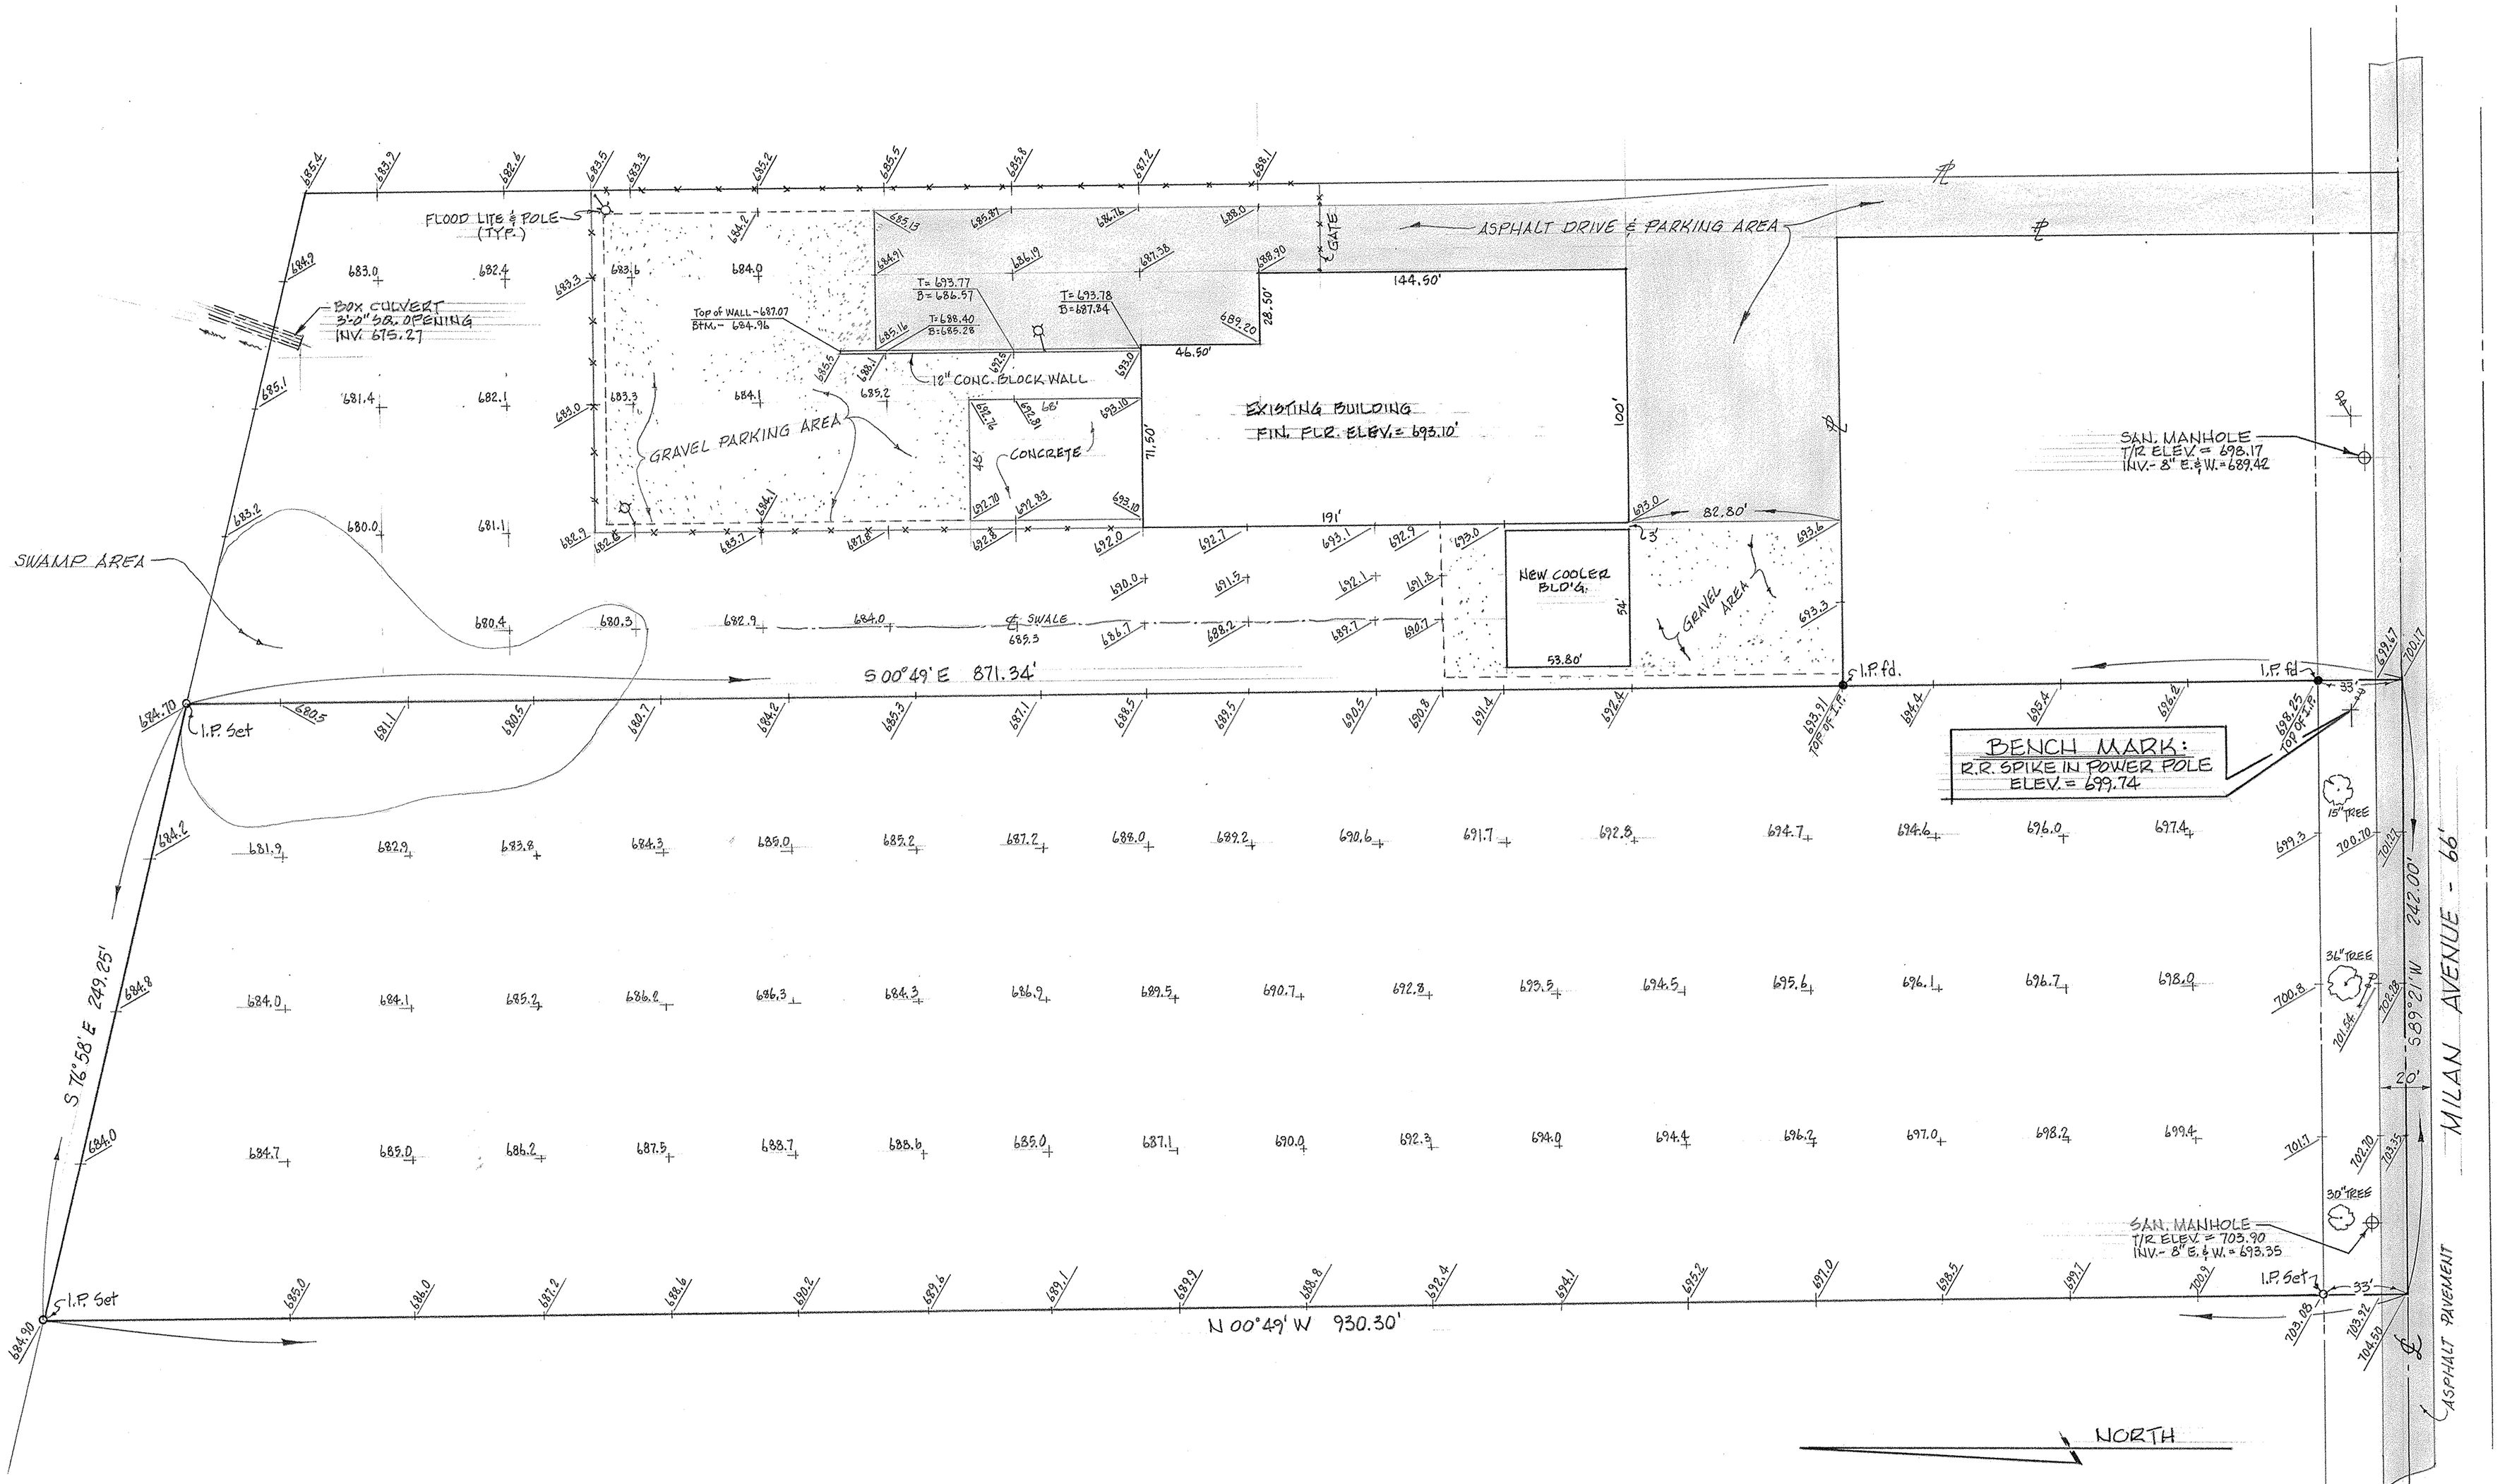

MAP of BOUNDARY and TOPOGRAPHICAL SURVEY

PREPARED FOR KERR BEVERAGE CO.

PART of ORIGINAL AMHERST TOWNSHIP LOT No. 3

CITY of AMHERST LORAIN COUNTY OHIO

McGLINCHY AND ASSOCIATES
PROFESSIONAL ENGINEERS AND SURVEYORS
ELYRIA, OHIO

SCALE: 1" = 30' DRAWN BY: B. THOMAS

DATE: AUG 1984 JOB NO: 848311