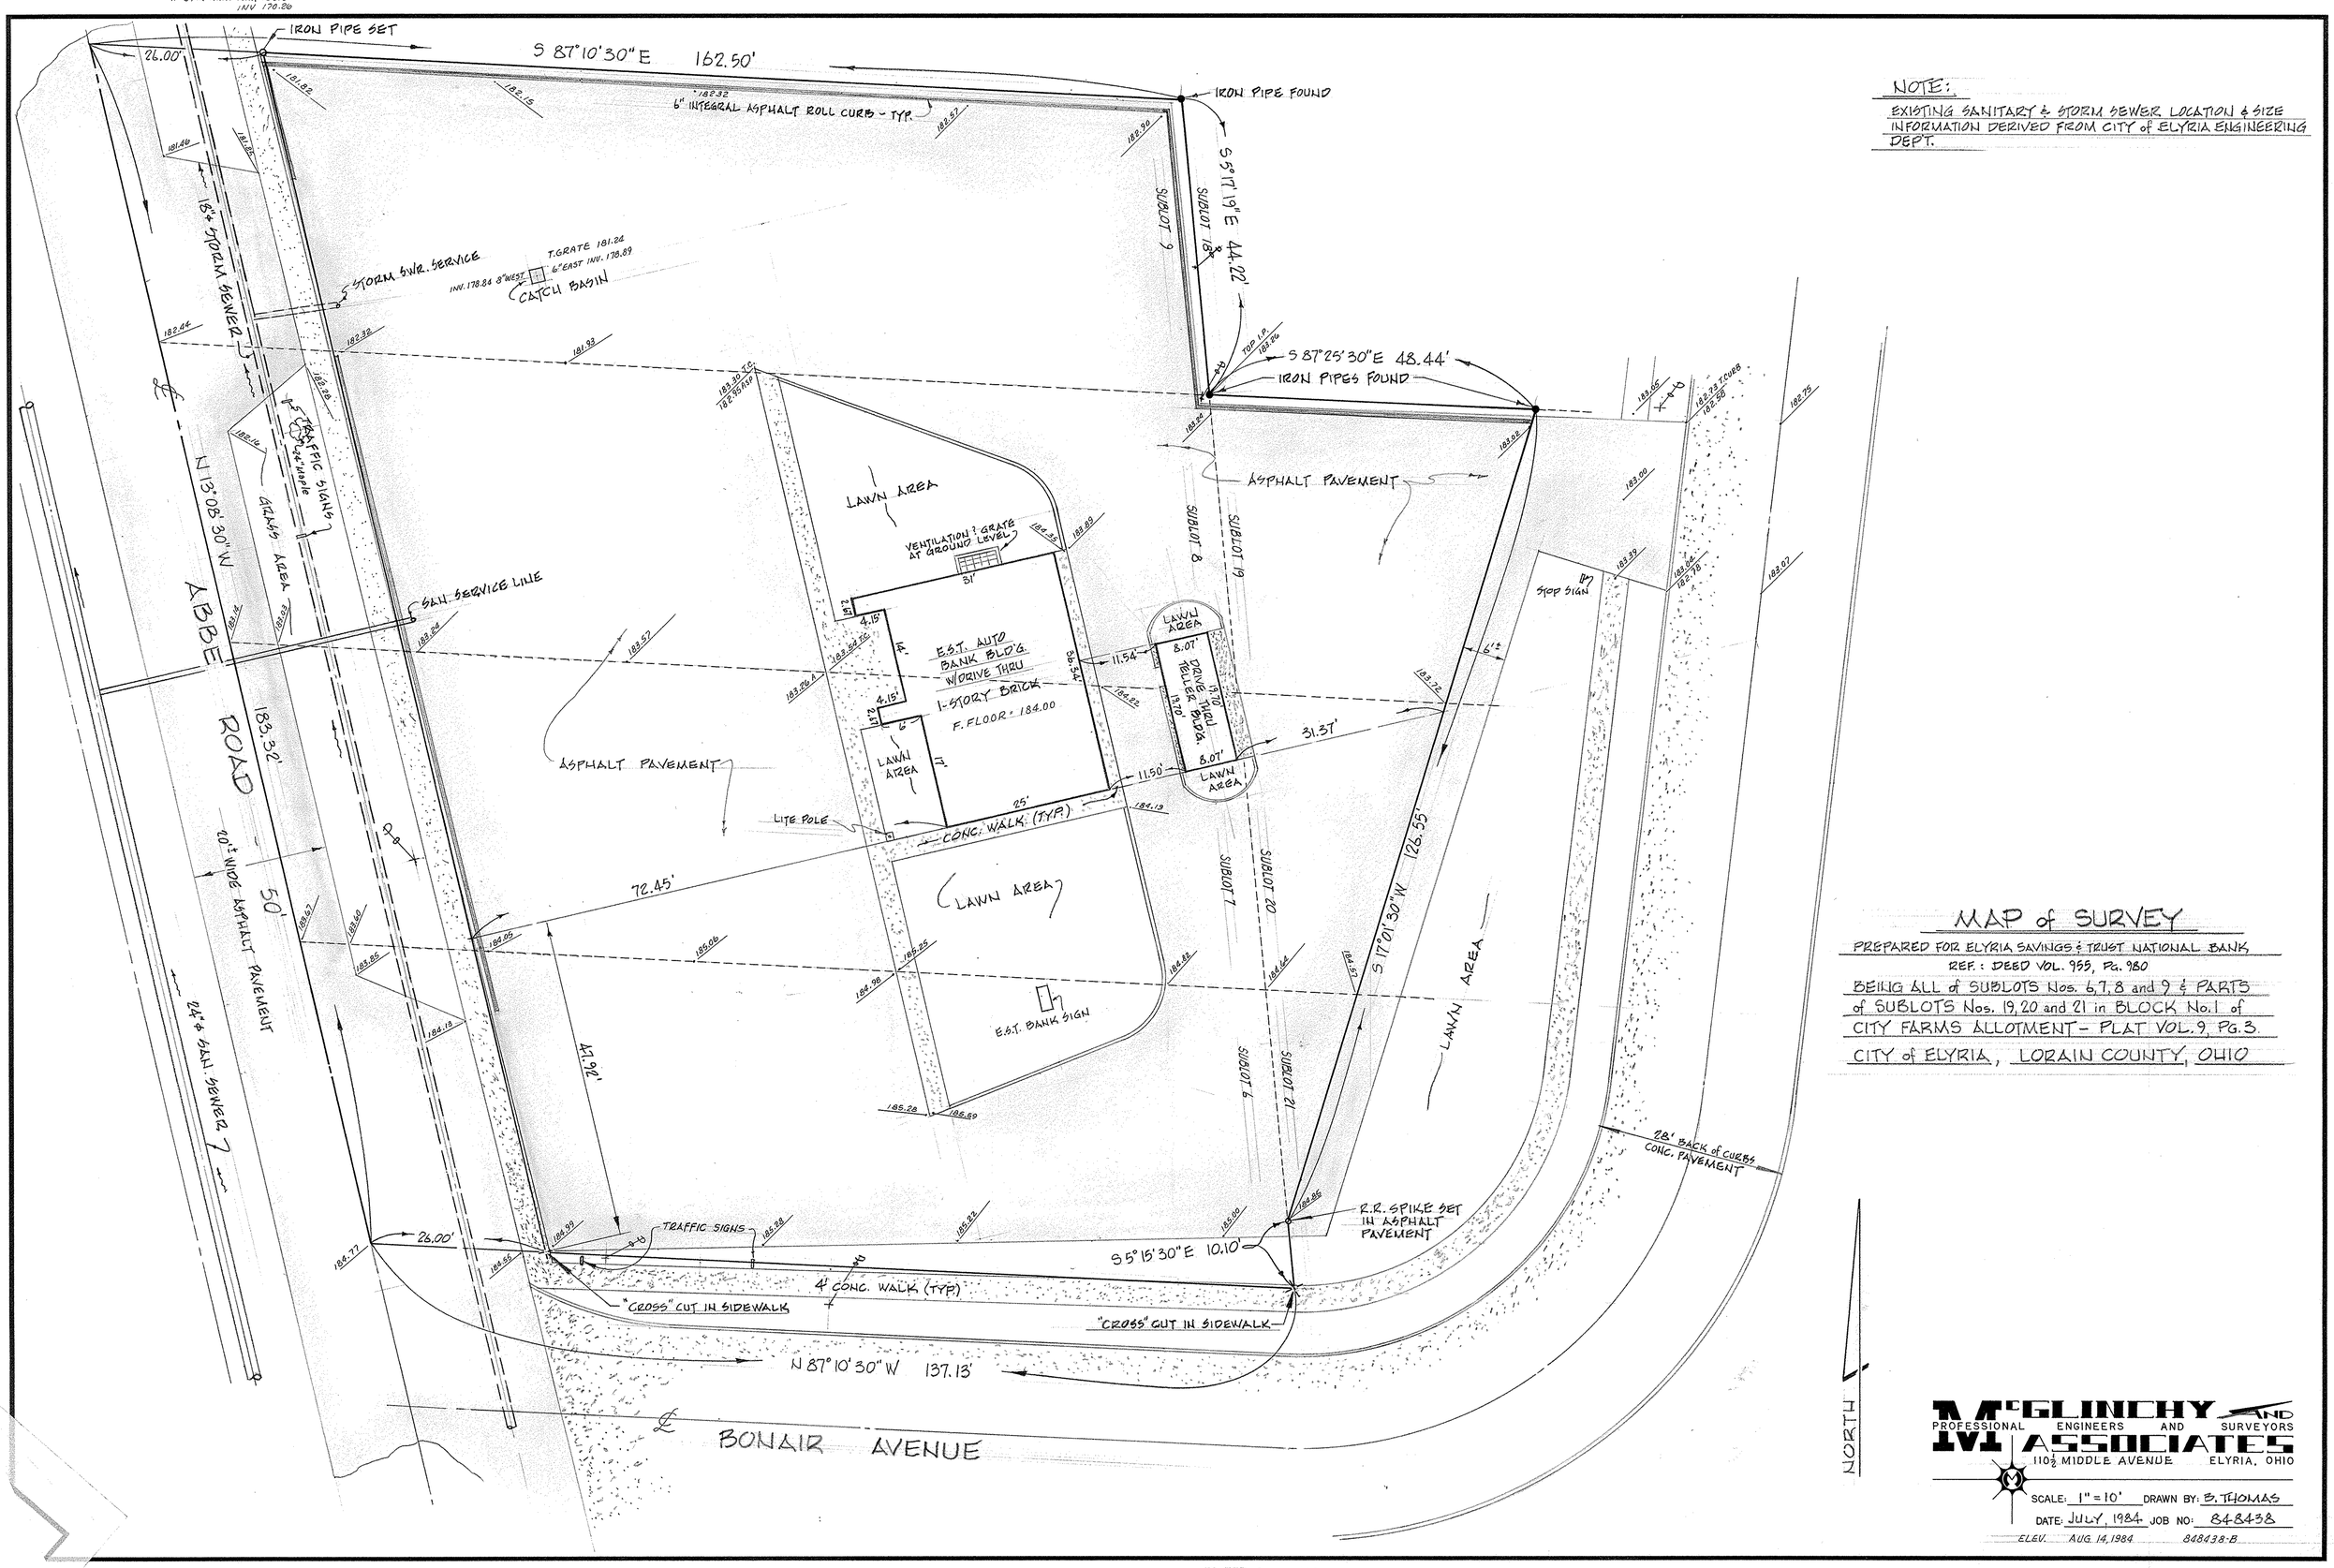

NOTE:

EXISTING SANITARY & STORM SEWER LOCATION & SIZE INFORMATION DERIVED FROM CITY of ELYRIA ENGINEERING DEPT.

MAP of SURVEY

PREPARED FOR ELYRIA SAVINGS & TRUST NATIONAL BANK

REF.: DEED VOL. 955, Pg. 980

BEING ALL of SUBLOTS Nos. 6, 7, 8 and 9 & PARTS of SUBLOTS Nos. 19, 20 and 21 in BLOCK No. 1 of CITY FARMS ALLOTMENT - PLAT VOL. 9, Pg. 3

CITY of ELYRIA, LORAIN COUNTY, OHIO

McGLINCHY AND ASSOCIATES
PROFESSIONAL ENGINEERS AND SURVEYORS
110½ MIDDLE AVENUE ELYRIA, OHIO

SCALE: 1" = 10' DRAWN BY: B. THOMAS

DATE: JULY, 1984 JOB NO: 848438

ELEV. AUG. 14, 1984 848438-B