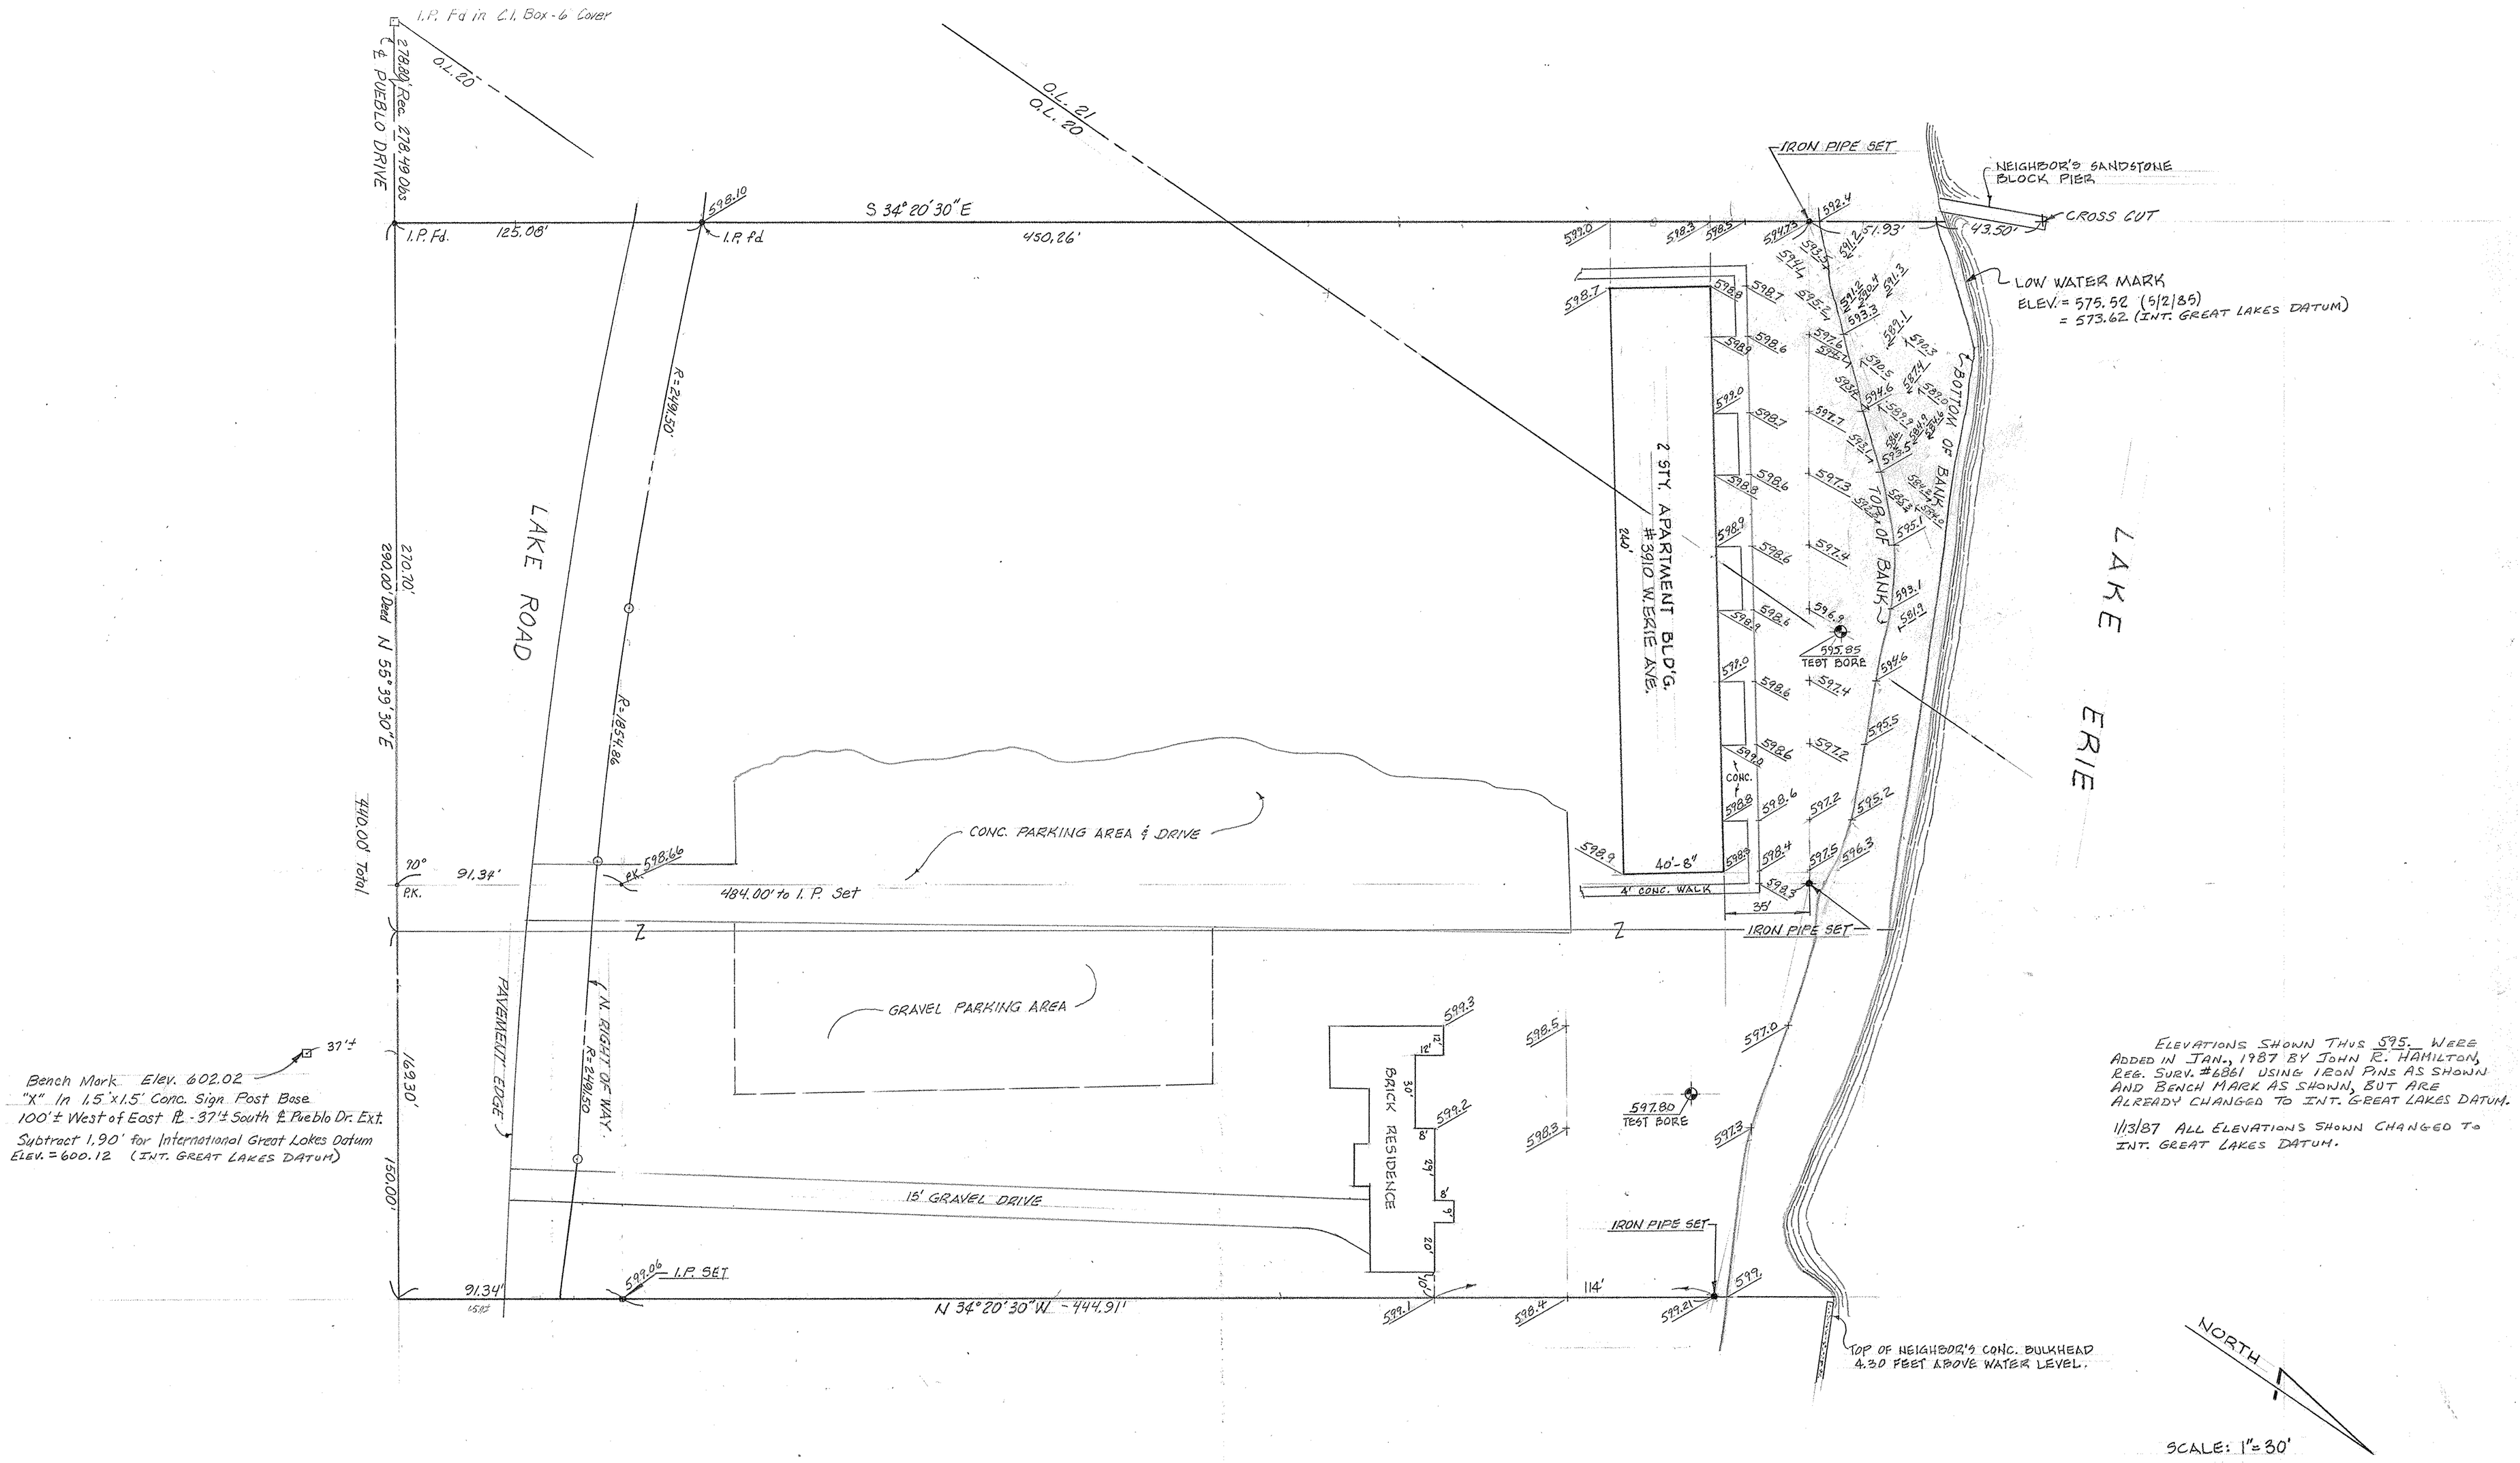

ELEVATIONS SHOWN THUS 595. WERE ADDED IN JAN., 1987 BY JOHN R. HAMILTON, REG. SURV. #6861 USING IRON PINS AS SHOWN AND BENCH MARK AS SHOWN, BUT ARE ALREADY CHANGED TO INT. GREAT LAKES DATUM.

1/13/87 ALL ELEVATIONS SHOWN CHANGED TO INT. GREAT LAKES DATUM.

PARTIAL BOUNDARY and TOPOGRAPHIC SURVEY

PREPARED FOR: LAKE SHORE COLONIAL APARTMENTS

PART OF ORIGINAL BLACK RIVER TWP LOT Nos. 20 & 21, TRACT 2

CITY of LORAIN — LORAIN COUNTY — OHIO

Easterly Parcel Volume 908, Page 934 (150' Frontage)
Westerly Parcel Volume 843, Page 364 (290' Frontage)

McGLINCHY and ASSOCIATES INC.
PROFESSIONAL ENGINEER and SURVEYORS
110½ MIDDLE AVE. ELYRIA, OHIO
MAY, 1985 #848480