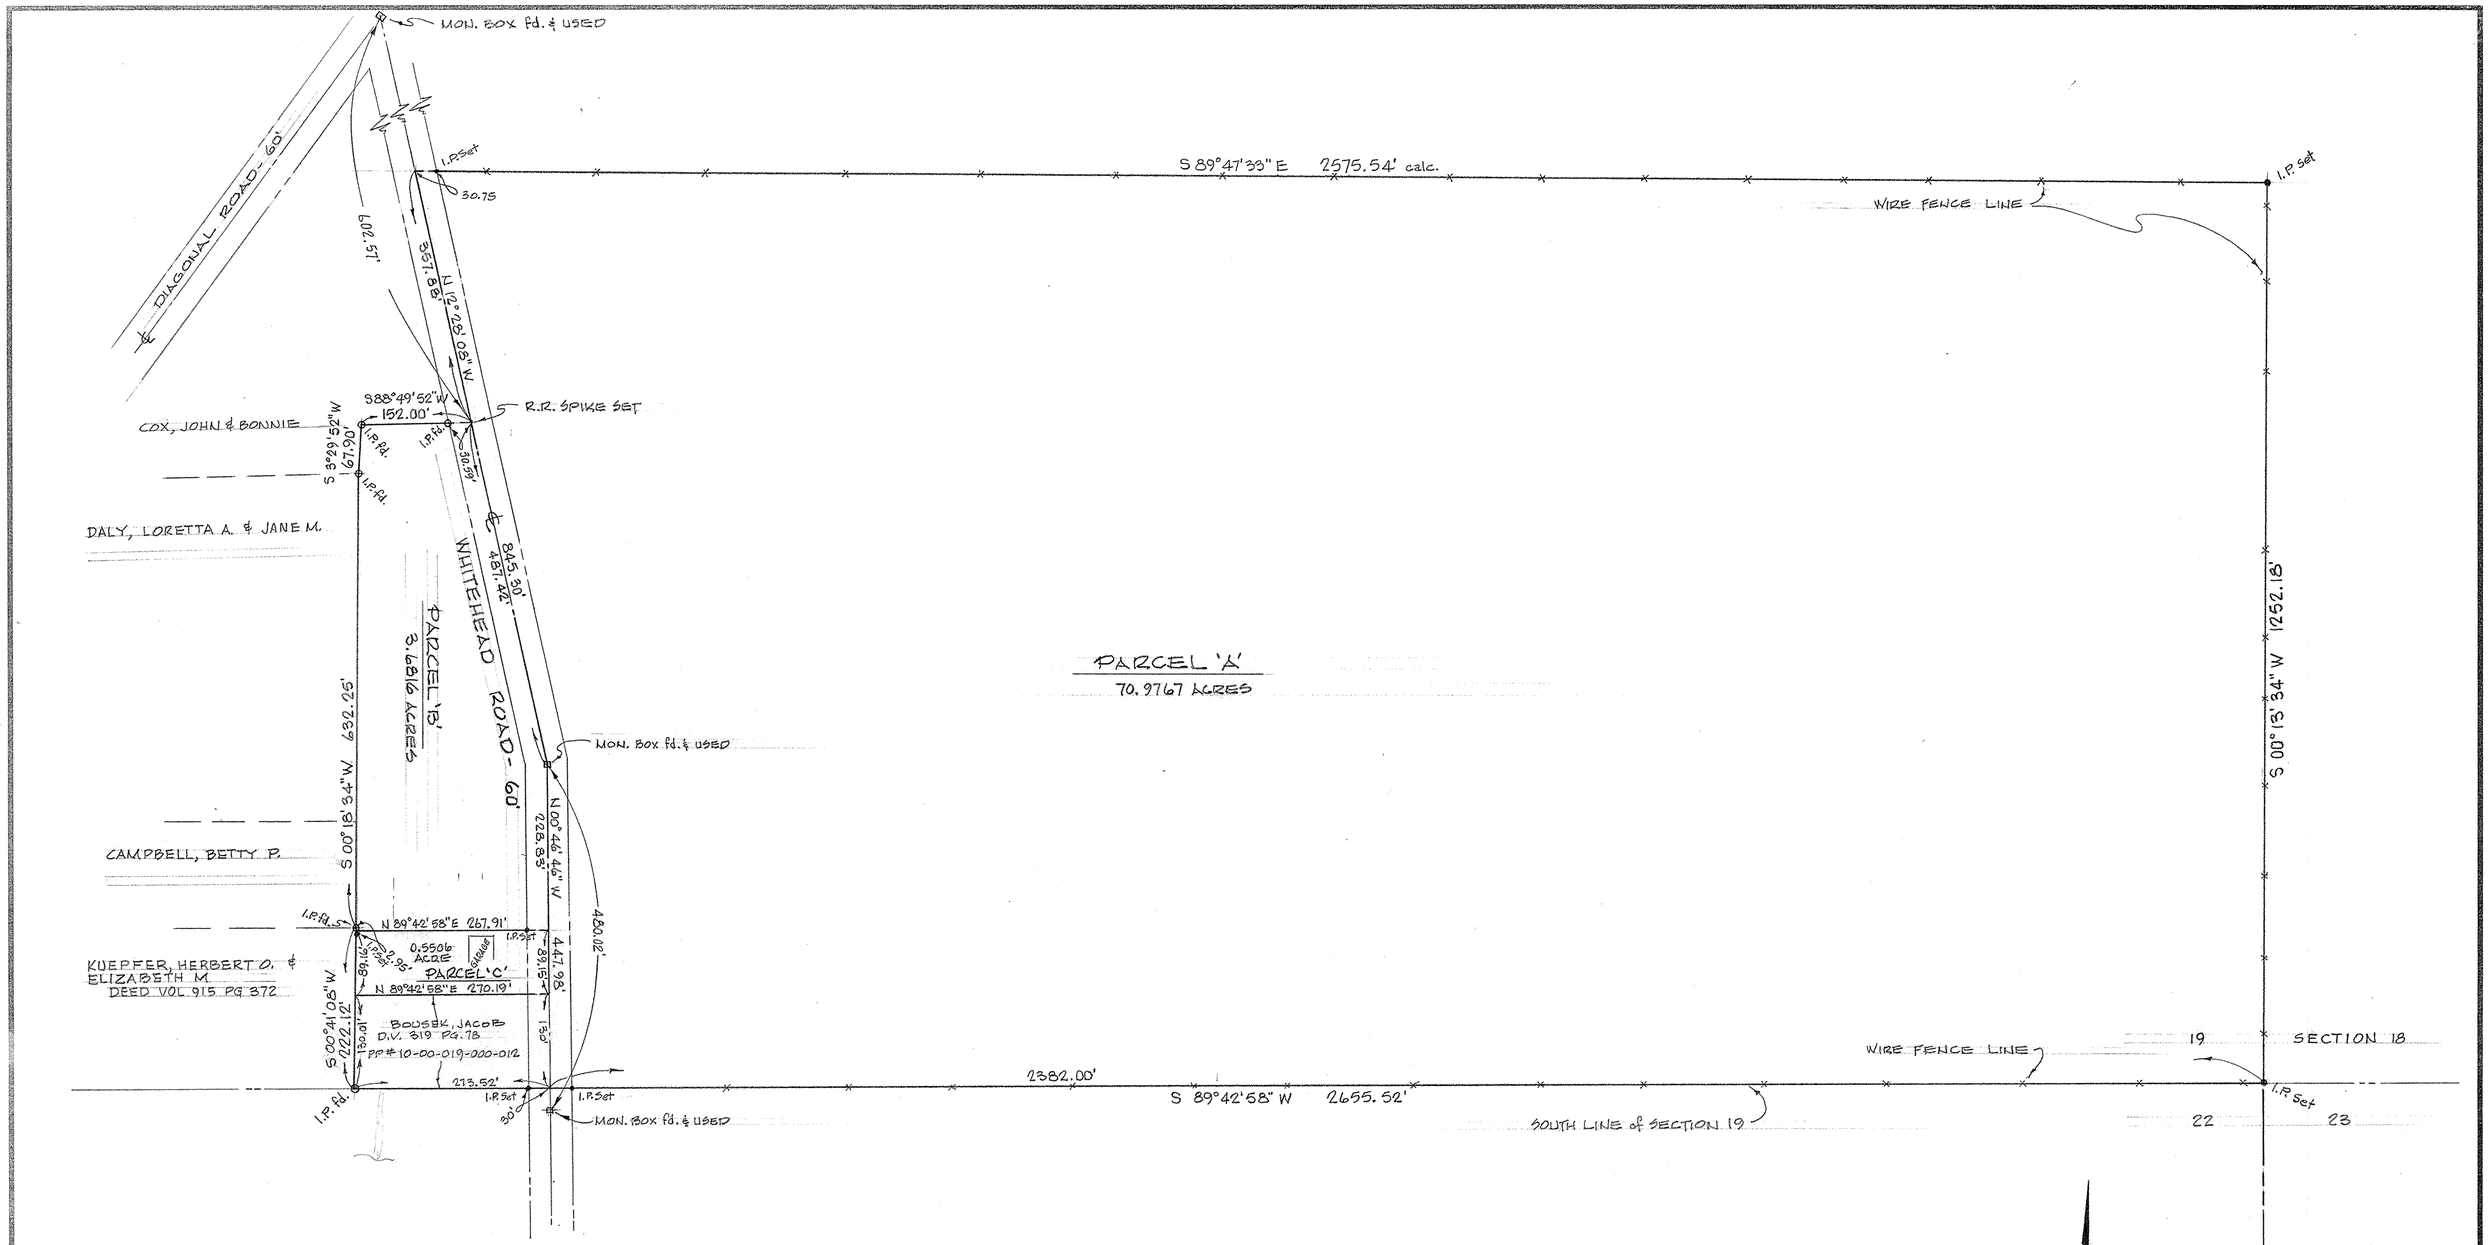

MAP of SURVEY and PROPOSED PARCEL SPLIT

PREPARED FOR JACOB BOUSEK

PART of ORIGINAL CARLISLE TOWNSHIP SECTION No. 19

TOWNSHIP of CARLISLE, LORAIN COUNTY, OHIO

McGLINCHY AND ASSOCIATES
PROFESSIONAL ENGINEERS AND SURVEYORS
110½ MIDDLE AVE. ELYRIA, OHIO

SCALE: 1" = 100' DRAWN BY: B. THOMAS

DATE: APRIL, 1981 JOB NO: 816700

REF: P.P. # 10-00-019-000-017 & 018
TAX MAP PAGE 10-F