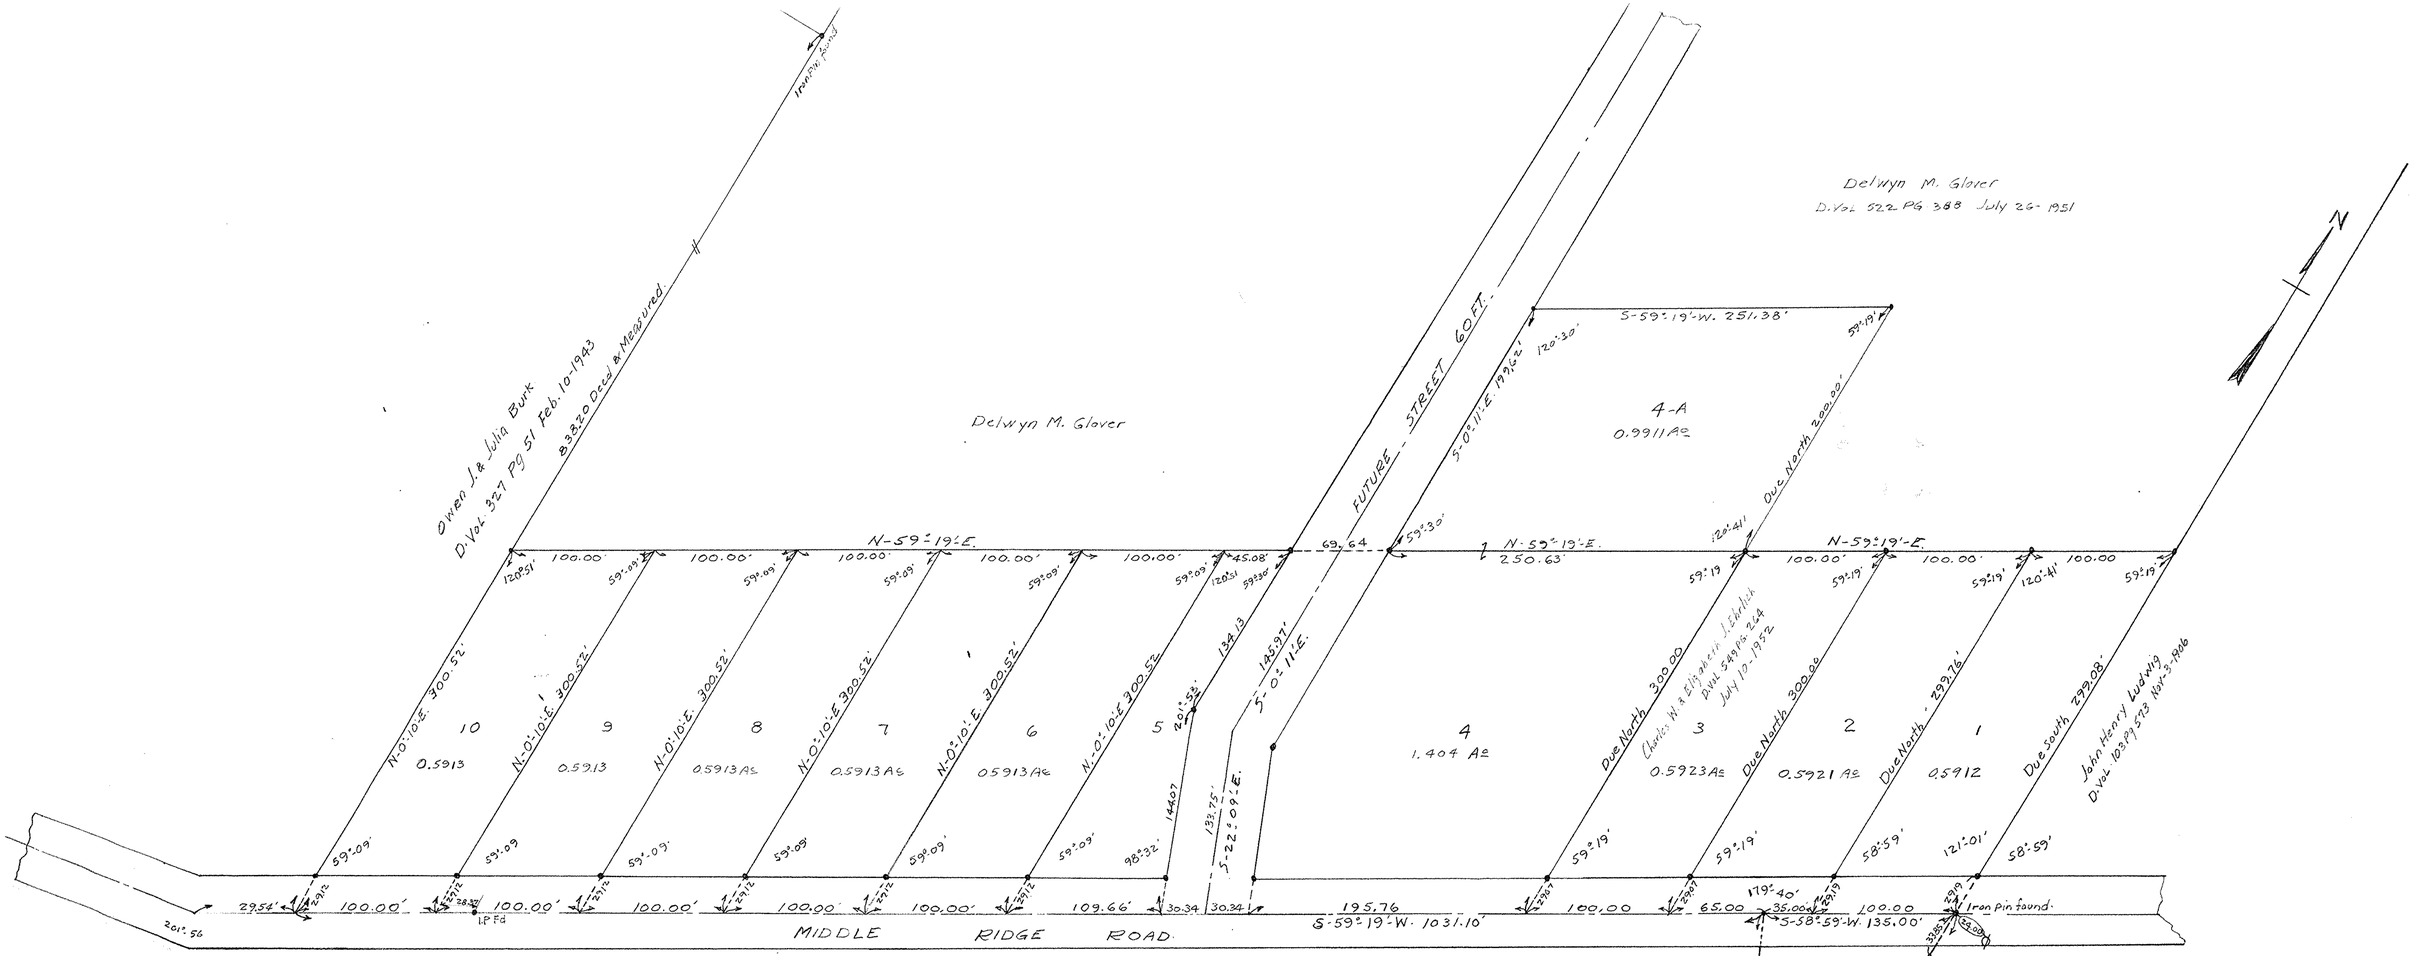

Note :- Iron pins found or Set shown thus. •

MAP OF SURVEY FOR
Delwyn M. Glover
OL. 26 AMHERST TOWNSHIP
LORAIN COUNTY OHIO
Scale 1" 60' March 29-1952 - AUG. 15-1953
C.E. Penfound Registered Surveyor.

05-00-026