NOTES: ● indicates iron pin set unless otherwise designated.
⊙ indicates point of observed elevation.

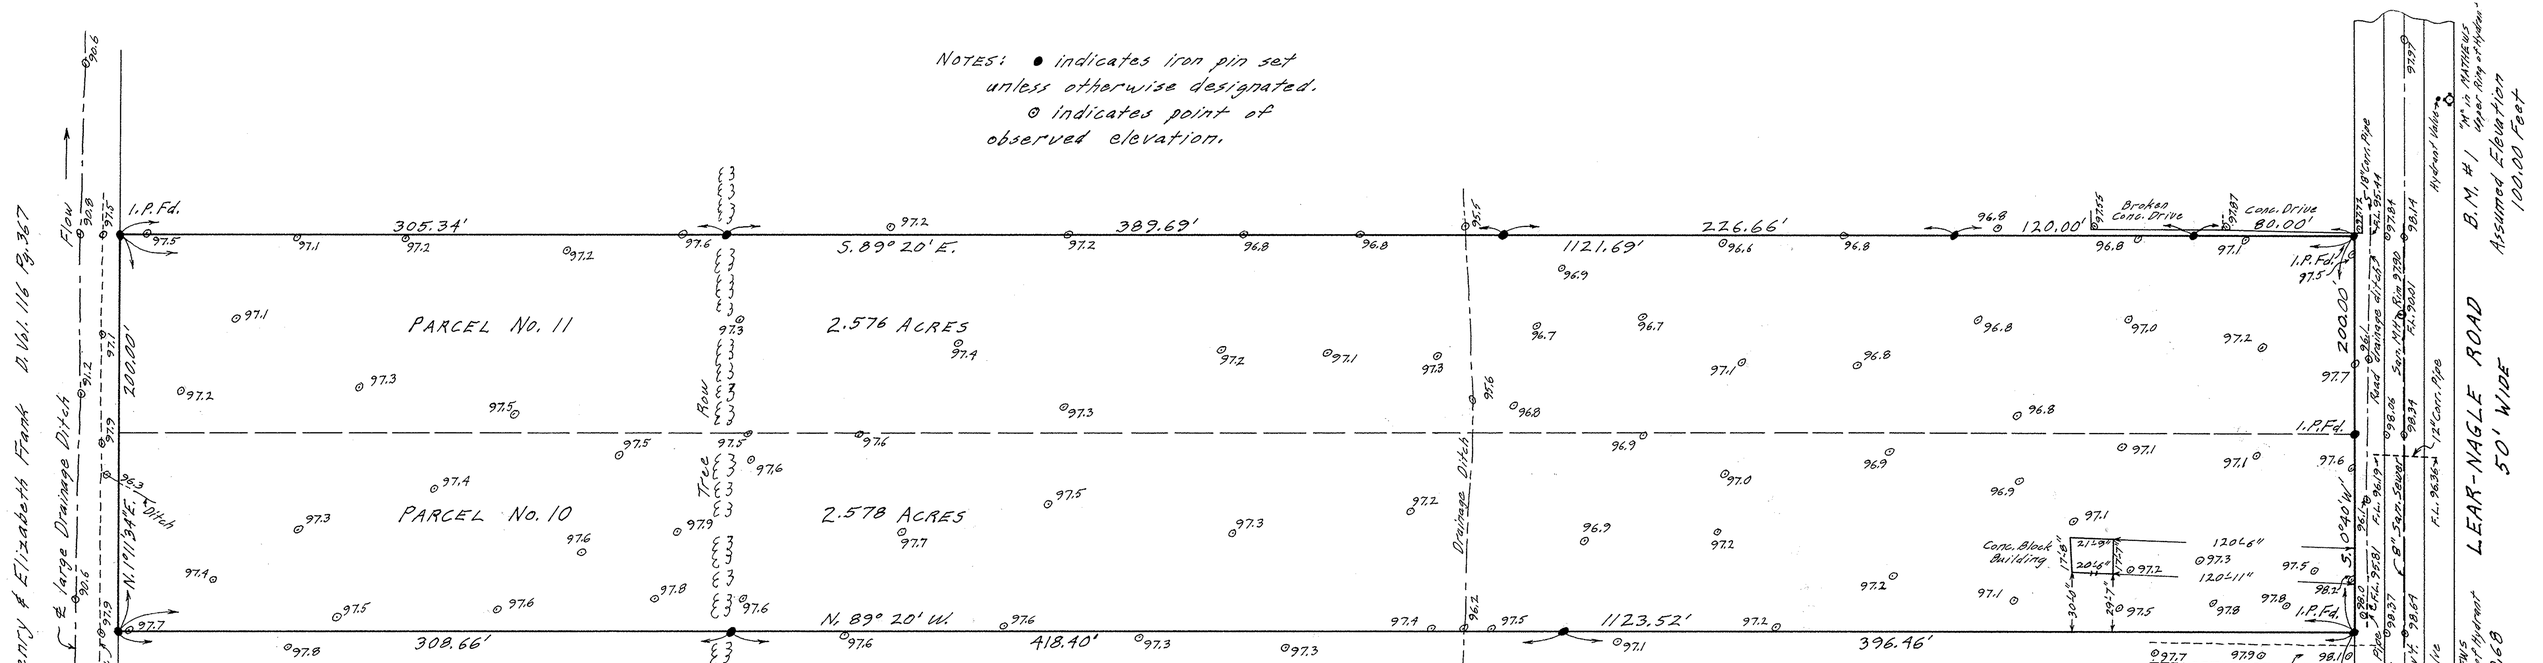

PROPERTY LINE AND TOPOGRAPHIC SURVEY FOR
THE BETHEL BAPTIST CHURCH
ORIGINAL LOTS 7 & 18 RIDGEVILLE TOWNSHIP
NORTH RIDGEVILLE CITY
LORAIN COUNTY OHIO
SCALE: 1" = 40' JULY 1969
Gary E. Penfound Reg. Surveyor No. 4457

(Property known as PARCELS Nos. 10 & 11 Of THE SOUTH HILLS LAND COMPANY'S RIDGEVILLE NAGLE FARMS ALLOTMENT.)

07-00-007, 018